MAP FILE M.36 # 34

COUNTY SURVEYORS FILE DATA
DO NOT REMOVE FROM OFFICE

SURVEY IN SECT. 1, TWP. 25 SOUTH, RNG. 6 WEST, W.M.

Surveyed for Mrs. Paul Thiringer
Surveyed by Don E. Garrett
September 1968

Scale 1" = 200'

Bearings are based on a solar observation taken August 8, 1968.
o – Set 5/8" Iron Rod.

FILED
RECEIVED
SEP 10 1968
COUNTY SURVEYOR
DOUGLAS COUNTY, ORE.

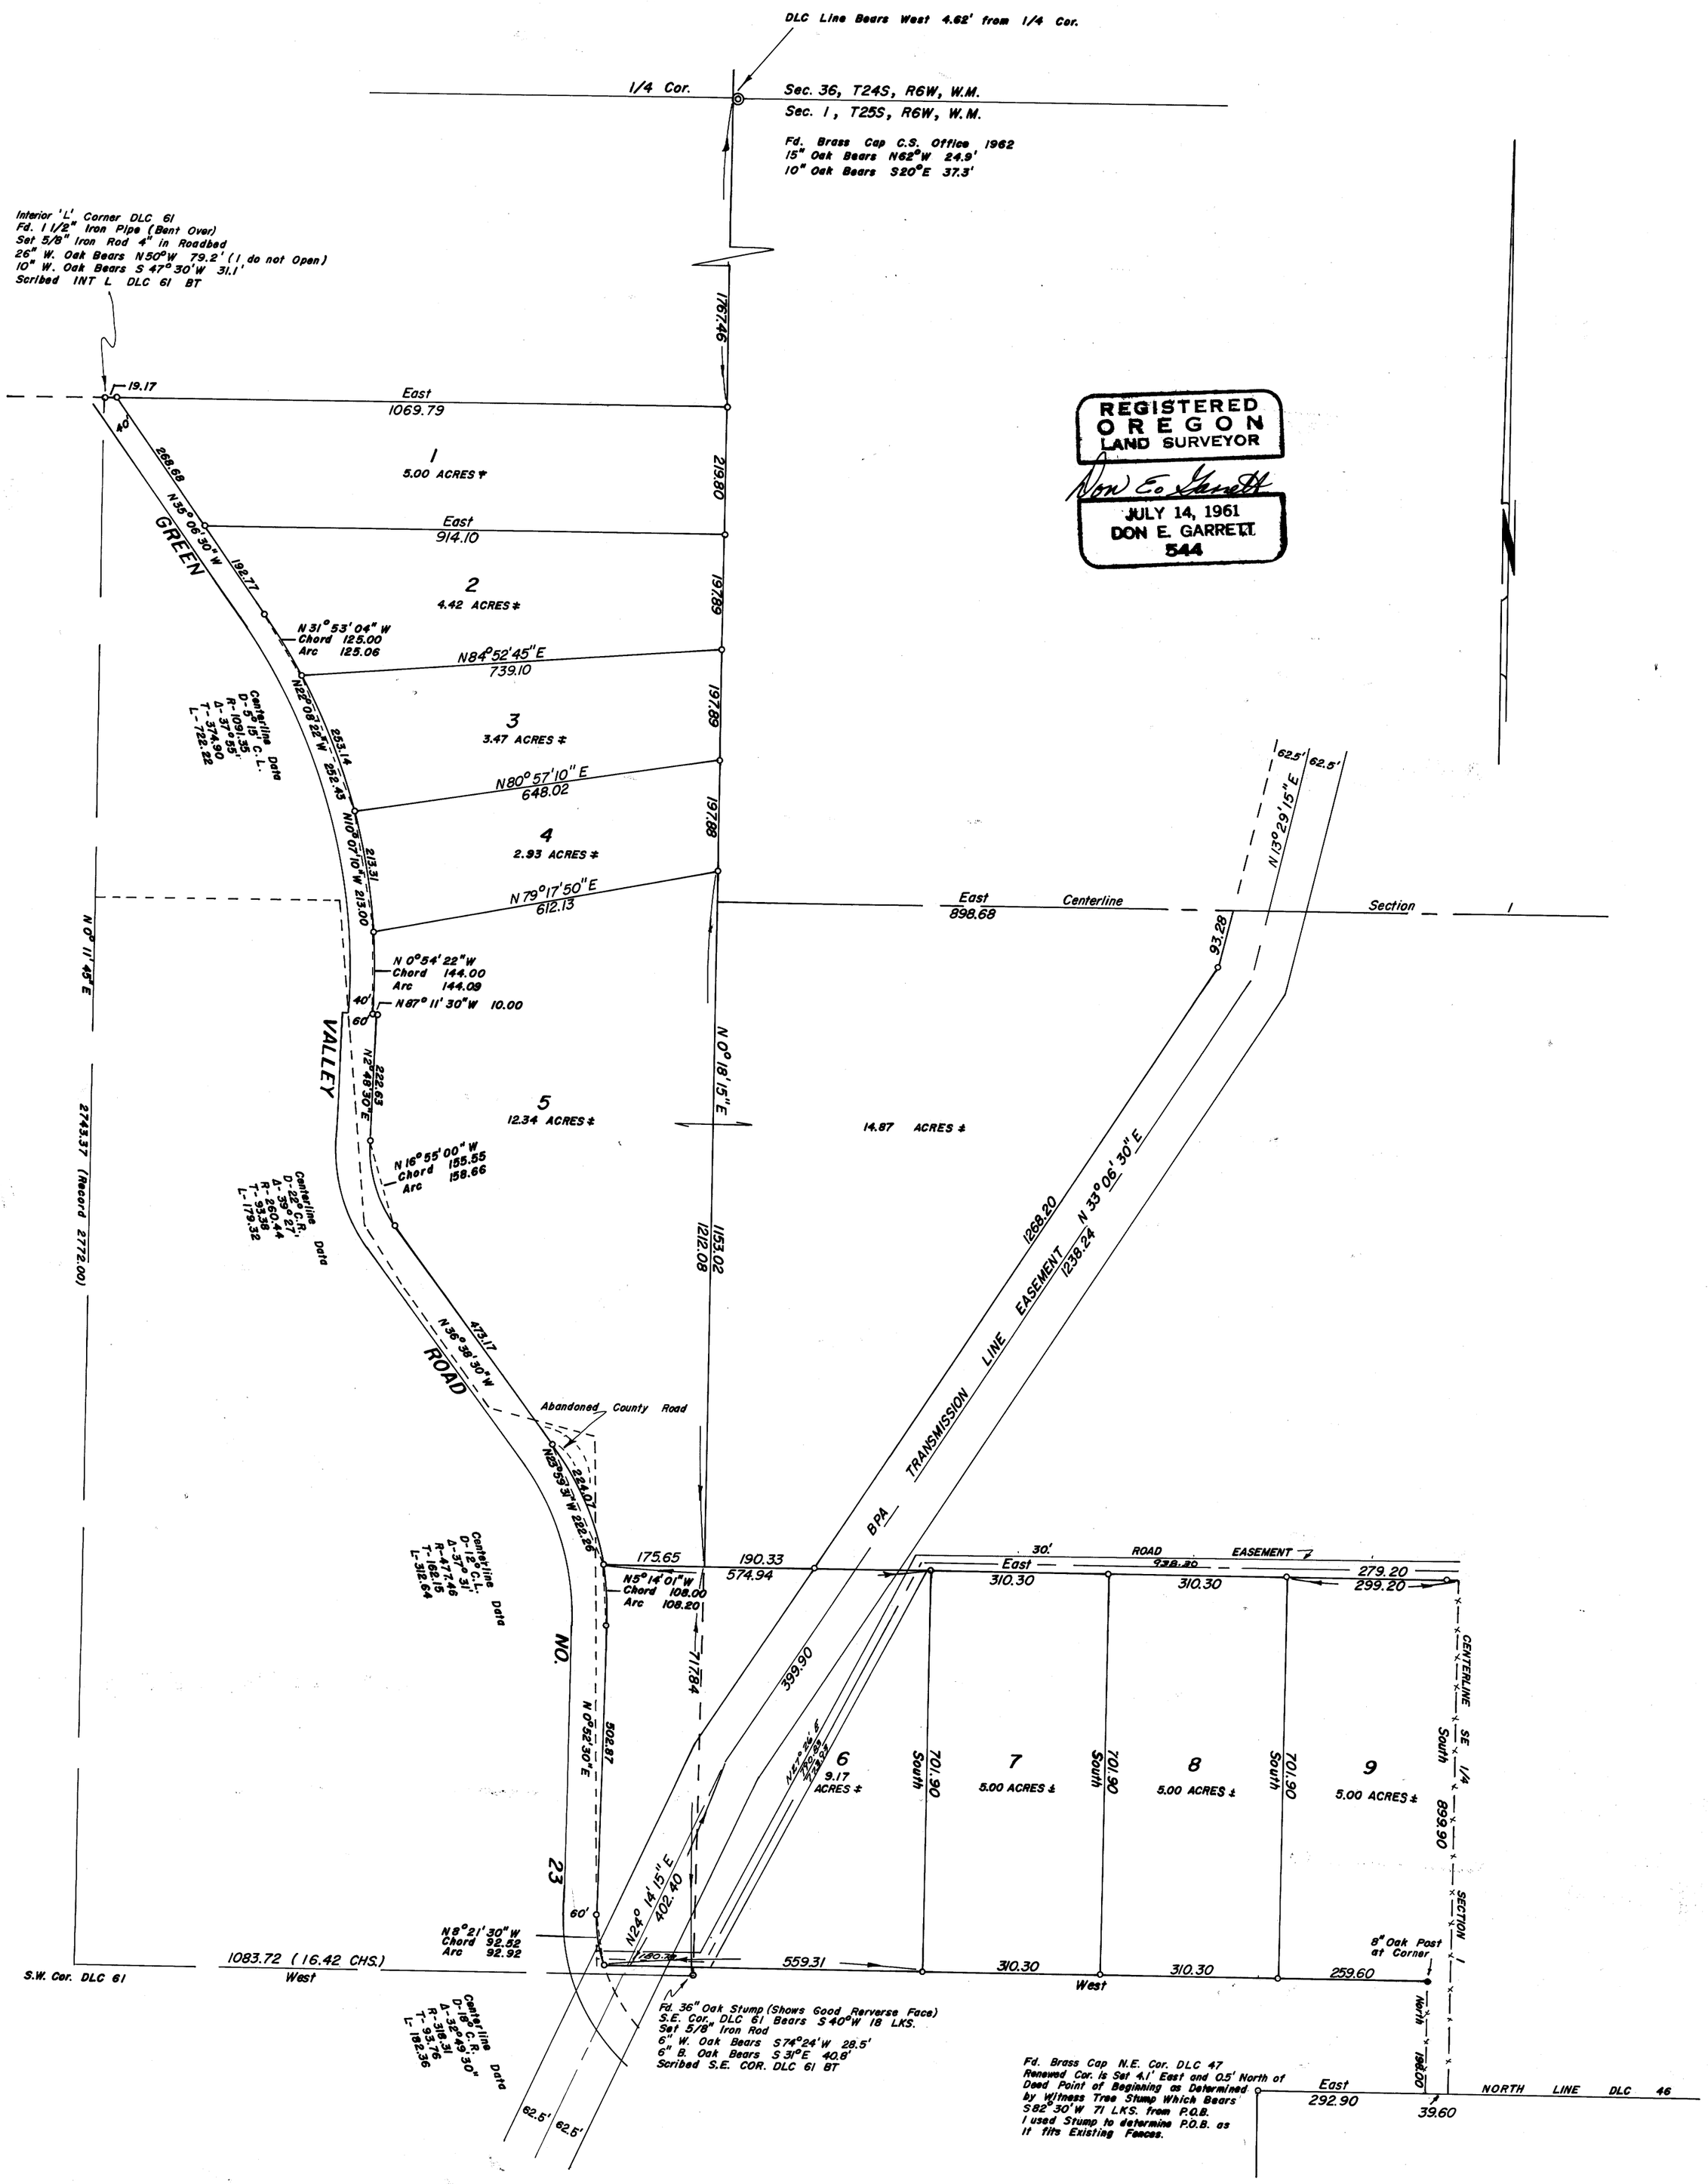

REGISTERED
OREGON
LAND SURVEYOR
Don E. Garrett
JULY 14, 1961
DON E. GARRETT
544

MAP FILE M.36 # 34