MAP FILE M36 P40

COUNTY SURVEYORS FILE DATA
DO NOT REMOVE FROM OFFICE

FILED
RECEIVED
SEP 23 1968
COUNTY SURVEYOR
DOUGLAS COUNTY, ORE.

SURVEY IN SECTIONS 27,33 & 34, TWP 23 SOUTH, RNG 5 WEST, W.M.
Surveyed for Bill Stedman by Don E. Garrett
September 1968 Scale 1" = 100'

o- Set 5/8" Iron Rod
Bearings are based on a solar observation taken September 11, 1968.

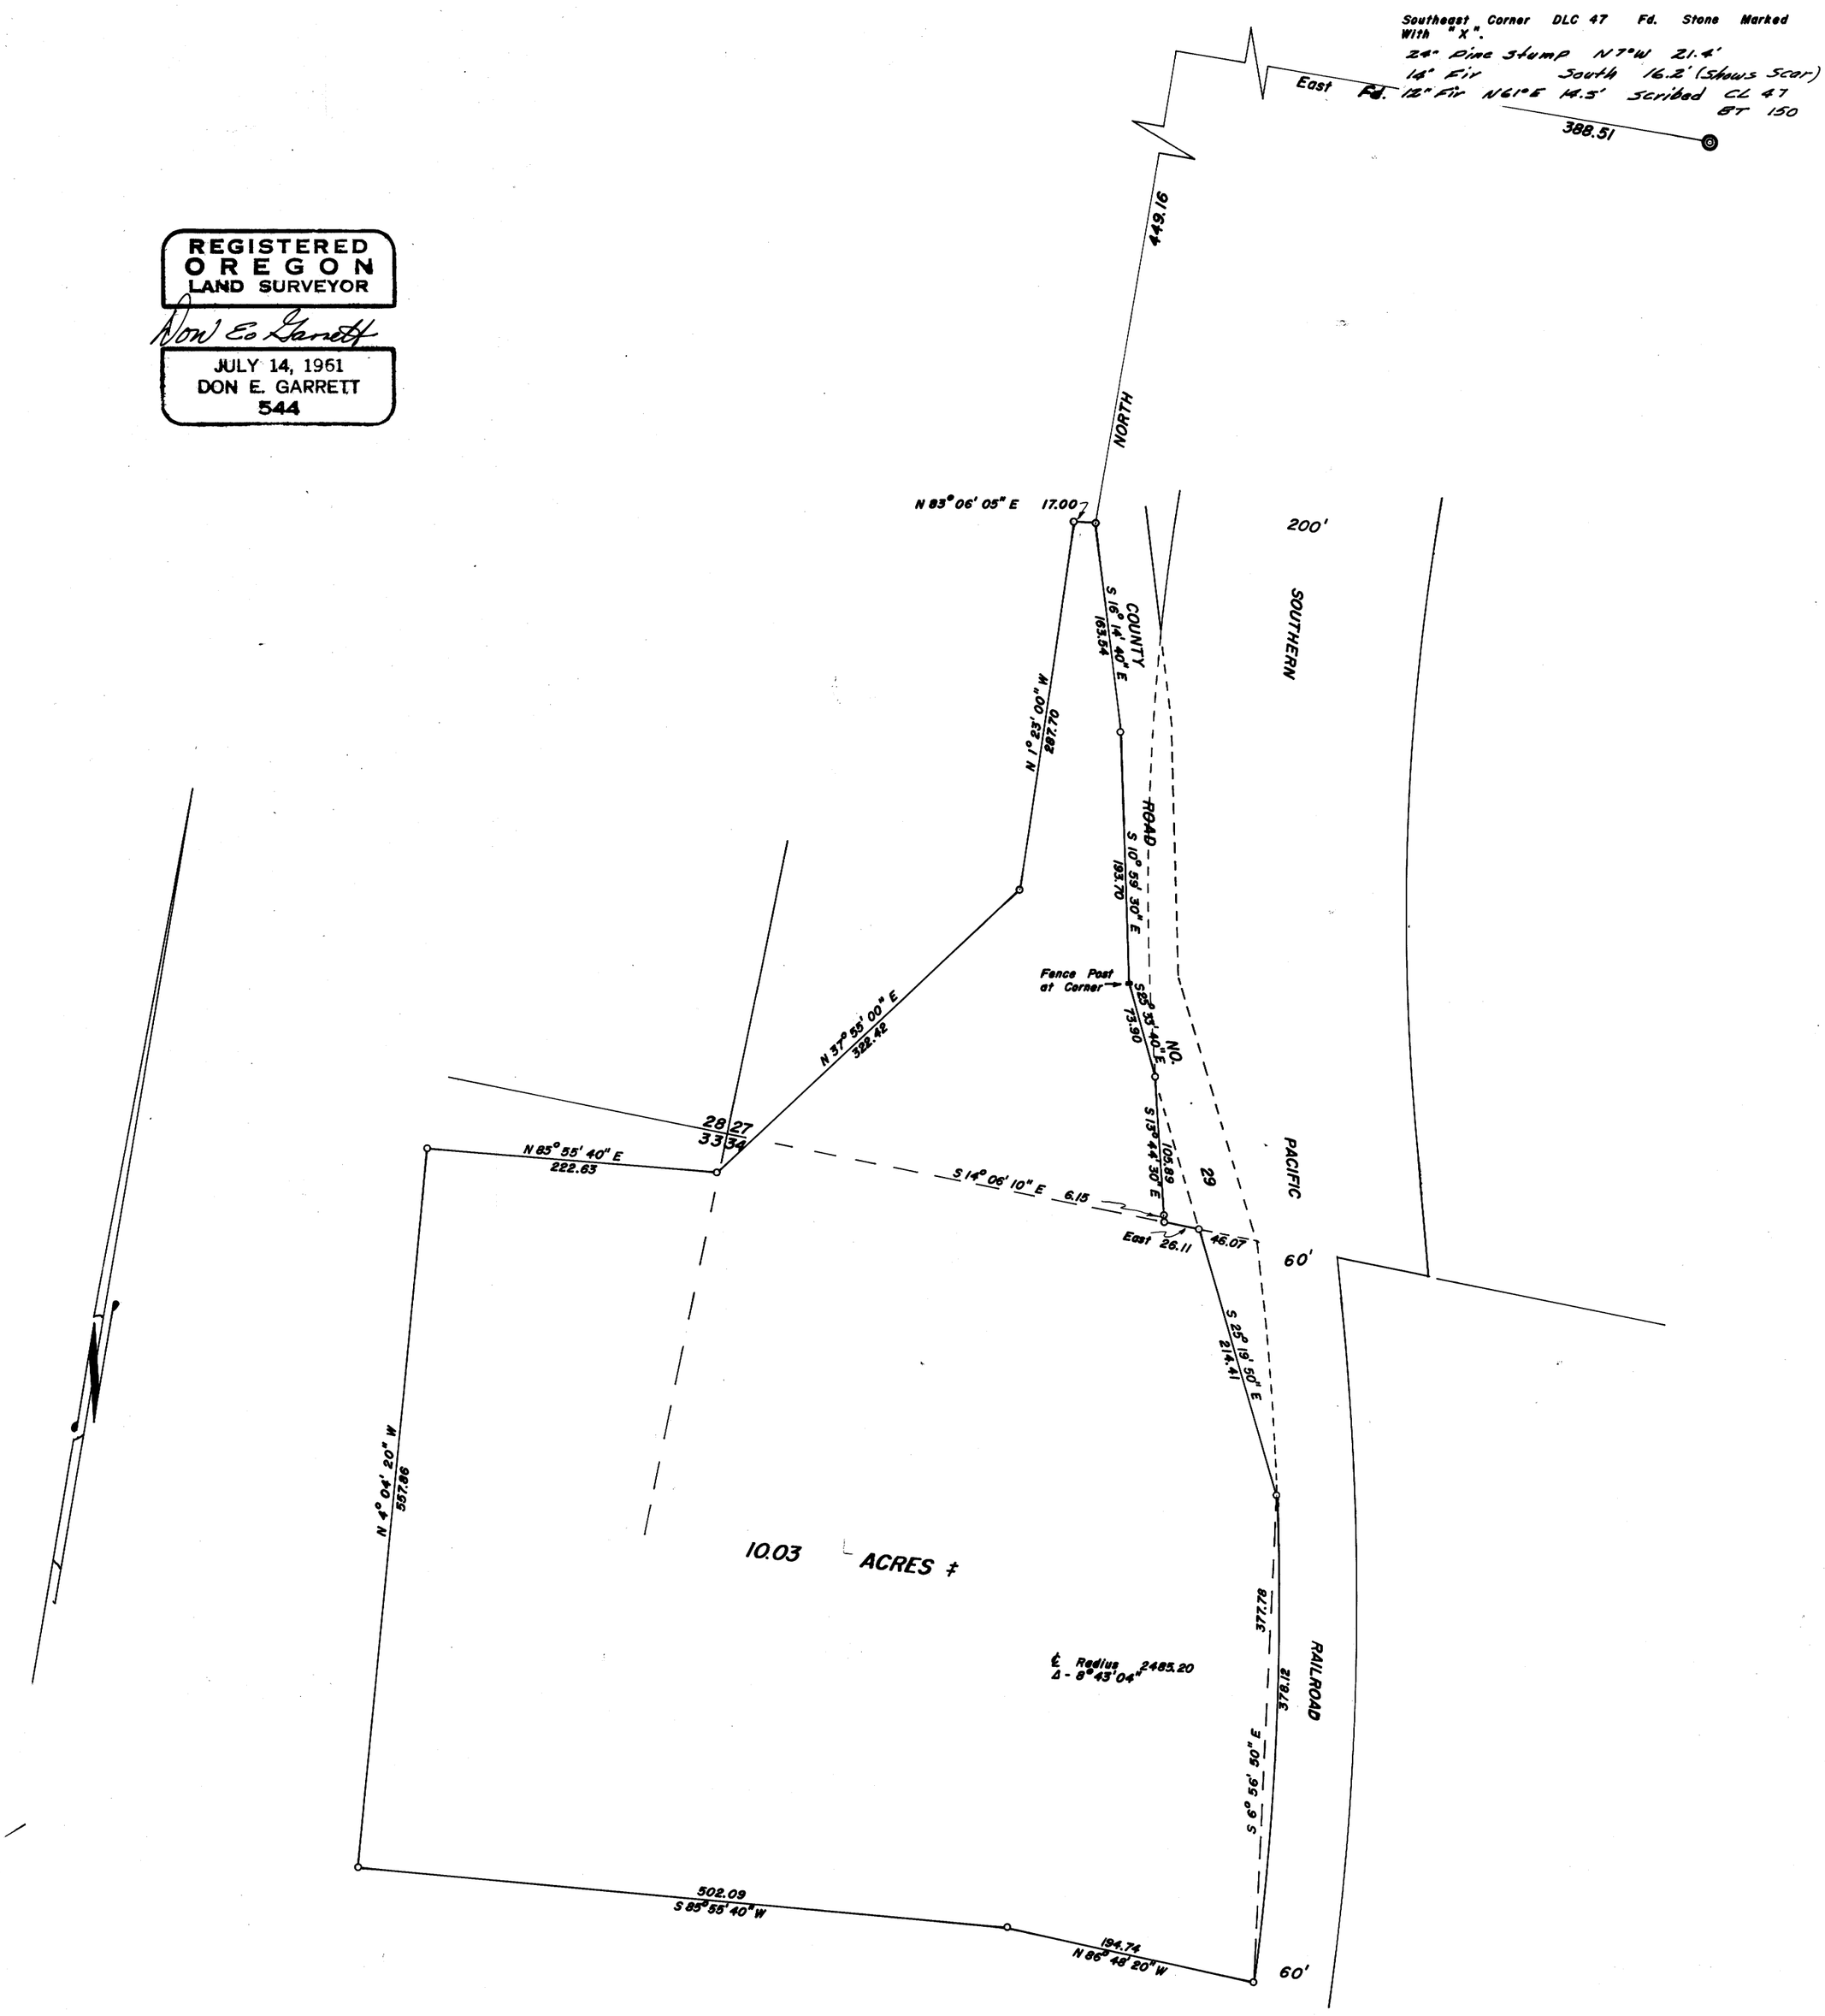

REGISTERED
OREGON
LAND SURVEYOR
Don E. Garrett
JULY 14, 1961
DON E. GARRETT
544

MAP FILE M 36 P 40