MAP FILE M 36 7 41

FILED
RECEIVED
SEP 24 1968
COUNTY SURVEYOR
DOUGLAS COUNTY, ORE.

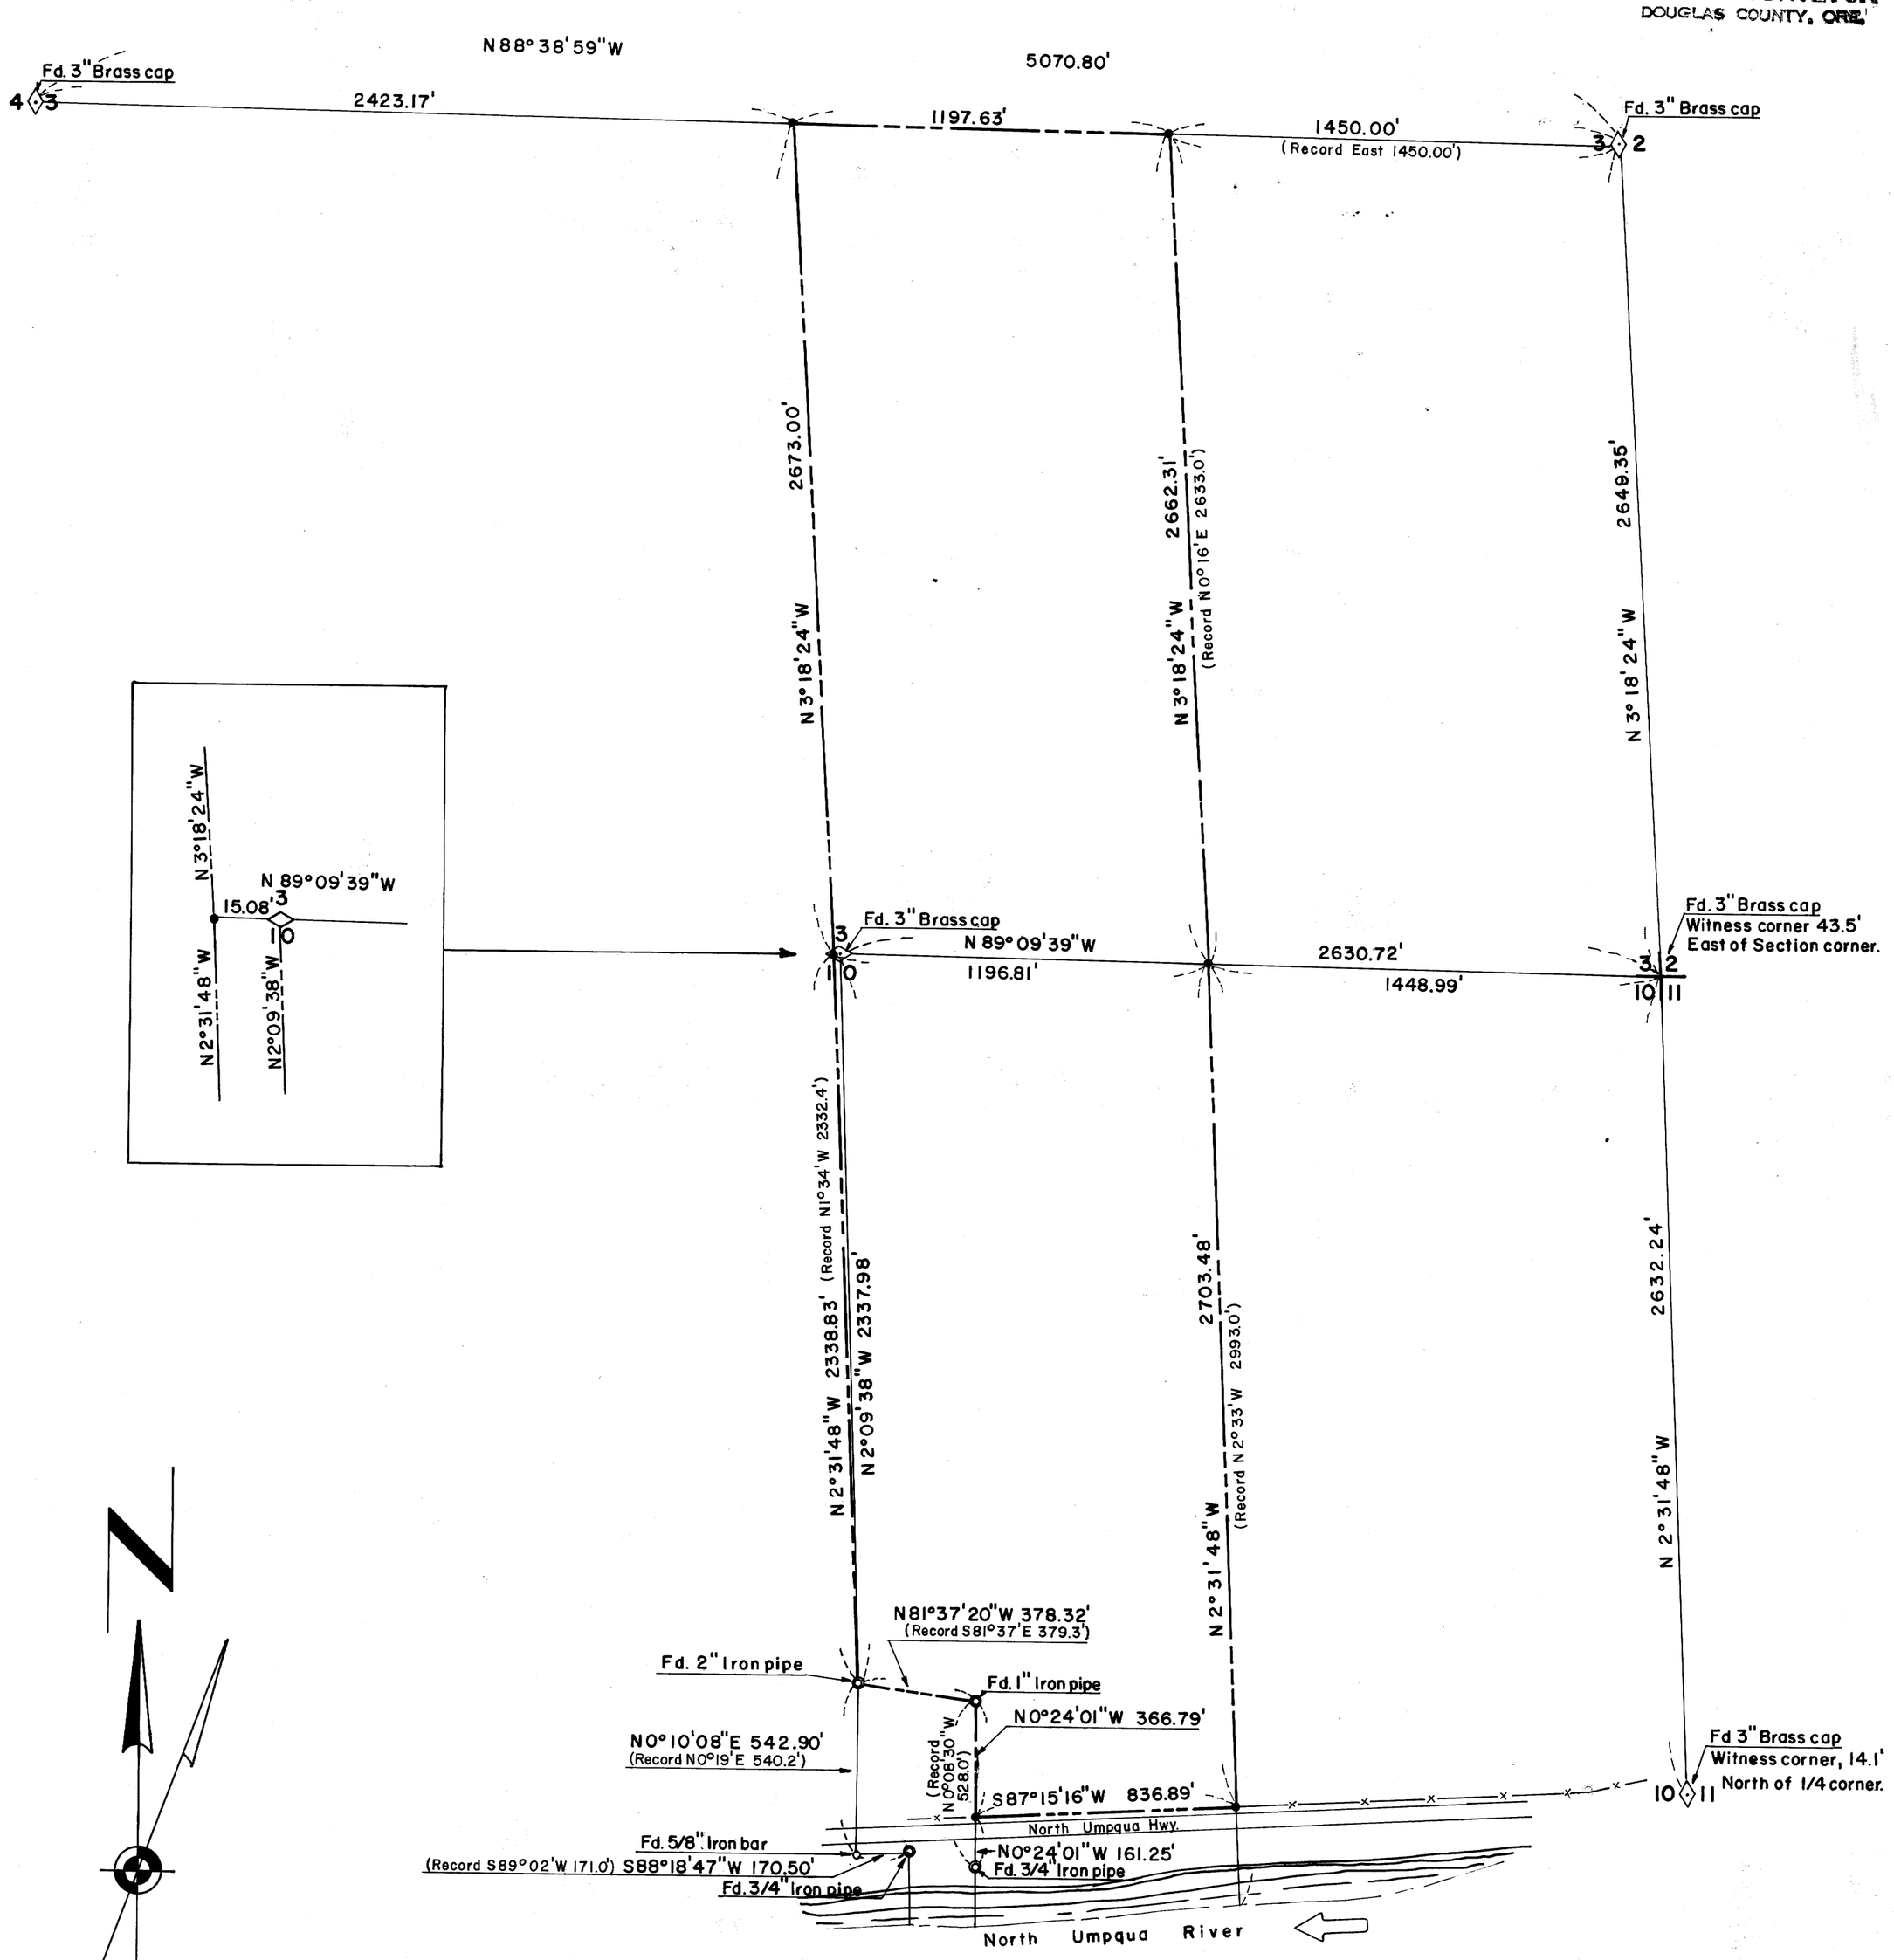

Scale: 1" = 400'

Bearings based on Solar Observations.
Records shown based on Douglas County Deed Records, Vol. 93, Page 188.

● = 5/8" Iron bar set.

REVISED APRIL 1970
SEE M 36-41A

Survey for Ralph DeMoisy
Located in Sections 3 & 10, T26S, R3W, W.M.
Douglas County, Oregon

by SEEK, INC.
Sept., 1968

REGISTERED
OREGON
LAND SURVEYOR
William C. Stiles
OCT. 4, 1957
WILLIAM C. STILES
432

COUNTY SURVEYORS FILE DATA
DO NOT REMOVE FROM OFFICE

MAP FILE M 36 7 41