COUNTY SURVEYORS FILE DATA
DO NOT REMOVE FROM OFFICE

RECEIVED
OCT 3 1968
COUNTY SURVEYOR
DOUGLAS COUNTY, OREGON

MAP FILE M-36 P-46

SURVEY FOR DEED DESCRIPTIONS
IN SEC. 24, T.26S., R.7W.W.M.
SURVEYED FOR BLACK & TIPTON REAL EST.
by BRUCE R. ROGERS
SEPT. 1968
1" = 200'

o - Fd. Monument
o - Set 5/8" I.R.

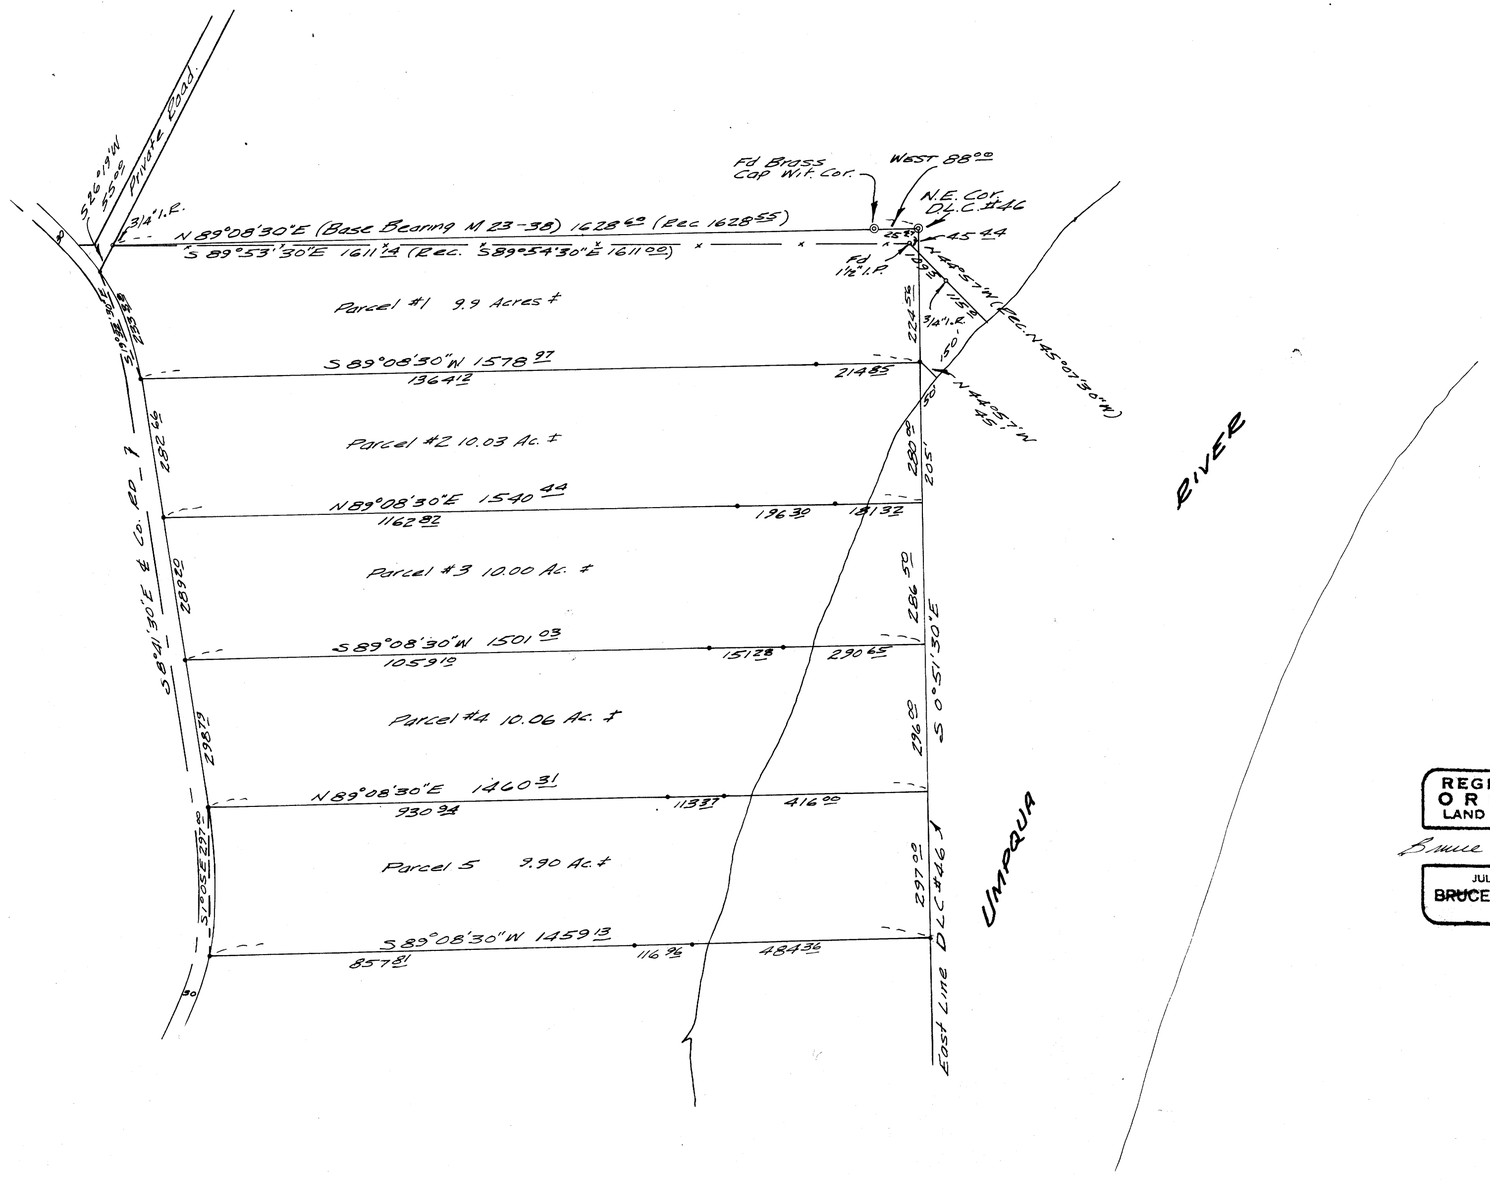

REGISTERED
OREGON
LAND SURVEYOR

Bruce R. Rogers

JULY 10, 1964
BRUCE R. ROGERS
660

MAP FILE M-36 P-46