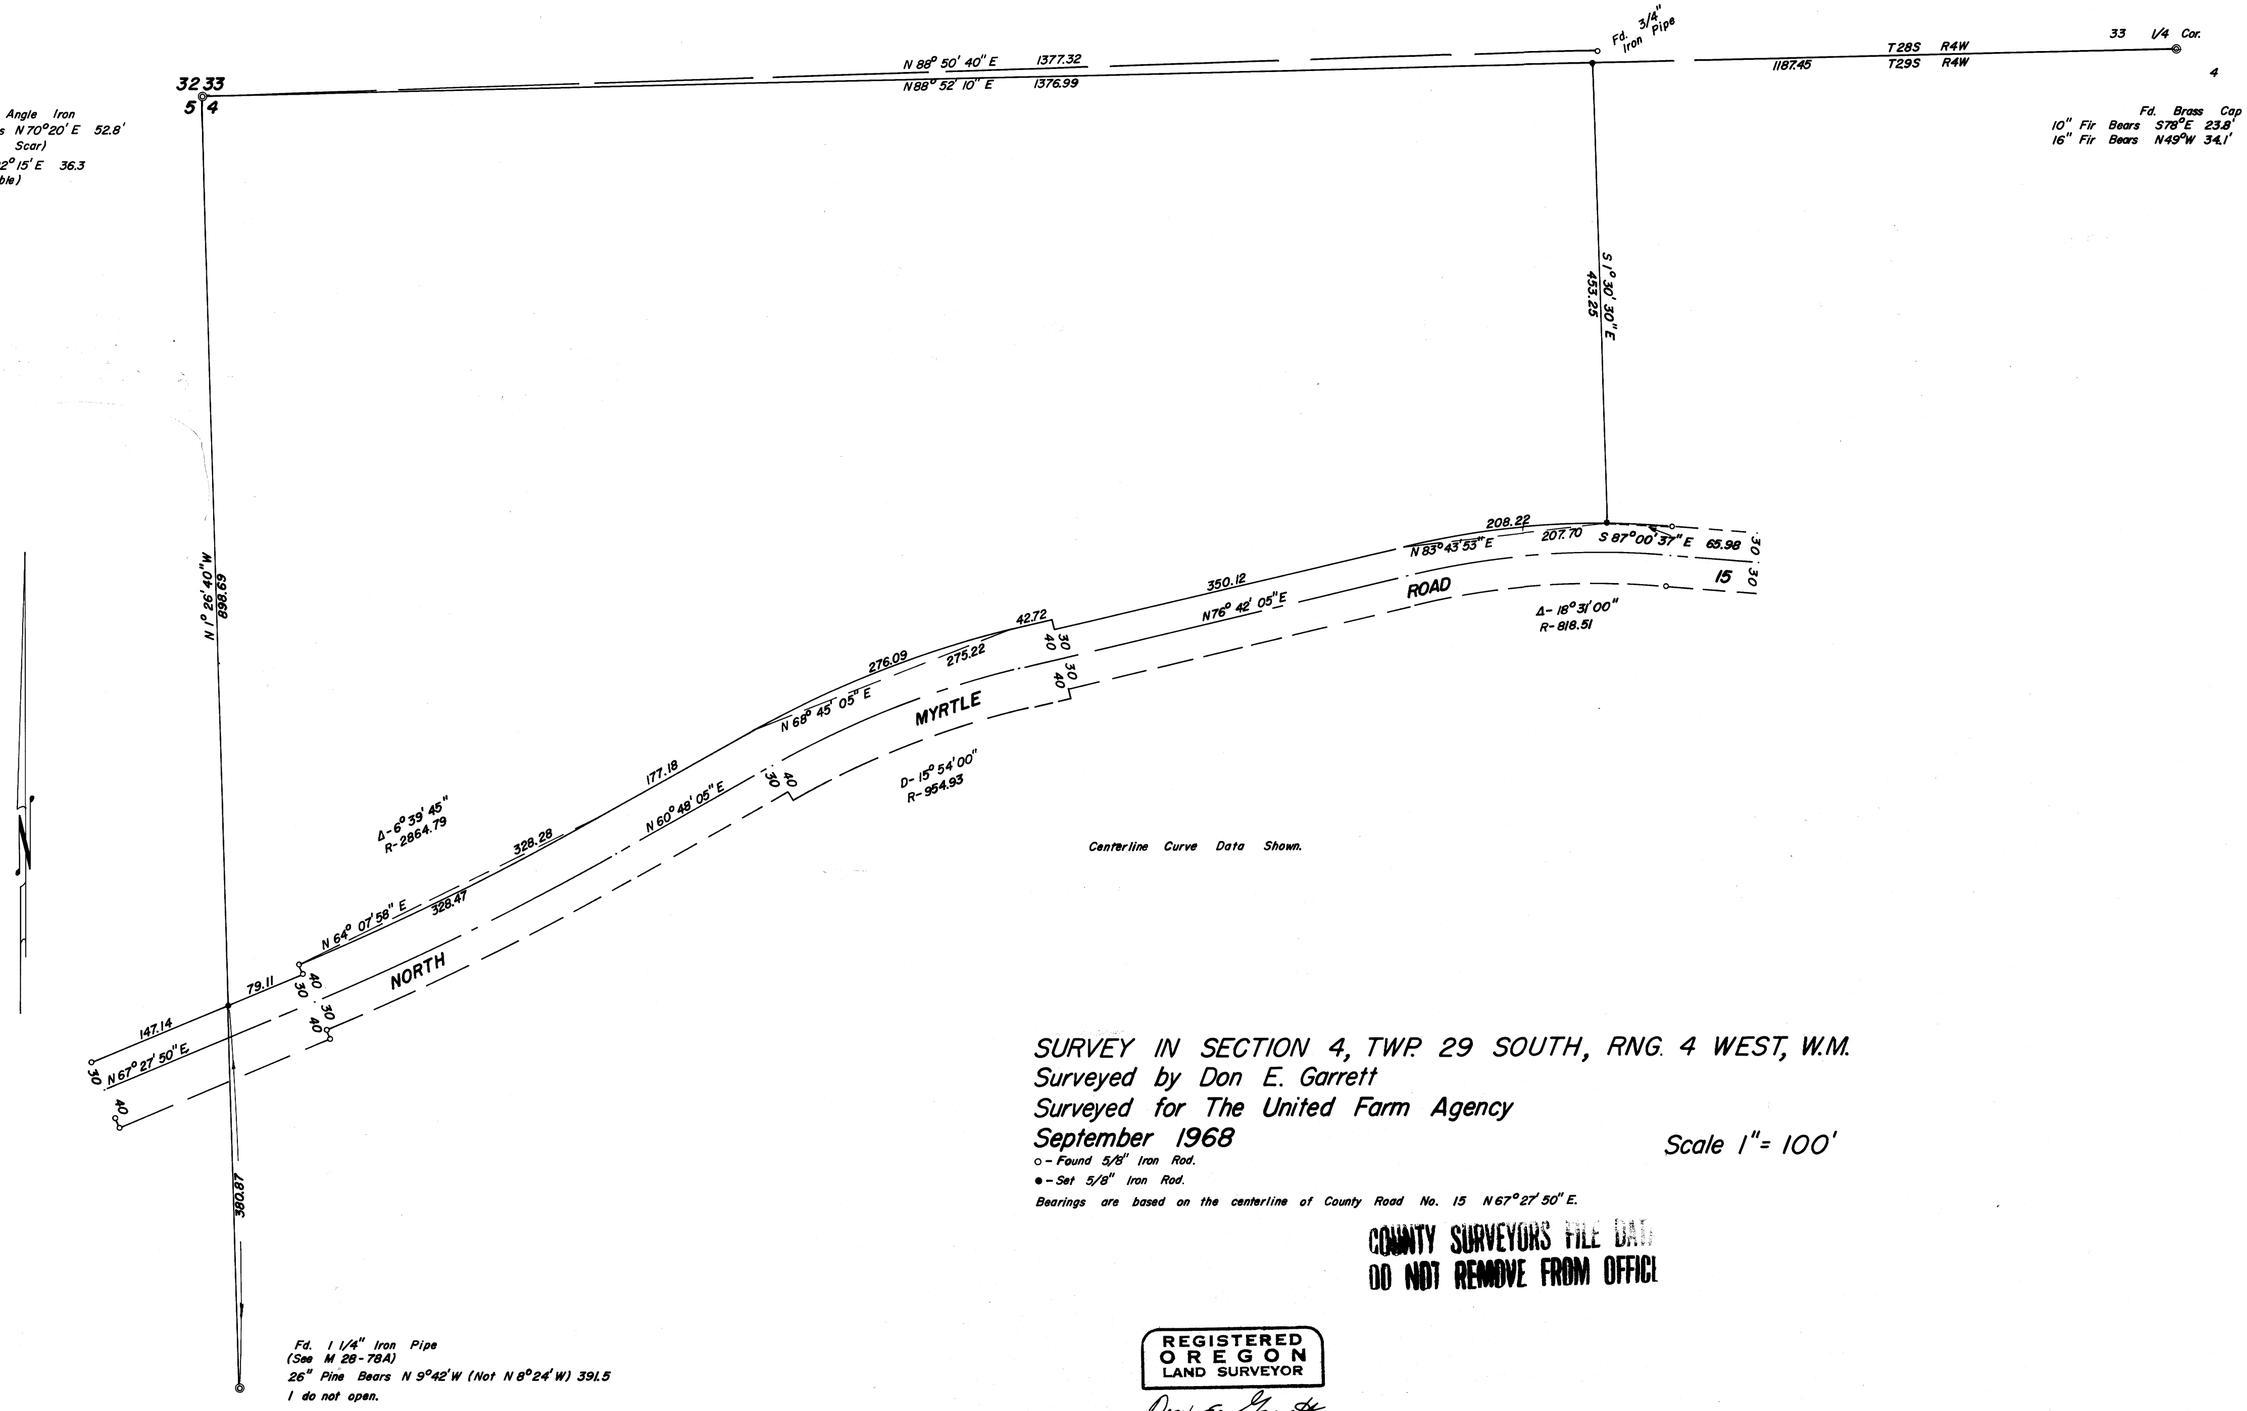

SURVEY IN SECTION 4, TWP. 29 SOUTH, RNG. 4 WEST, W.M.
Surveyed by Don E. Garrett
Surveyed for The United Farm Agency
September 1968

Scale 1" = 100'

○ - Found 5/8" Iron Rod.
● - Set 5/8" Iron Rod.

Bearings are based on the centerline of County Road No. 15 N 67°27' 50" E.

COUNTY SURVEYORS FILE DATA
DO NOT REMOVE FROM OFFICE

REGISTERED
OREGON
LAND SURVEYOR

Don E. Garrett

JULY 14, 1961
DON E. GARRETT
544

MAP FILE M 36 I 50

MAP FILE M 36 I 50

OCT 10 1961
COUNTY SURVEYOR