MAP FILE M 36 # 55

COUNTY SURVEYORS FILE DATA
DO NOT REMOVE FROM OFFICE

SURVEY FOR DEED DESCRIPTION IN SECTION 18, T. 25 S., R. 5 W. W.M., DOUGLAS COUNTY, ORE.

SURVEYED FOR – R.W. FOSTER
SURVEYED BY – W.S. BARNES

SEPT. 1968
SCALE 1" = 60'

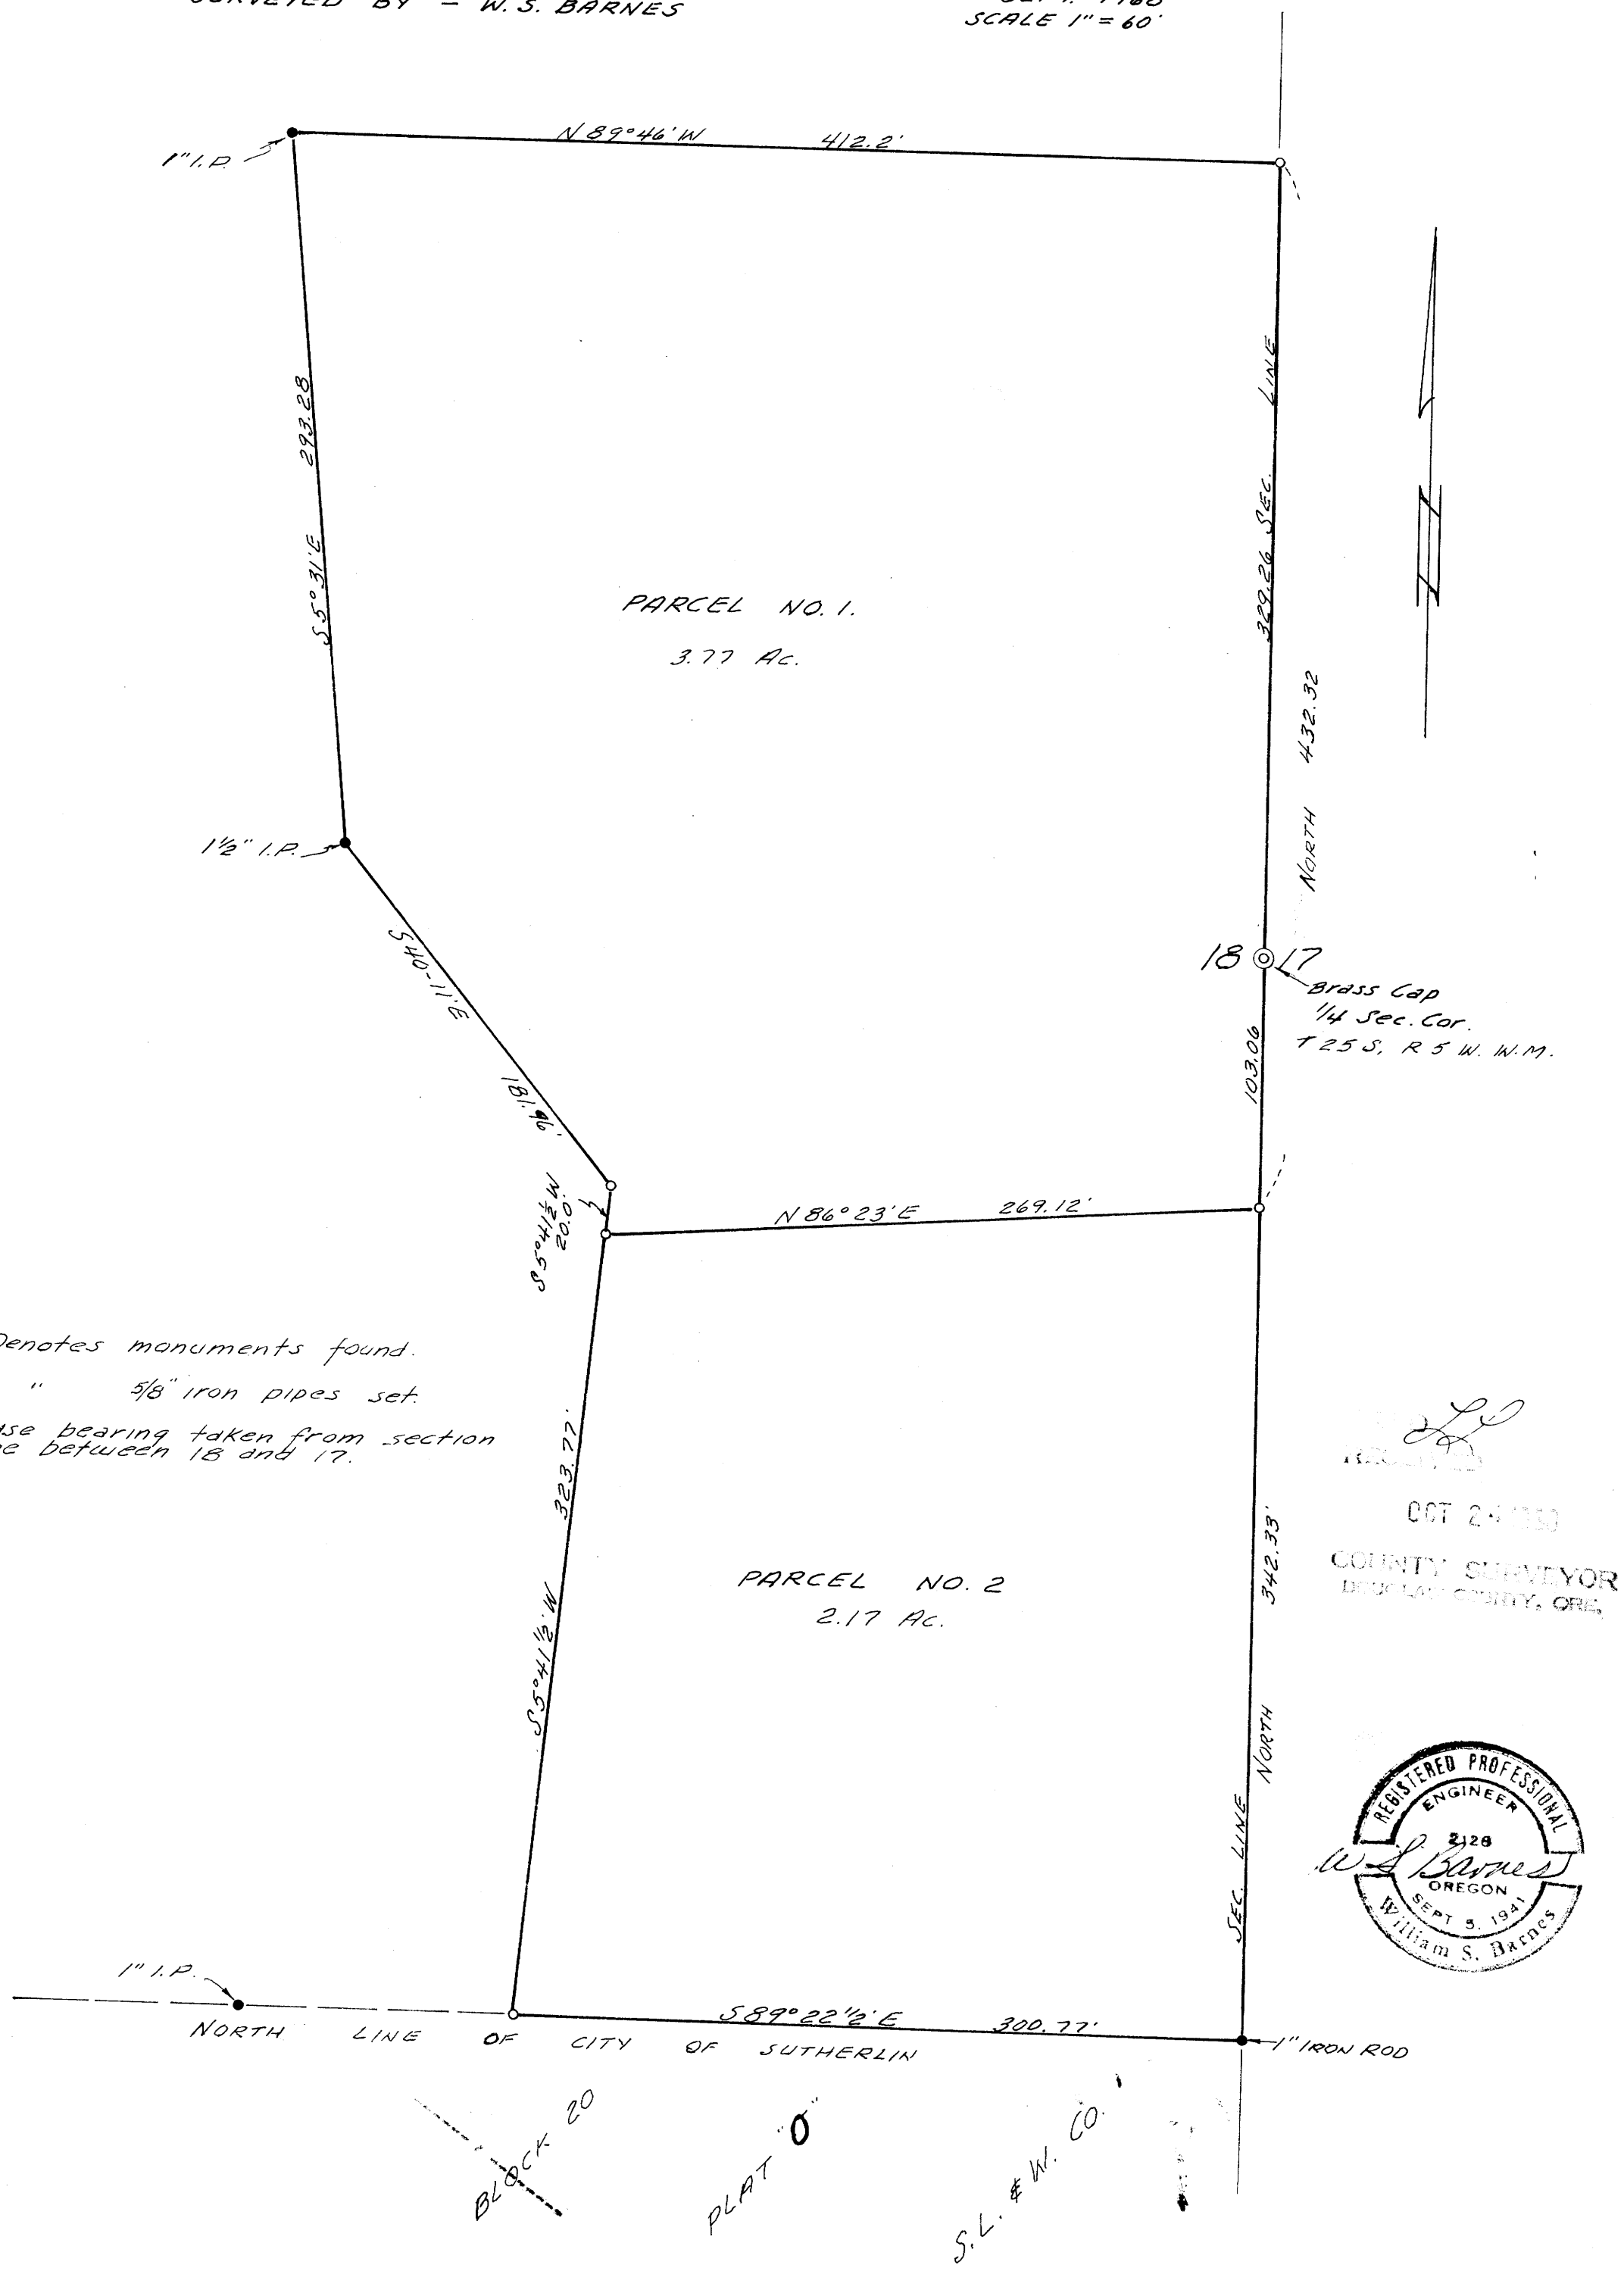

RECEIVED
OCT 2 1968
COUNTY SURVEYOR
DOUGLAS COUNTY, ORE.

REGISTERED PROFESSIONAL ENGINEER
2128
W. S. Barnes
OREGON
SEPT 5, 1941
William S. Barnes

MAP FILE M 36 # 55