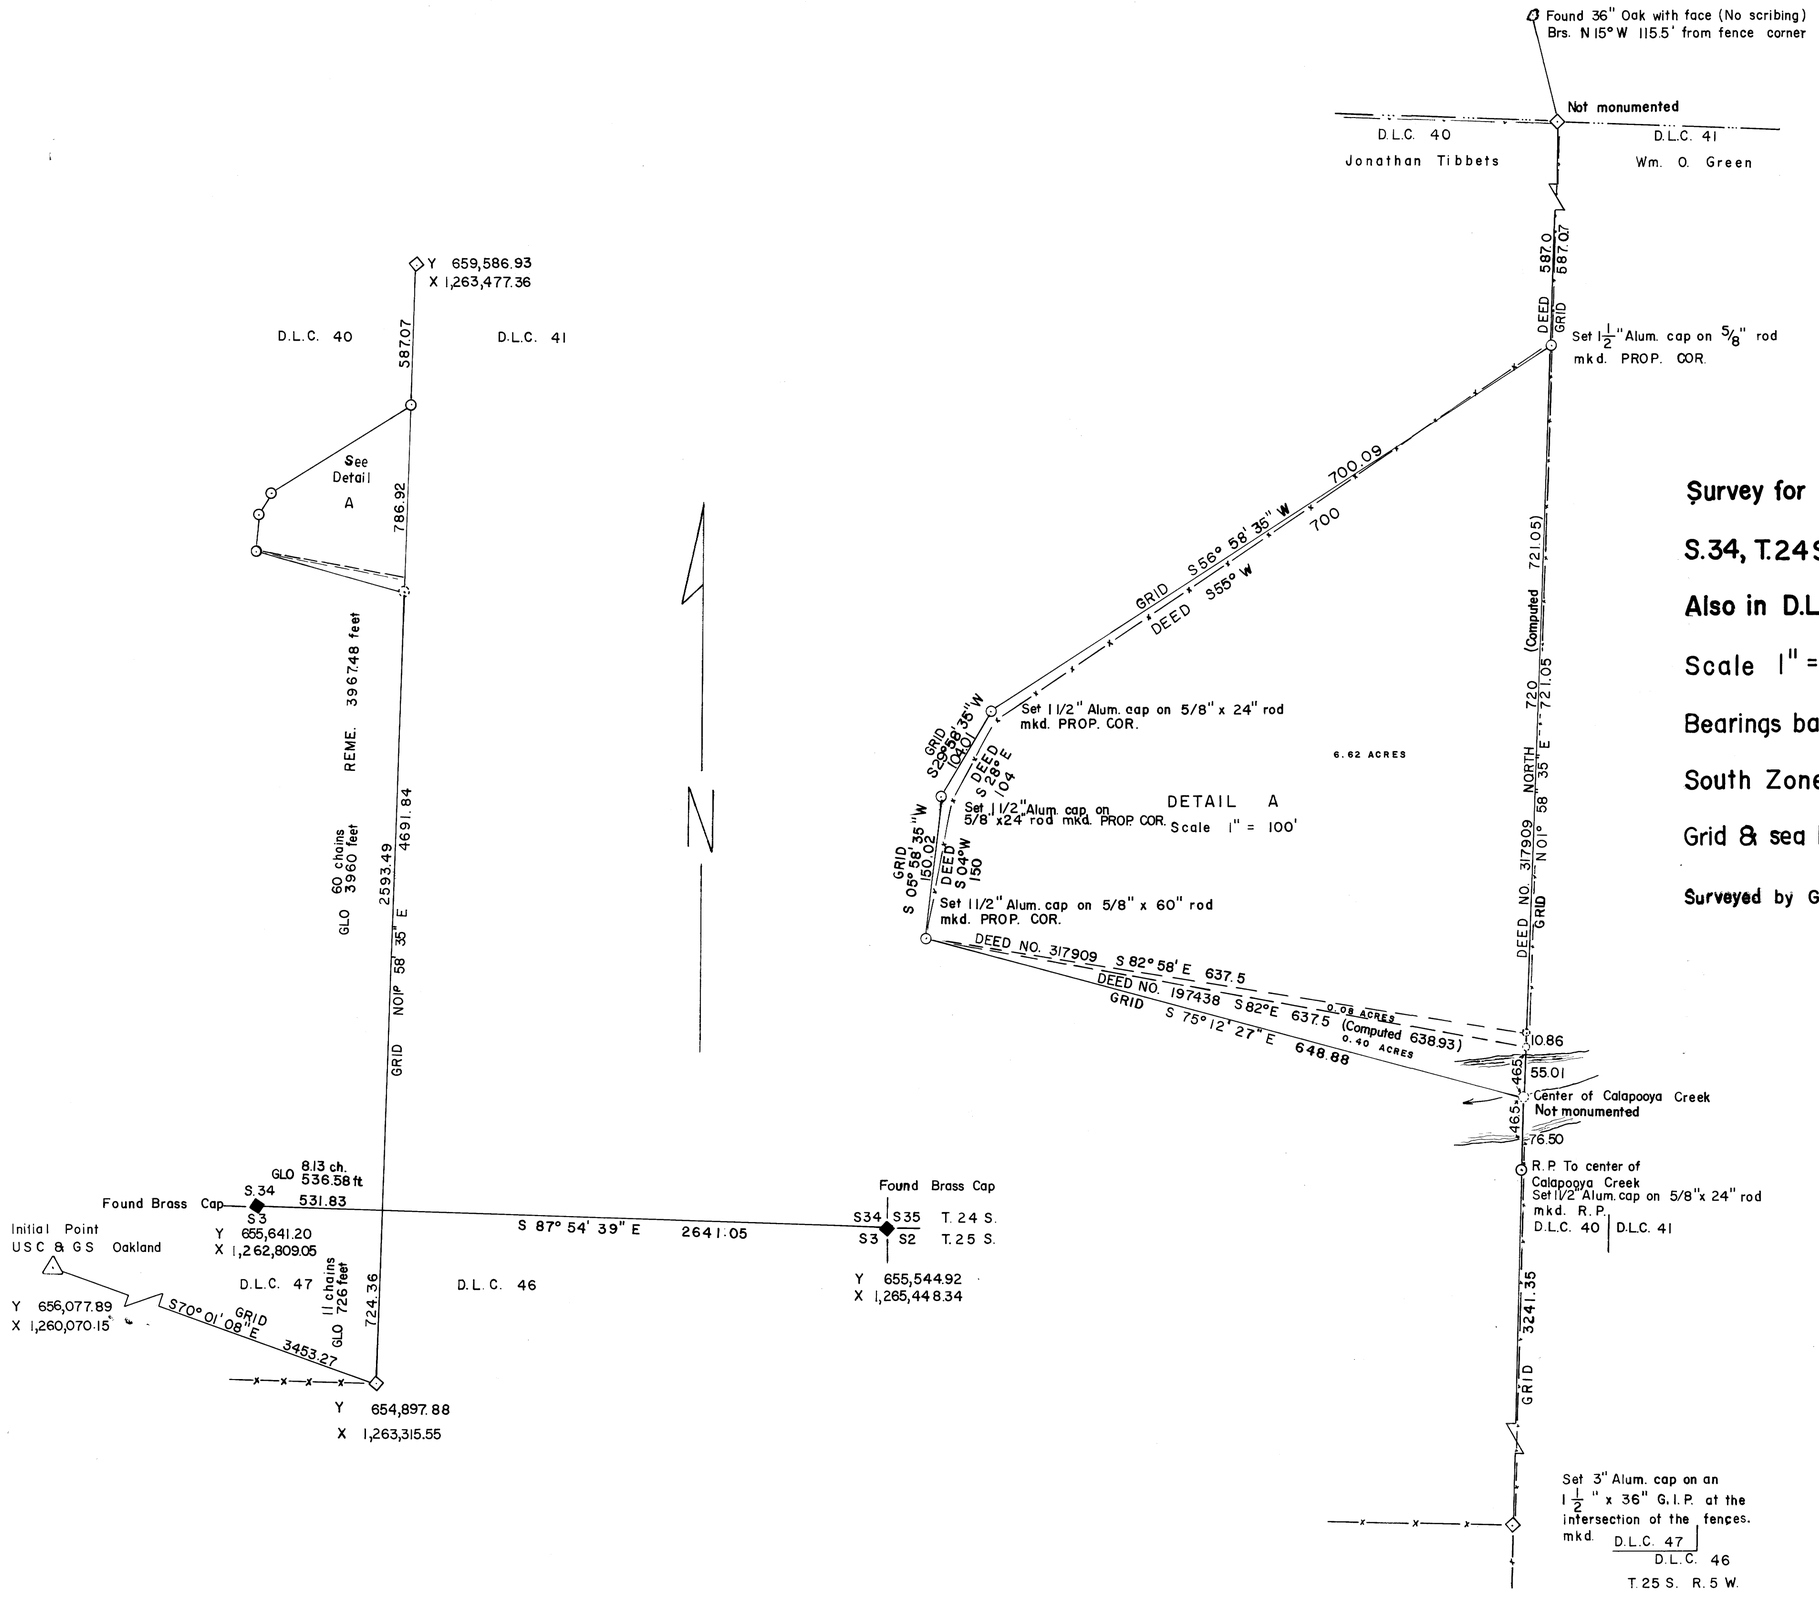

Survey for R. Hakanson, E. Sultan, & D. Knight

S.34, T.24S., & S.3, T. 25S., R.5 W., W. M.

Also in D.L.C.'S 40, 41, 46, & 47, Douglas Co. Oreg.

Scale 1" = 100' & 1" = 400' October 28, 1968

Bearings based on Oregon Coordinate System,

South Zone, Bearings & distances are grid.

Grid & sea level factor 0.999874 θ = −1° 54' 15"

Surveyed by Green Empire, Inc., Oakridge, Oregon

REGISTERED
OREGON
LAND SURVEYOR
Malcolm N. Clark
JULY 12, 1963
MALCOLM N. CLARK
601

COUNTY SURVEYORS FILE
DO NOT REMOVE FROM OFFICE

M 36-61

M 36-61