COUNTY SURVEYORS FILE DA
DO NOT REMOVE FROM OFFIC

SURVEY TO SET PROPERTY CORNERS
LOTS 10, BLK. 2, & LOT 14, BLK 3, PLAT "N"
SUTHERLIN LAND & WATER CO.
SURVEYED FOR DON KNIGHT REALTY
by BRUCE R. ROGERS
NOV. 14, 1968
1" = 300'

NOTE:
Mr. Andy Hempenius who built the fence down the ℄ of vacated Sutherlin Ave. told me that he found all the old lot corners (Iron pipes) and set a braced post on the east side of each one. These posts check for line & distance.

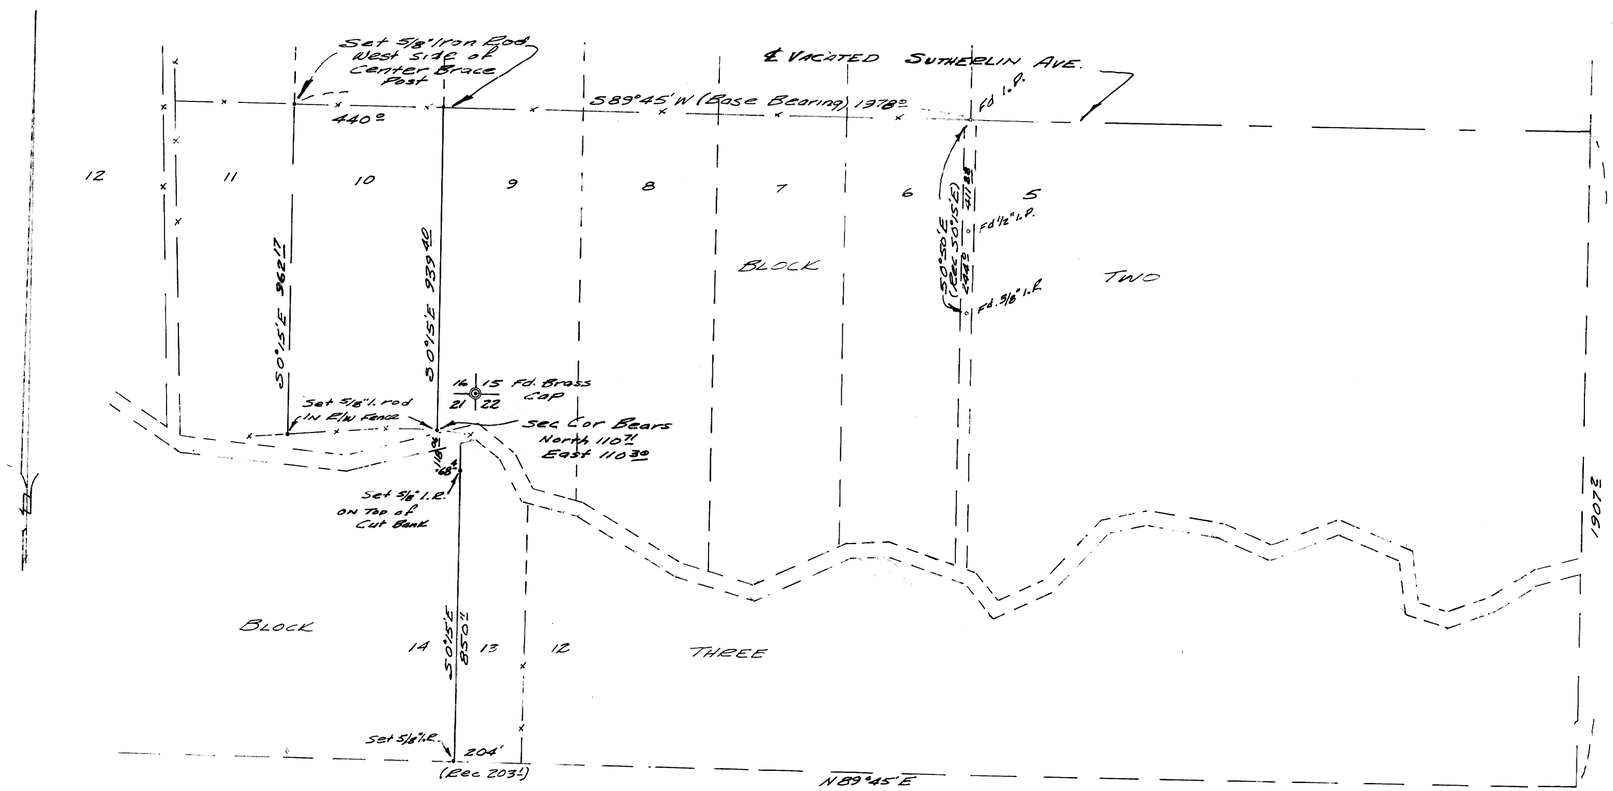

REGISTERED
OREGON
LAND SURVEYOR
Bruce R. Rogers
JULY 15, 1969
BRUCE R. ROGERS
560

MAP FILE M 36 T 63

MAP FILE M 36 - 63