M 36 - 65

COUNTY SURVEYORS FILE DATA
DO NOT REMOVE FROM OFFICE

SURVEY TO ESTABLISH PROPERTY CORNERS IN BLOCK 6, CHADWICK ADDITION ROSEBURG, OREGON.

SURVEYED FOR - MRS. R. KNOTT
ENG'R. - W. S. BARNES

NOV. 1968
SCALE 1" = 50'

FILED
RECEIVED
NOV 22 1968
COUNTY SURVEYOR
DOUGLAS COUNTY, ORE.

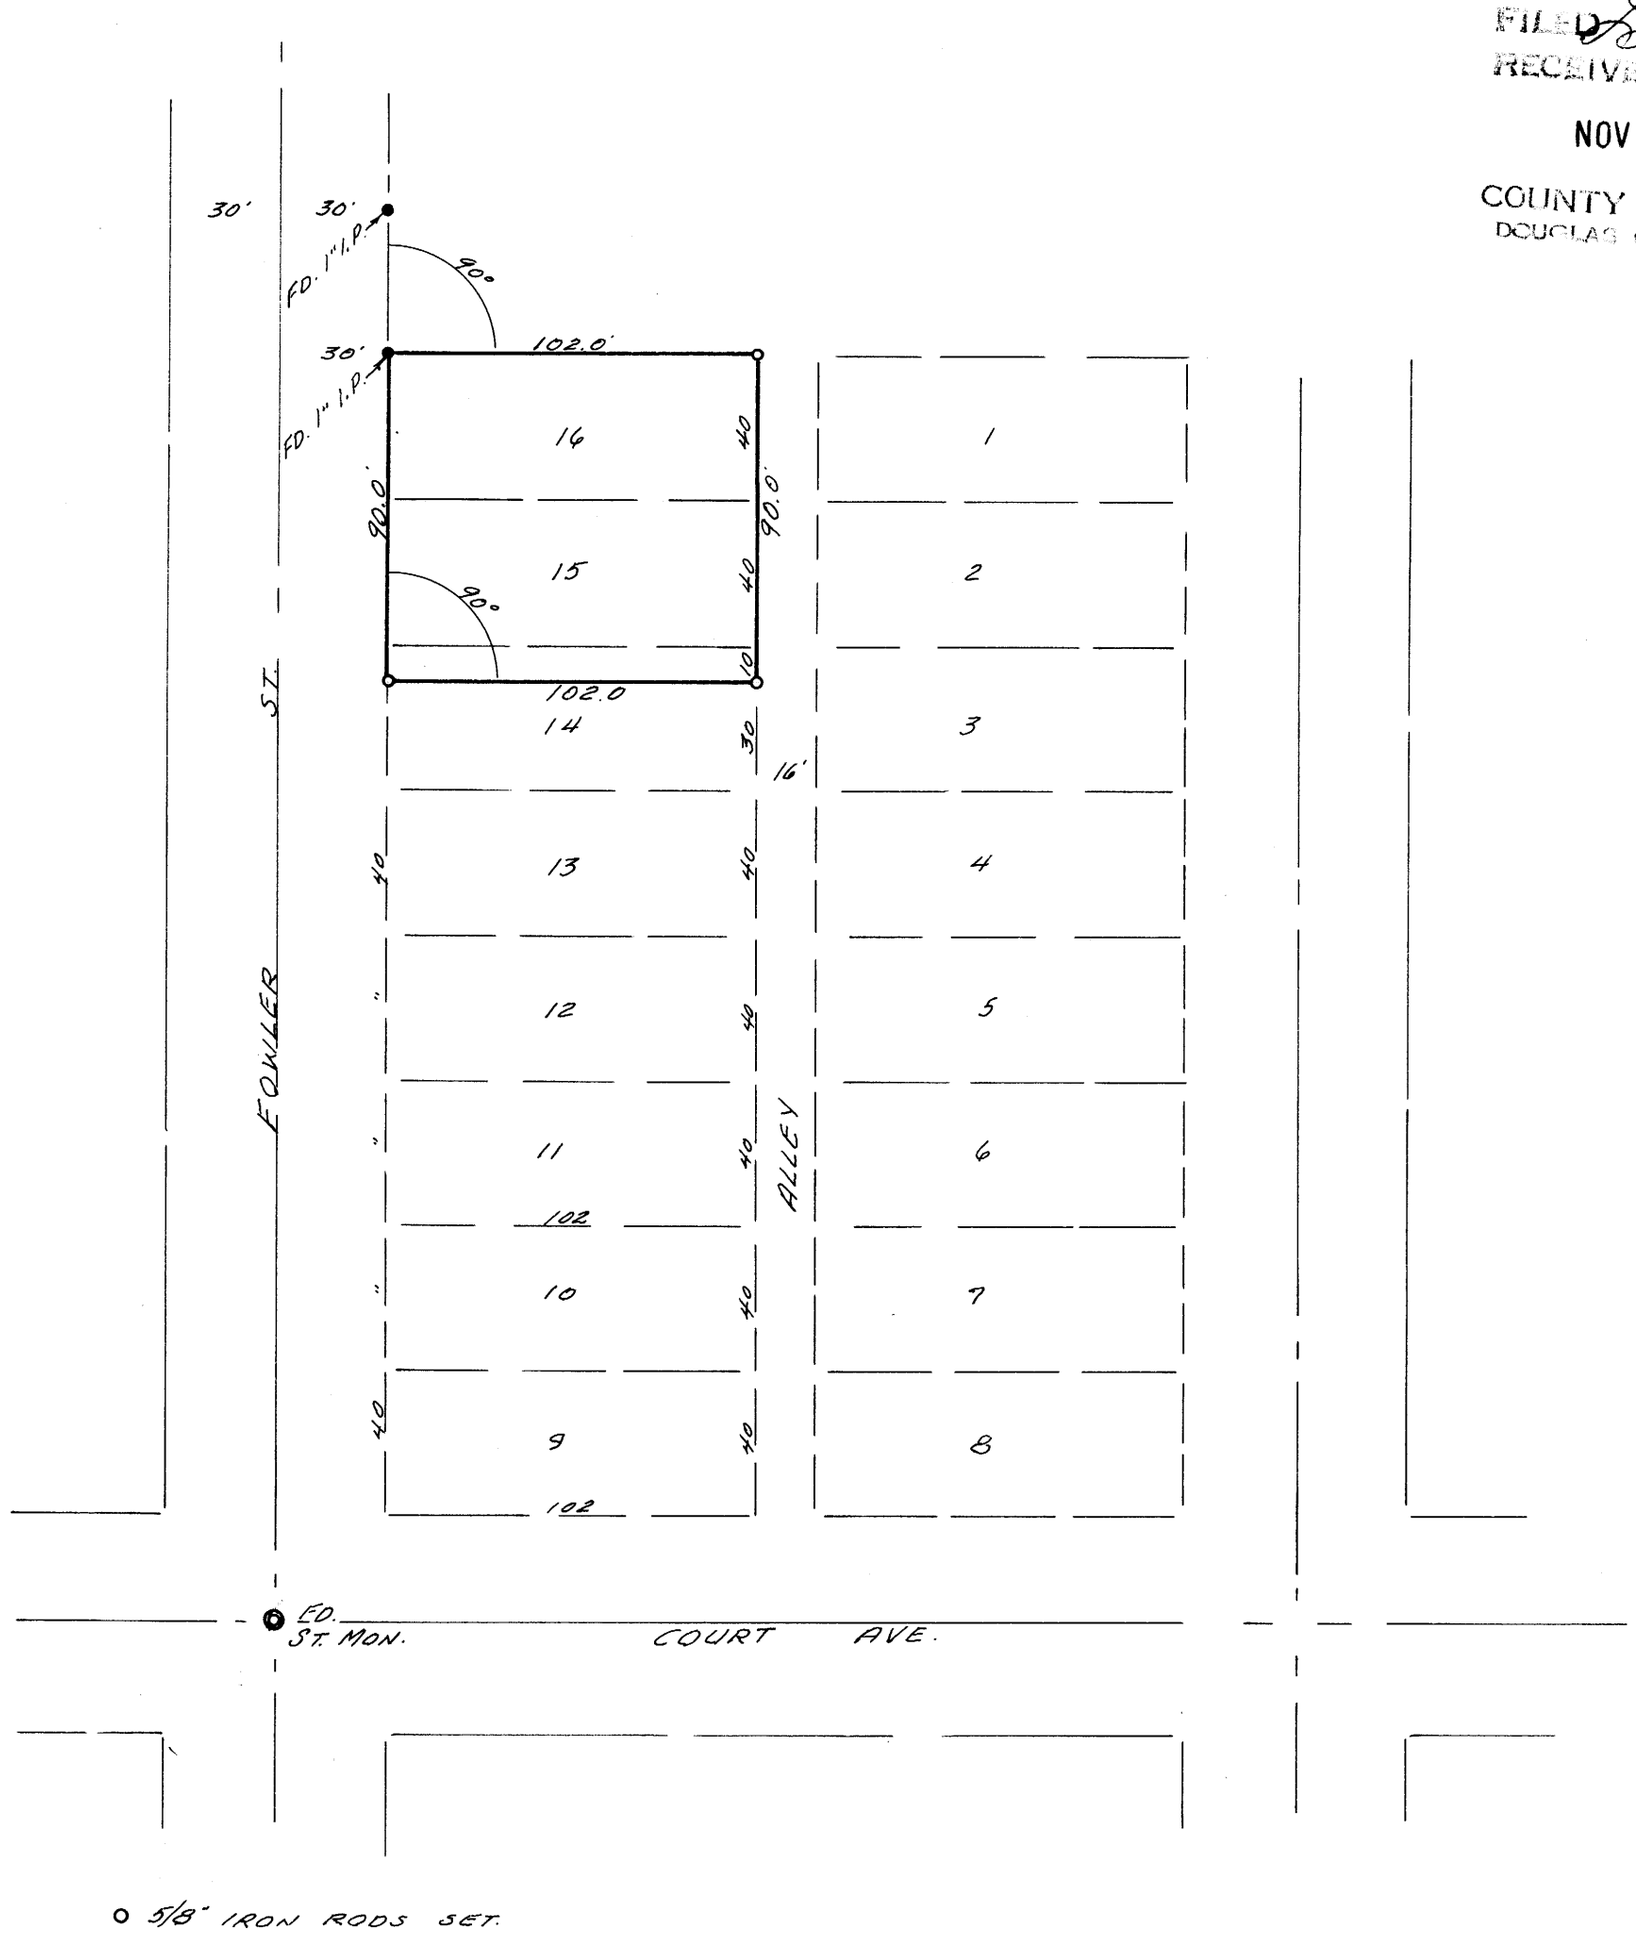

○ 5/8" IRON RODS SET.

REGISTERED PROFESSIONAL ENGINEER
2128
W. S. Barnes
OREGON
SEPT. 5, 1941
William S. Barnes

FILE M 36 - 65