MAP FILE M37 # 14

COUNTY SURVEYORS FILE DATA
DO NOT REMOVE FROM OFFICE

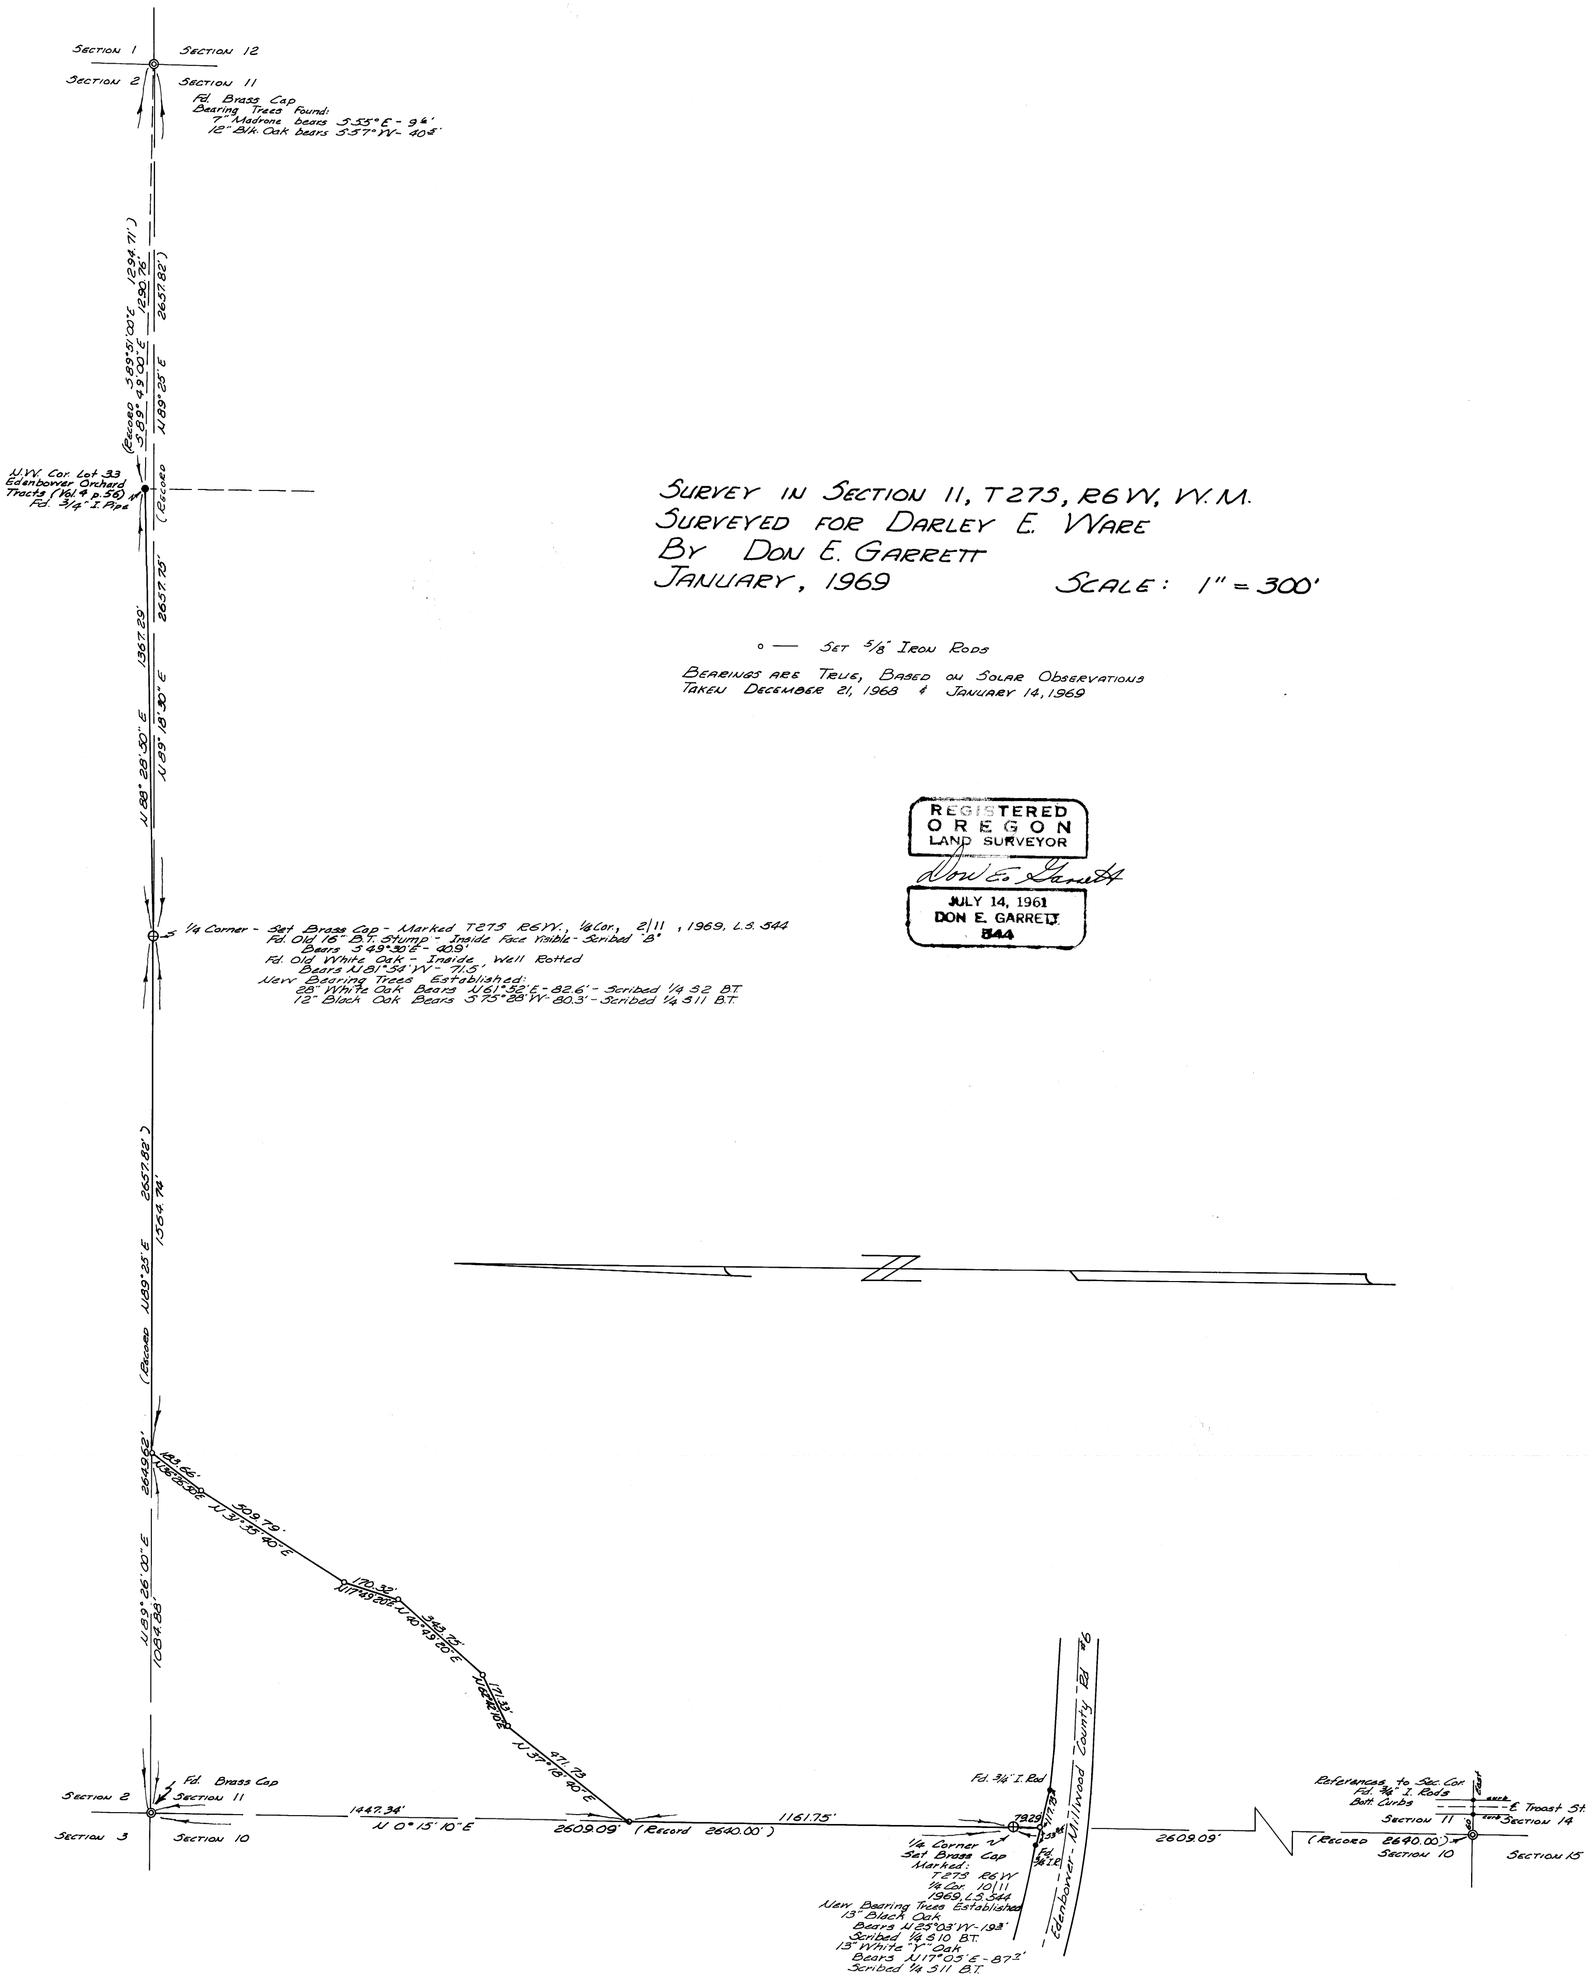

SURVEY IN SECTION 11, T 27 S, R 6 W, W.M.
SURVEYED FOR DARLEY E. WARE
BY DON E. GARRETT
JANUARY, 1969 SCALE: 1" = 300'

○ — SET 5/8" IRON RODS

BEARINGS ARE TRUE, BASED ON SOLAR OBSERVATIONS
TAKEN DECEMBER 21, 1968 & JANUARY 14, 1969

REGISTERED
OREGON
LAND SURVEYOR

Don E. Garrett

JULY 14, 1961
DON E. GARRETT
544

FILED
RECORDED
FEB 14 1969
COUNTY SURVEYOR
DOUGLAS COUNTY, ORE.
MAP FILE M37 # 14