C.S. 54/79
M 37-20

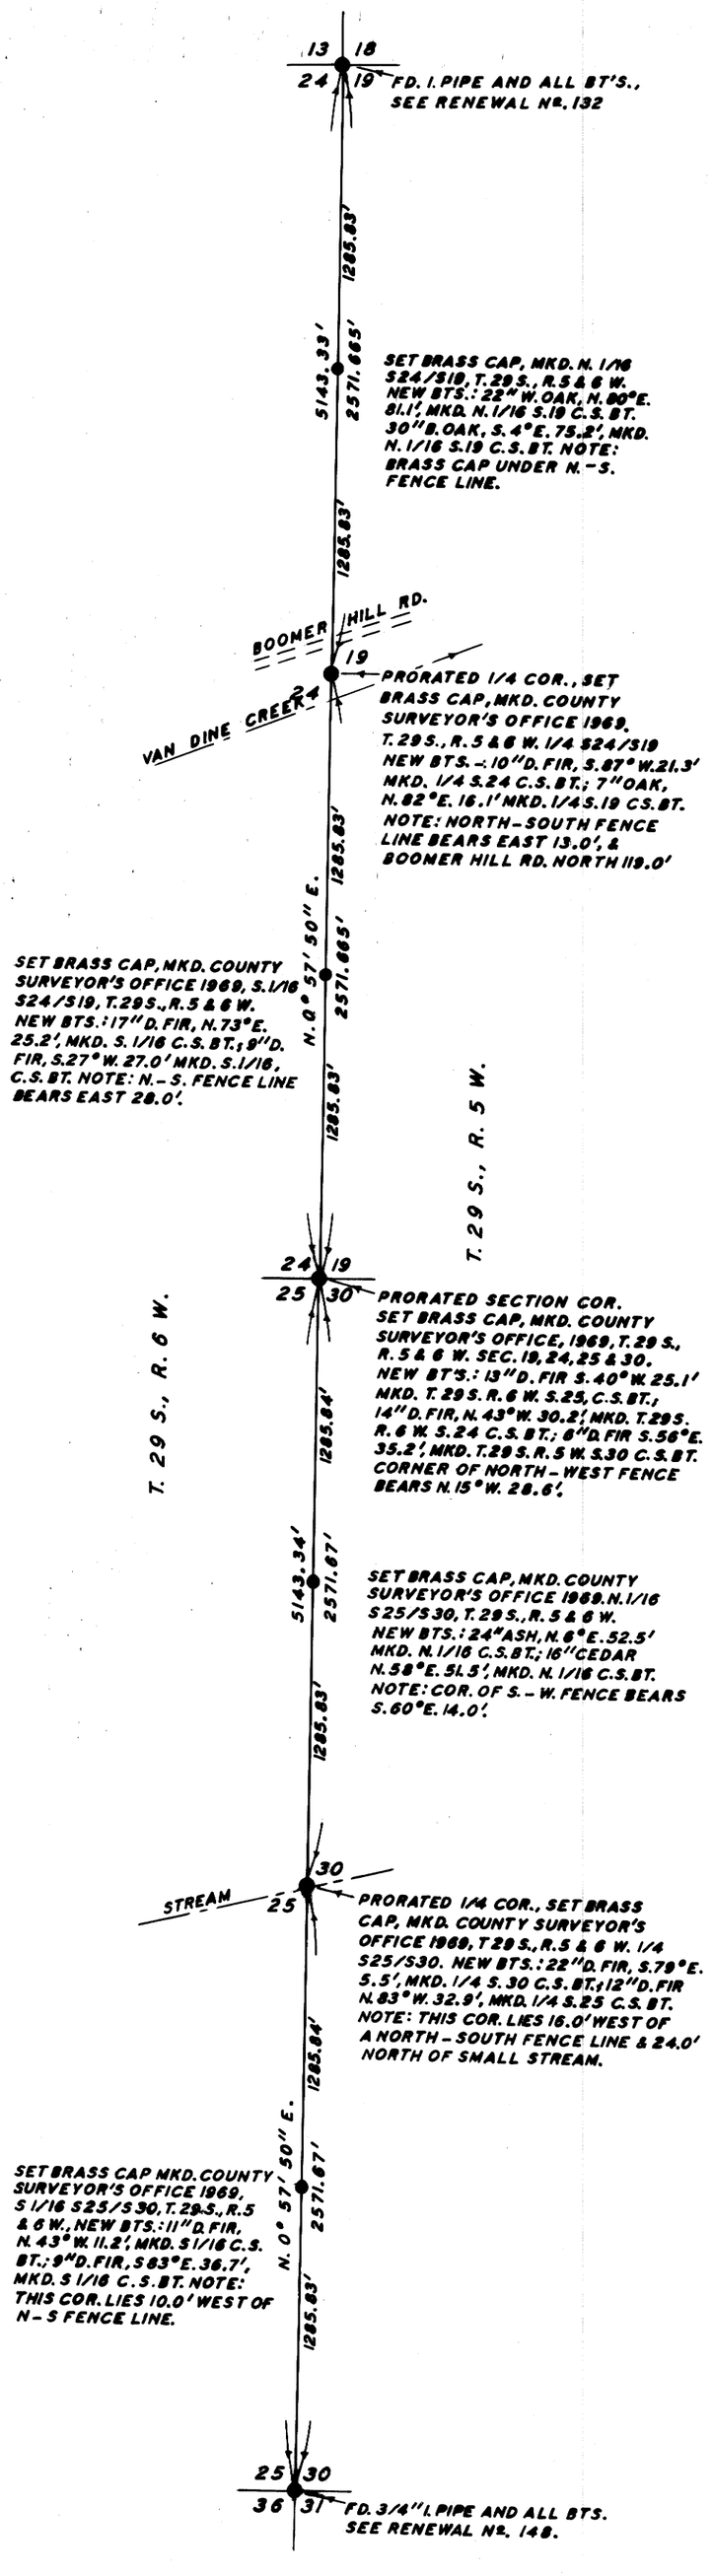

NOTE: BEARINGS ARE MAGNETIC, WITH A VAR. OF 20°00'

SEE
VOID
M 68-47

REGISTERED
OREGON
LAND SURVEYOR
James W. Byron
NOV. 6. 1953
JAMES W. BYRON
303

COUNTY SURVEYOR'S OFFICE
DOUGLAS COUNTY, OREGON

SURVEY TO SET SECTION CORNERS, BETWEEN T. 29 S., R. 5 & 6 W, W.M.

JAMES W. BYRON — COUNTY SURVEYOR
SURVEYED JAN. 1969 — SCALE 1" = 600'
SURVEYED FOR DOUGLAS CO.

COUNTY SURVEYORS FILE DATA
DO NOT REMOVE FROM OFFICE

C.S. 54/79
M37-20