COUNTY SURVEYORS FILE DATA
DO NOT REMOVE FROM OFFICE

SURVEY IN SECTIONS 16 & 17, T22S, R9W, W.M.
SURVEY FOR DALE A. KRUG & WILLIAM JAYNE
SURVEY BY DON E. GARRETT
MARCH, 1969 SCALE: 1" = 50'

● — DENOTES SET 5/8" IRON ROD
■ — DENOTES FD. 1" BOLT

NOTE: FOR BASE BEARING AND FD. PROPERTY PINS, REFER TO M 30-67 AND C.S. FILE 51-327

REGISTERED
OREGON
LAND SURVEYOR
Don Garrett
JULY 14, 1961
DON E. GARRETT
344
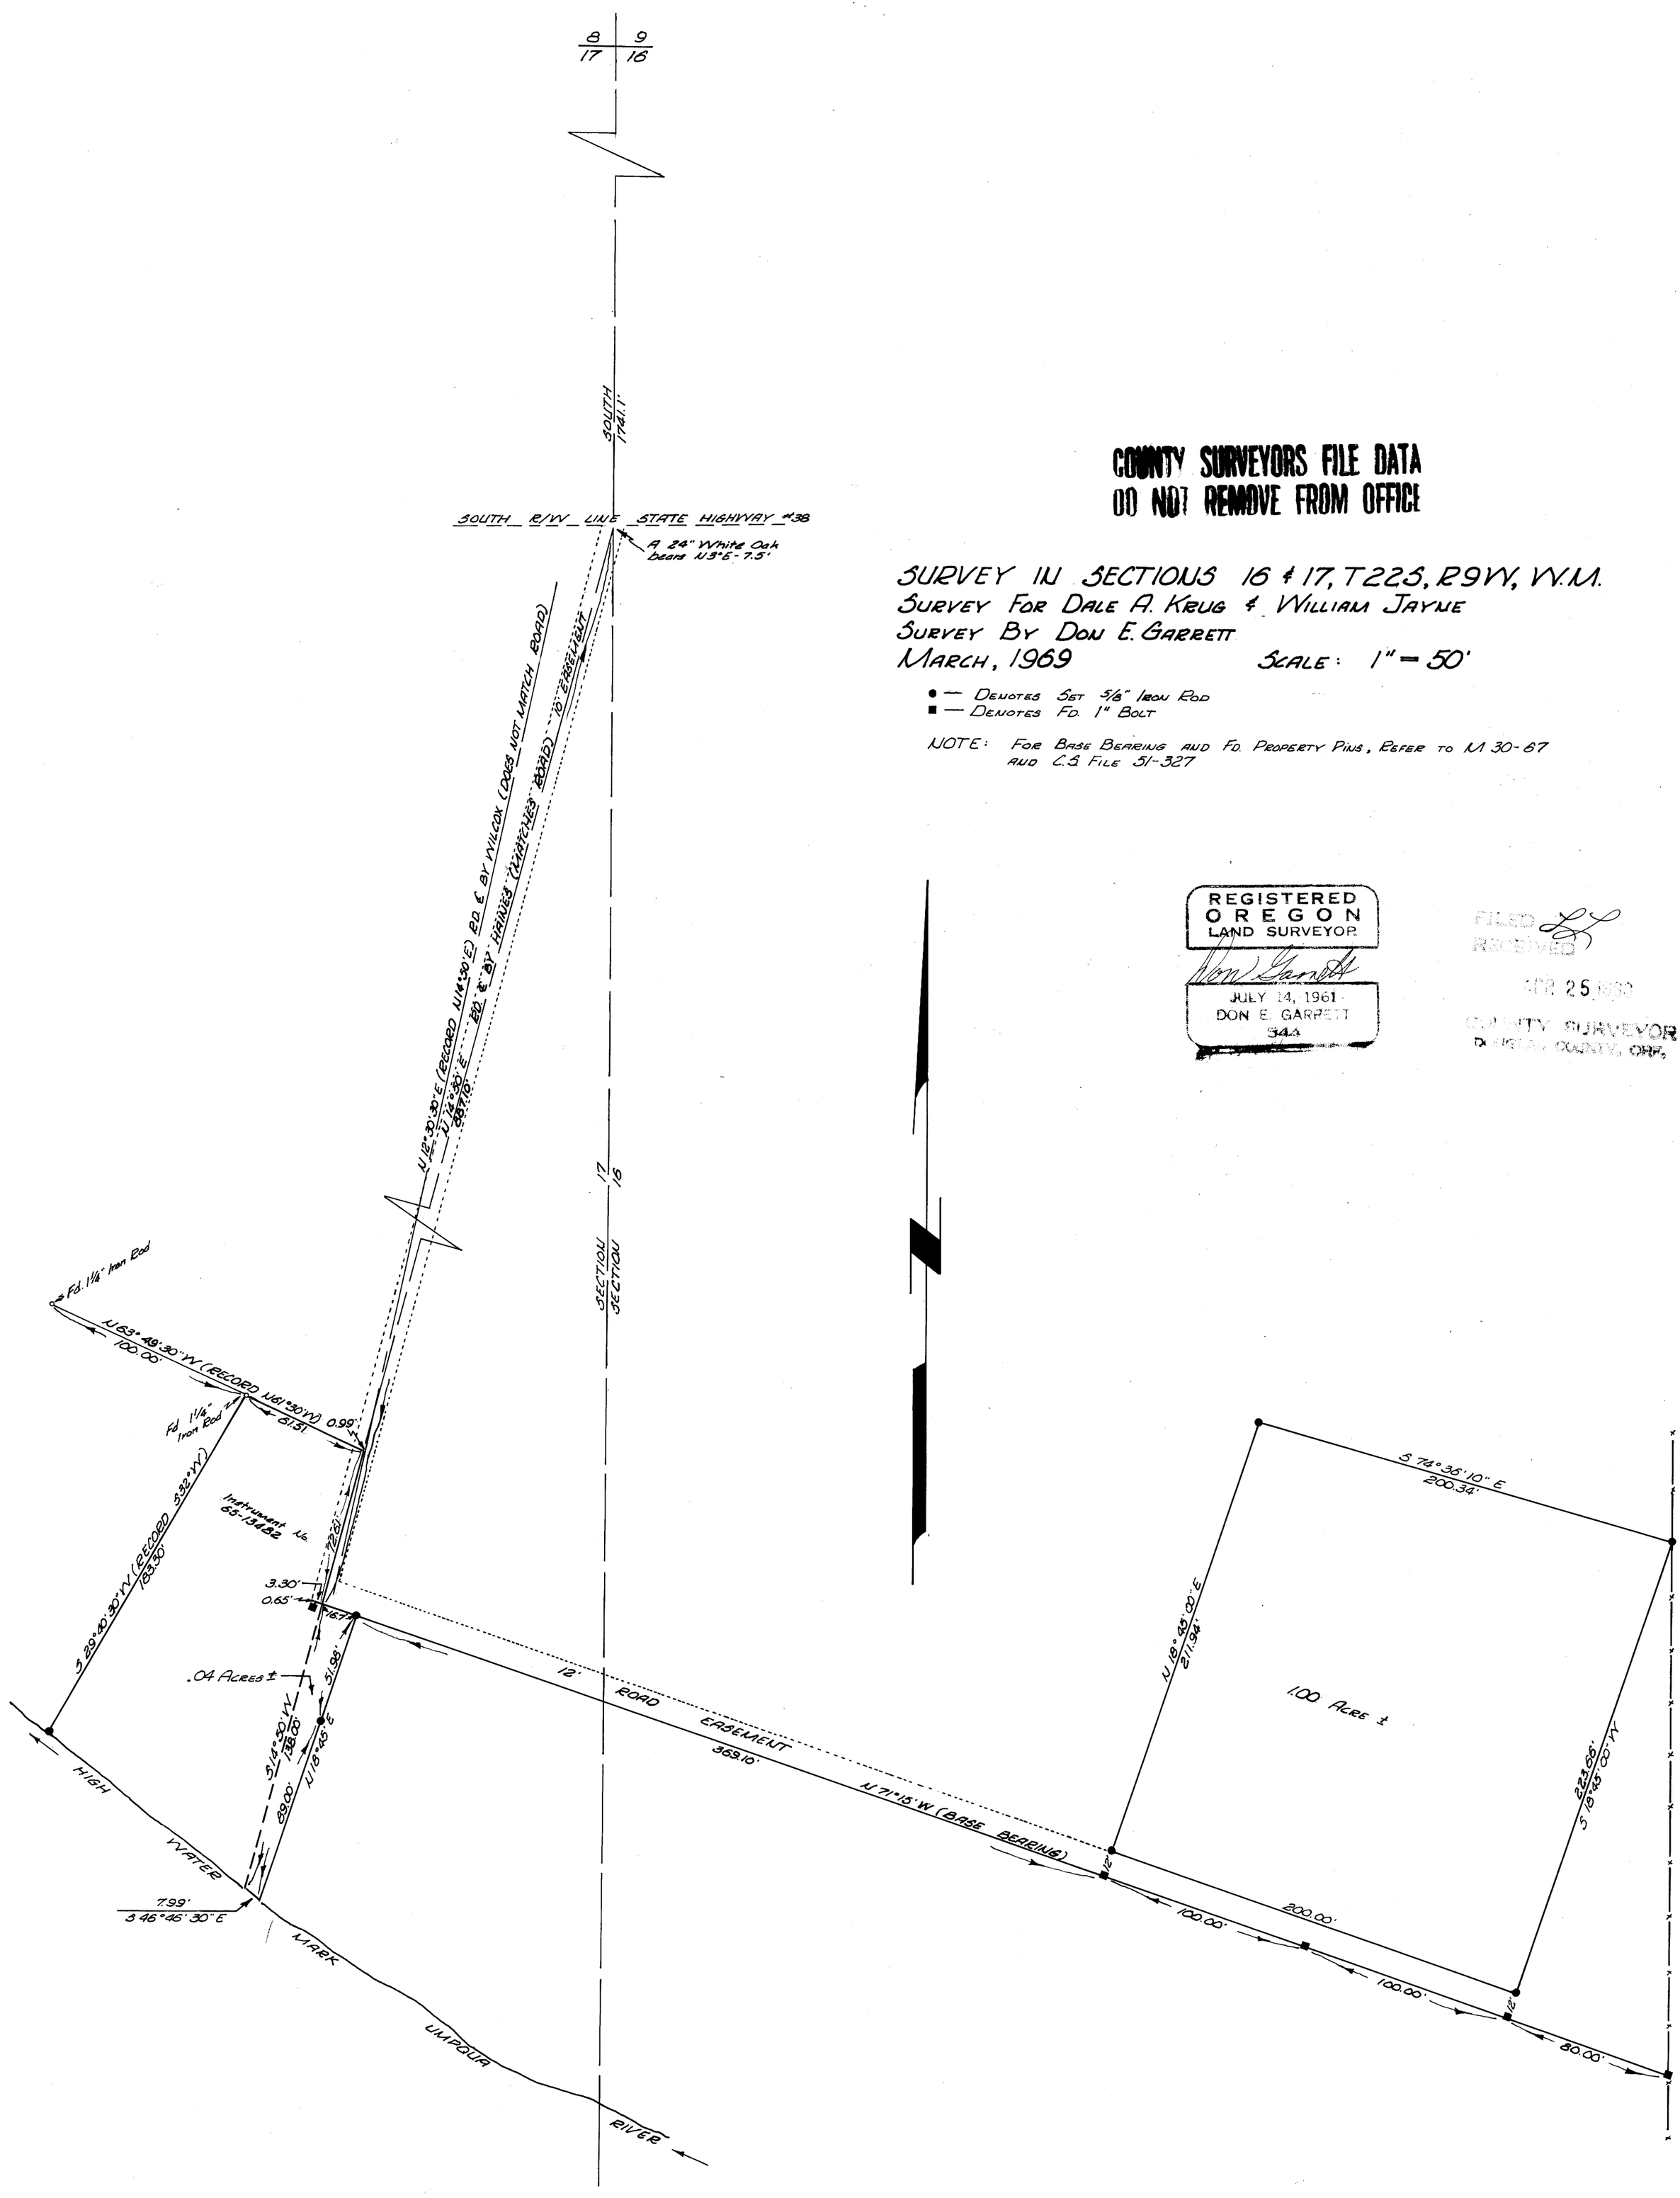
FILED
RECEIVED
MAR 25 1969
COUNTY SURVEYOR
DOUGLAS COUNTY, ORE.