FILED
RECEIVED

APR 29 1969

COUNTY SURVEYOR
DOUGLAS COUNTY, ORE.

COUNTY SURVEYORS FILE DATA
DO NOT REMOVE FROM OFFICE

SURVEY IN SECTION 5, T. 24 S., R. 5 W., W. M.
SURVEYED FOR REX TOLLEFSON
SURVEYED BY R. H. GEE
APRIL, 1969 - SCALE 1" = 100'

REGISTERED PROFESSIONAL ENGINEER
2728
R. H. GEE
OREGON
OCT. 22, 1964
R. H. GEE

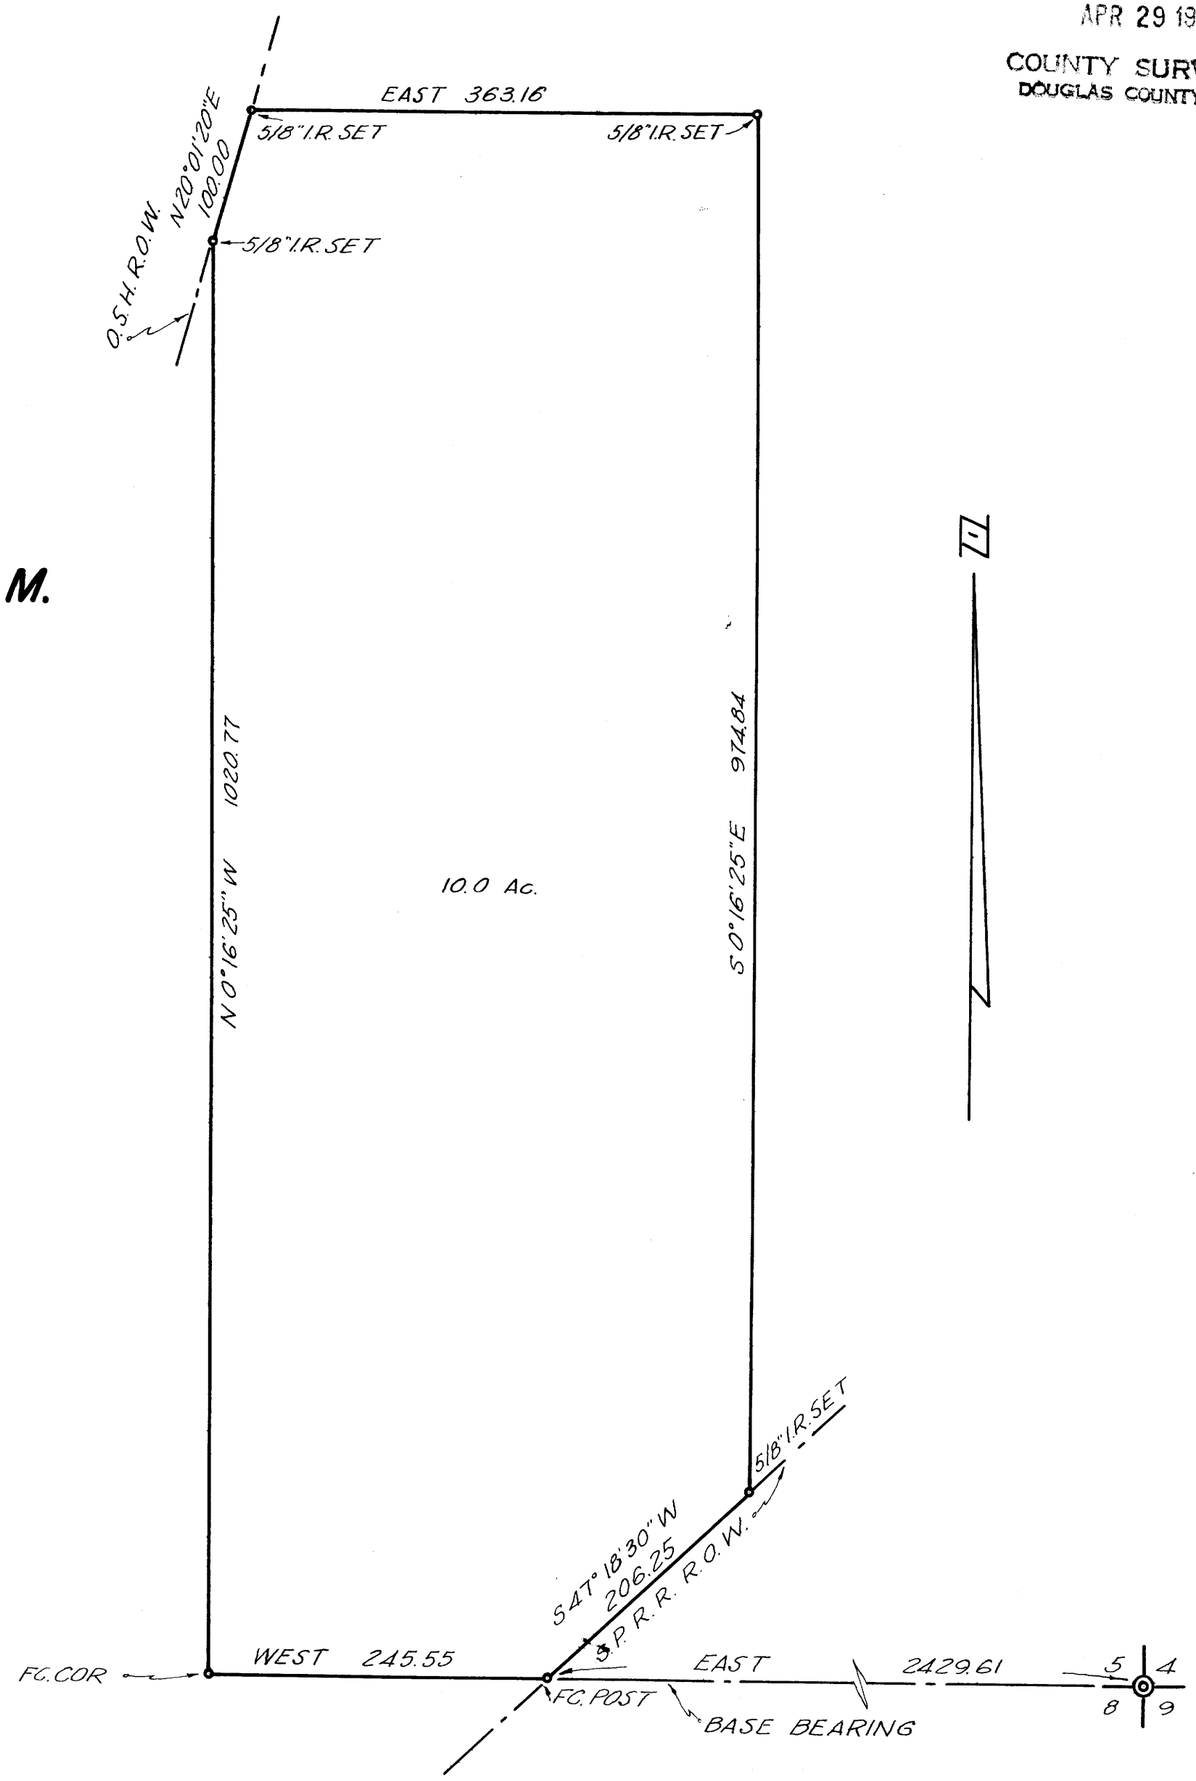

MAP FILE M-37 P 58