MAP FILE 37 65

FILED
RECEIVED
MAY 8 1969
COUNTY SURVEYOR
DOUGLAS COUNTY, ORE.

COUNTY SURVEYORS FILE DATA
DO NOT REMOVE FROM OFFICE

SURVEY IN SECTION 35, T32S, R5W, W.M.

SURVEYED FOR LITTLE RIVER BOX CO.
SURVEYED BY DON E. GARRETT
MAY, 1969 SCALE: 1" = 50'

o— Denotes Set 5/8" Iron Rods
Bearings Based on Solar Observation Taken April 29, 1969

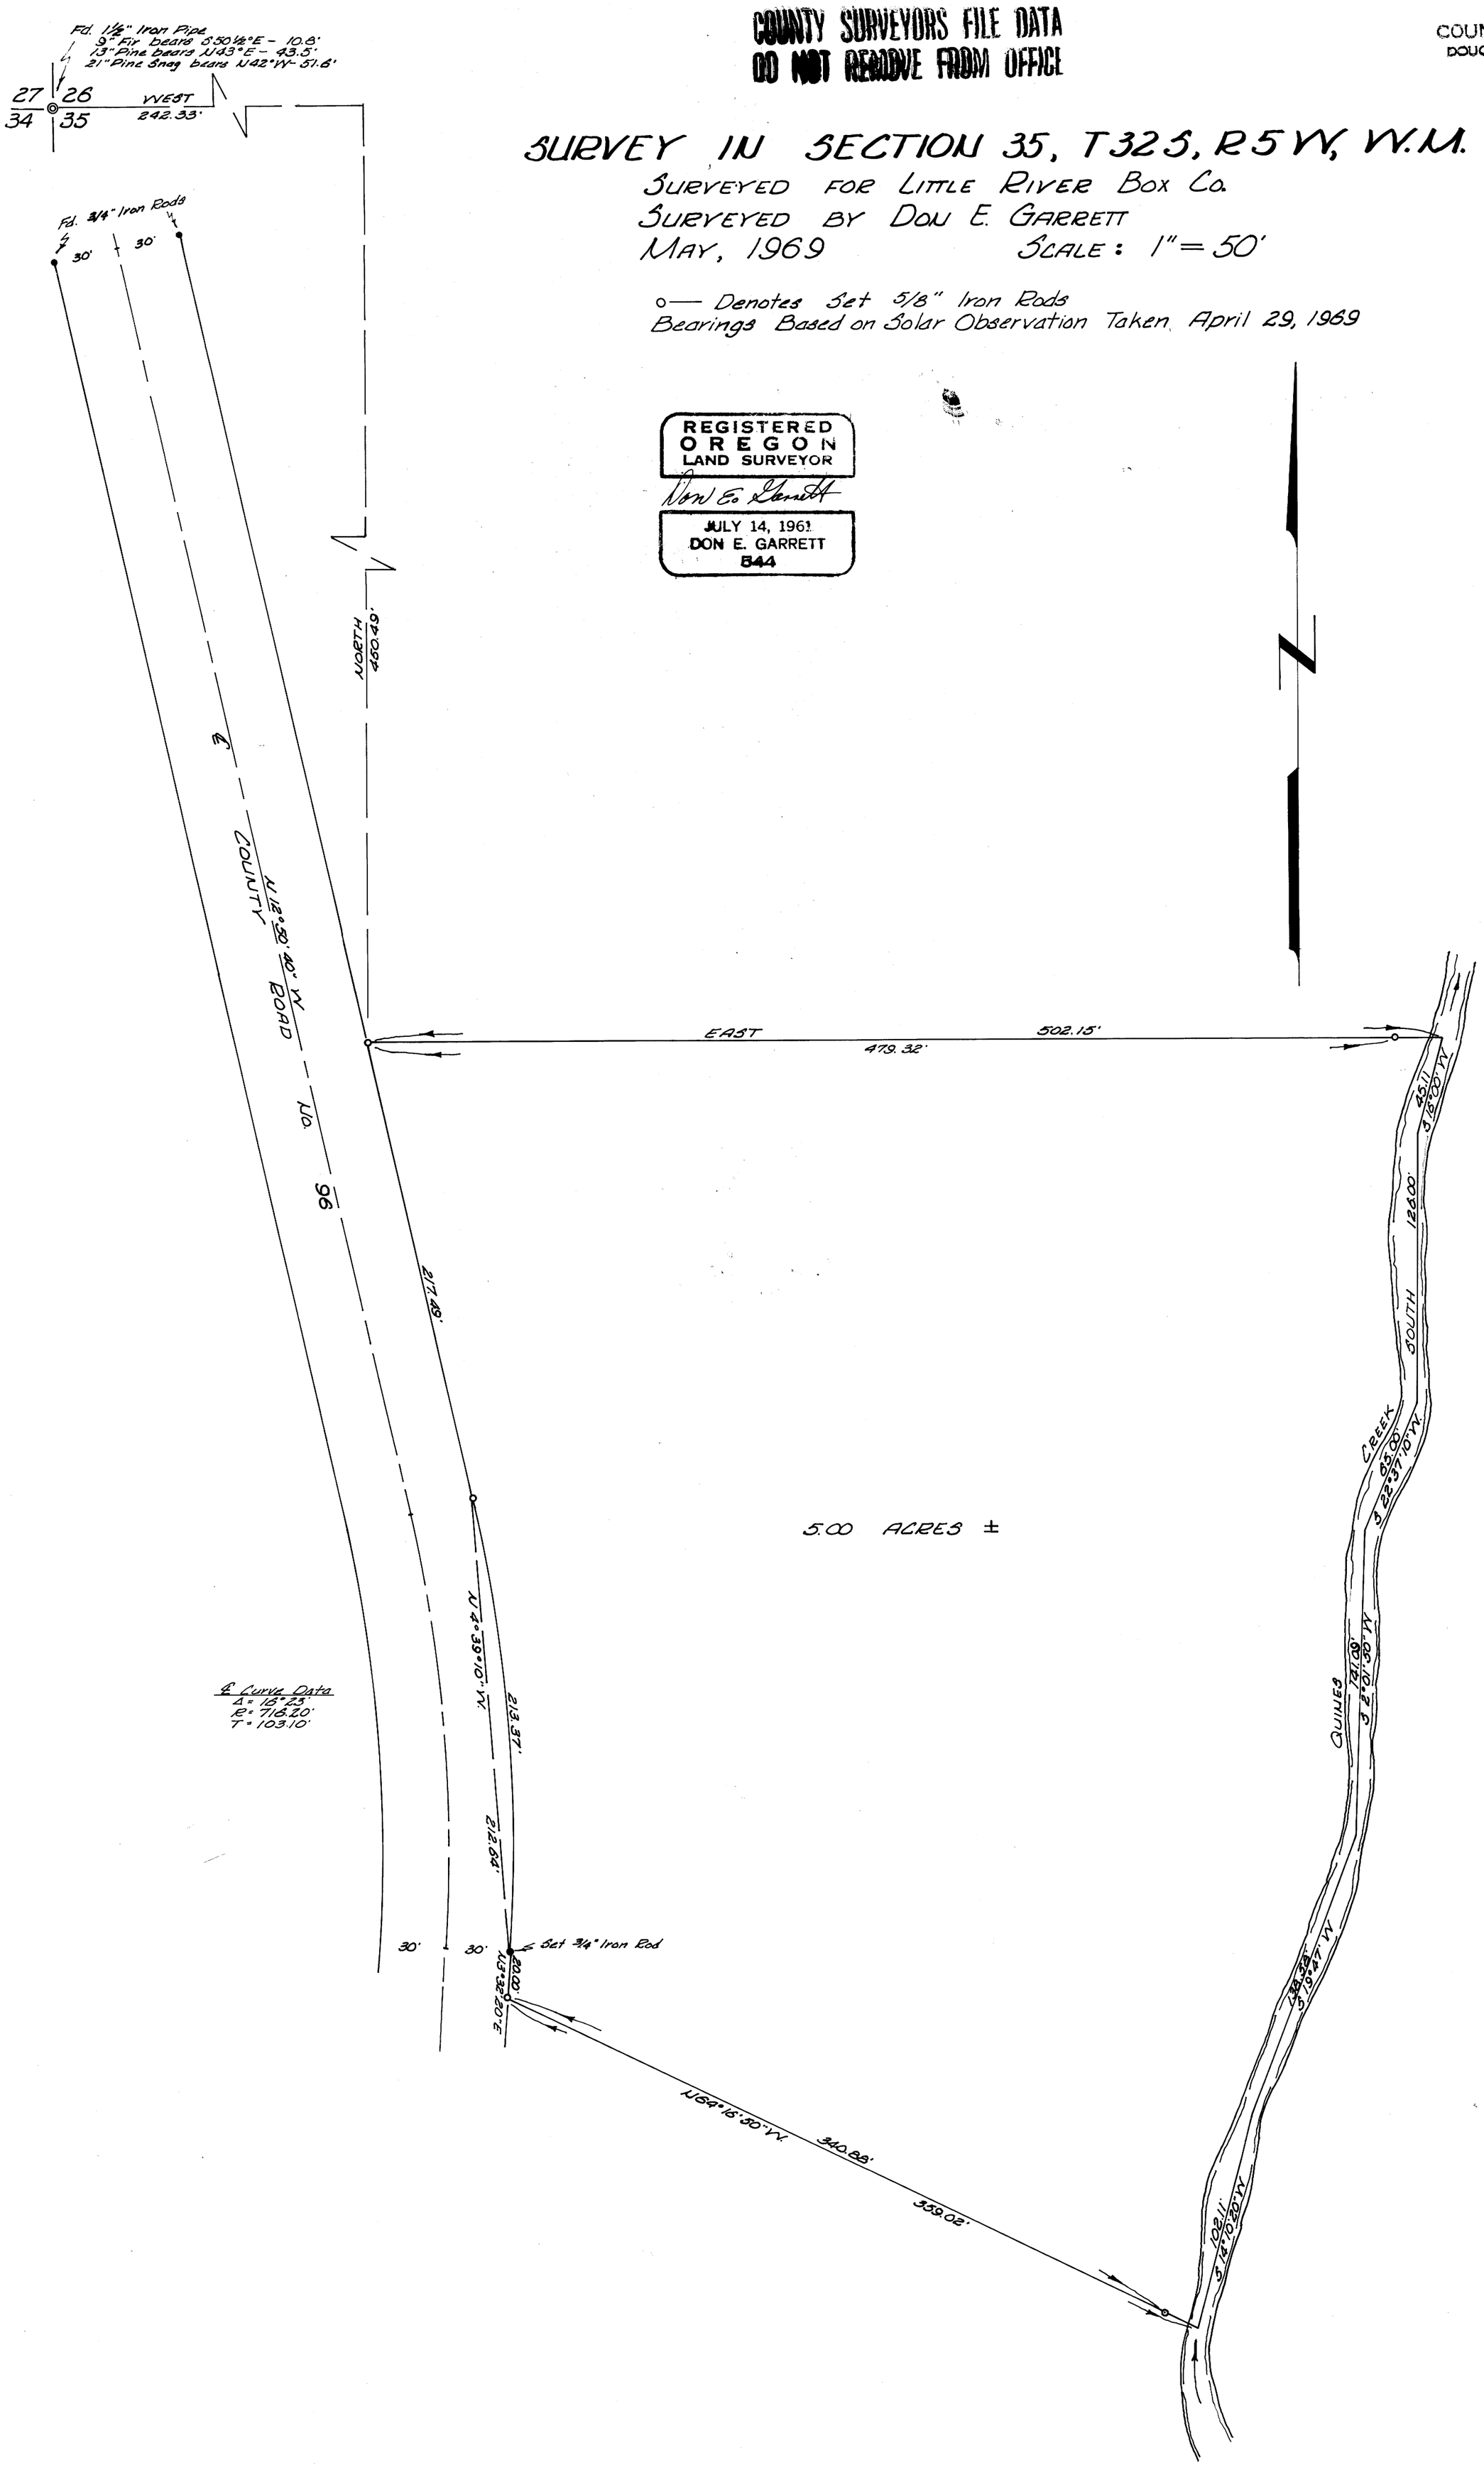

MAP FILE 37 65