COUNTY SURVEYORS FILE DATA
DO NOT REMOVE FROM OFFICE

SURVEY IN BLOCK 41, CITY OF ROSEBURG, OREGON

SURVEYED FOR JOE AGOST & LARRY DURST
SURVEYED BY DON E. GARRETT
MAY, 1969 SCALE: 1" = 20'

o — DENOTES SET 5/8" IRON RODS
FOR RECORD BEARINGS & DISTANCES SEE M 8-62 & C.S. 1628

REGISTERED
OREGON
LAND SURVEYOR
Don E. Garrett
JULY 14, 1961
DON E. GARRETT
544

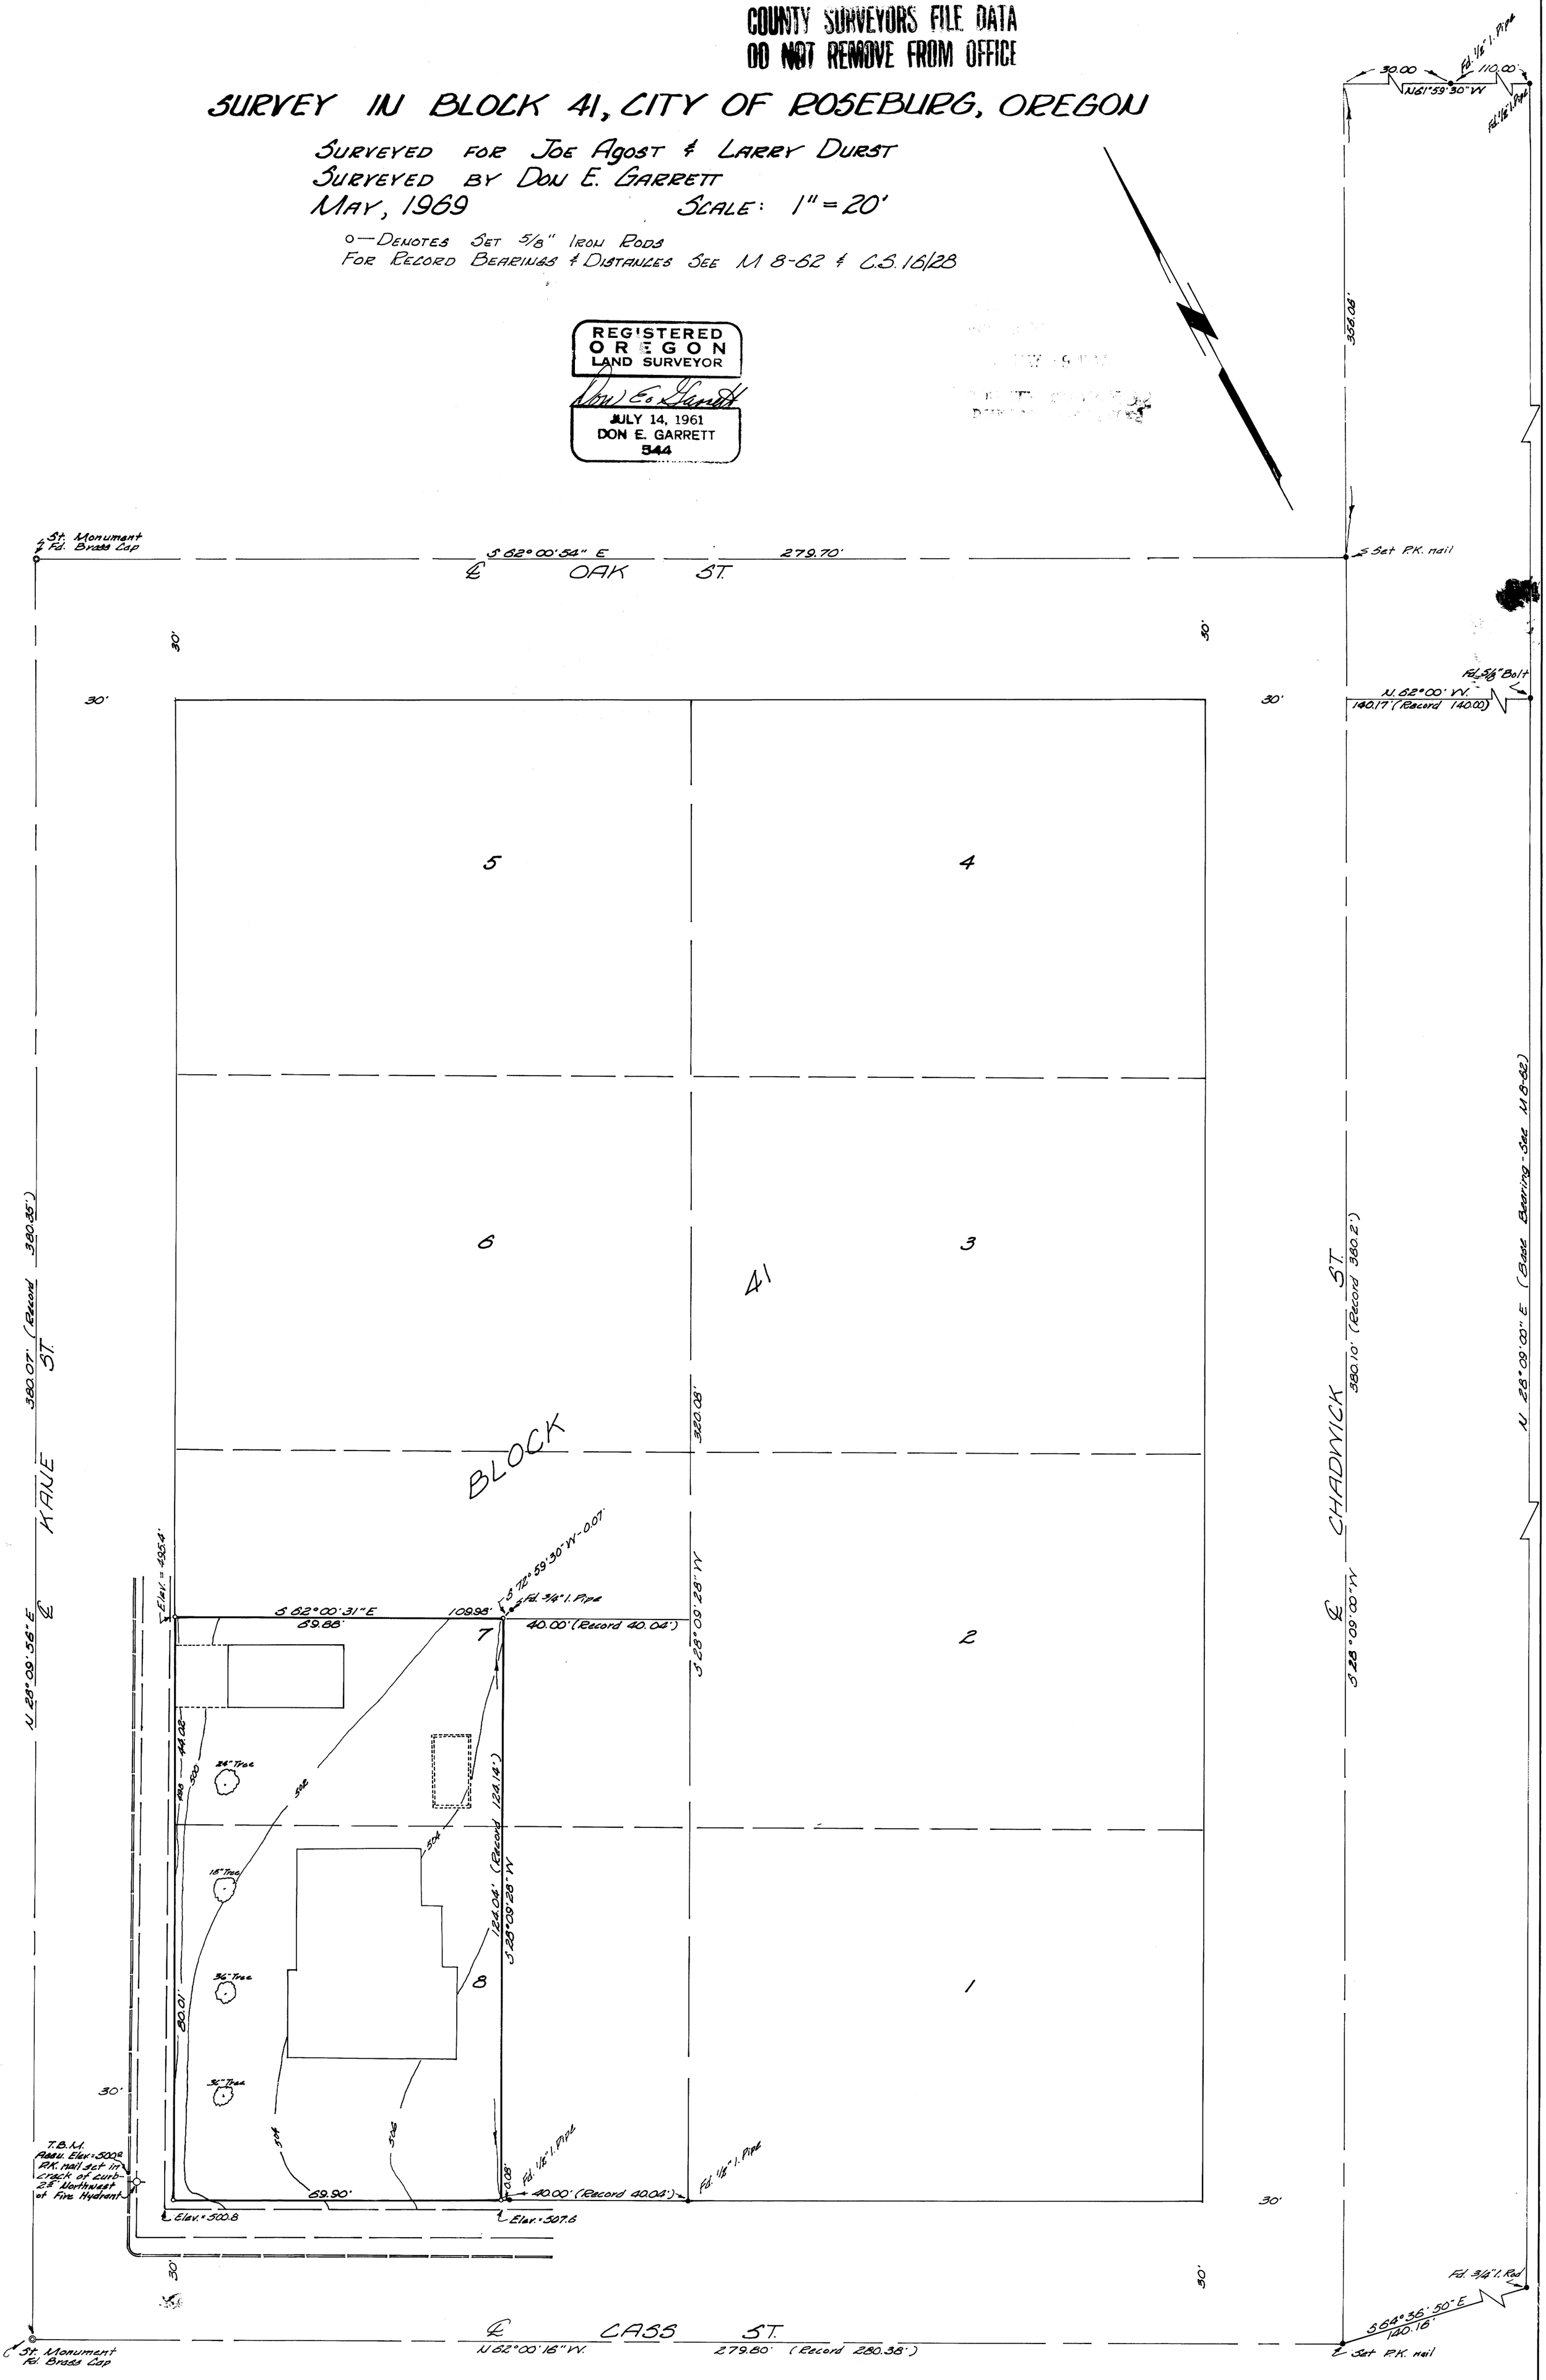

MAP FILE 37 67