COUNTY SURVEYORS FILE DATA
DO NOT REMOVE FROM OFFICE

SURVEY IN SECTION 34, T27S, R7W, W.M.

SURVEYED FOR NEAL MEYER
SURVEYED BY DON E. GARRETT
MAY, 1969 SCALE: 1" = 50'

o — DENOTES SET 5/8" IRON RODS
BEARINGS ARE BASED ON THE NORTH LINE D.L.C. # 38
SEE M36-71

REGISTERED
OREGON
LAND SURVEYOR
Don E. Garrett
JULY 14, 1961
DON E. GARRETT
544

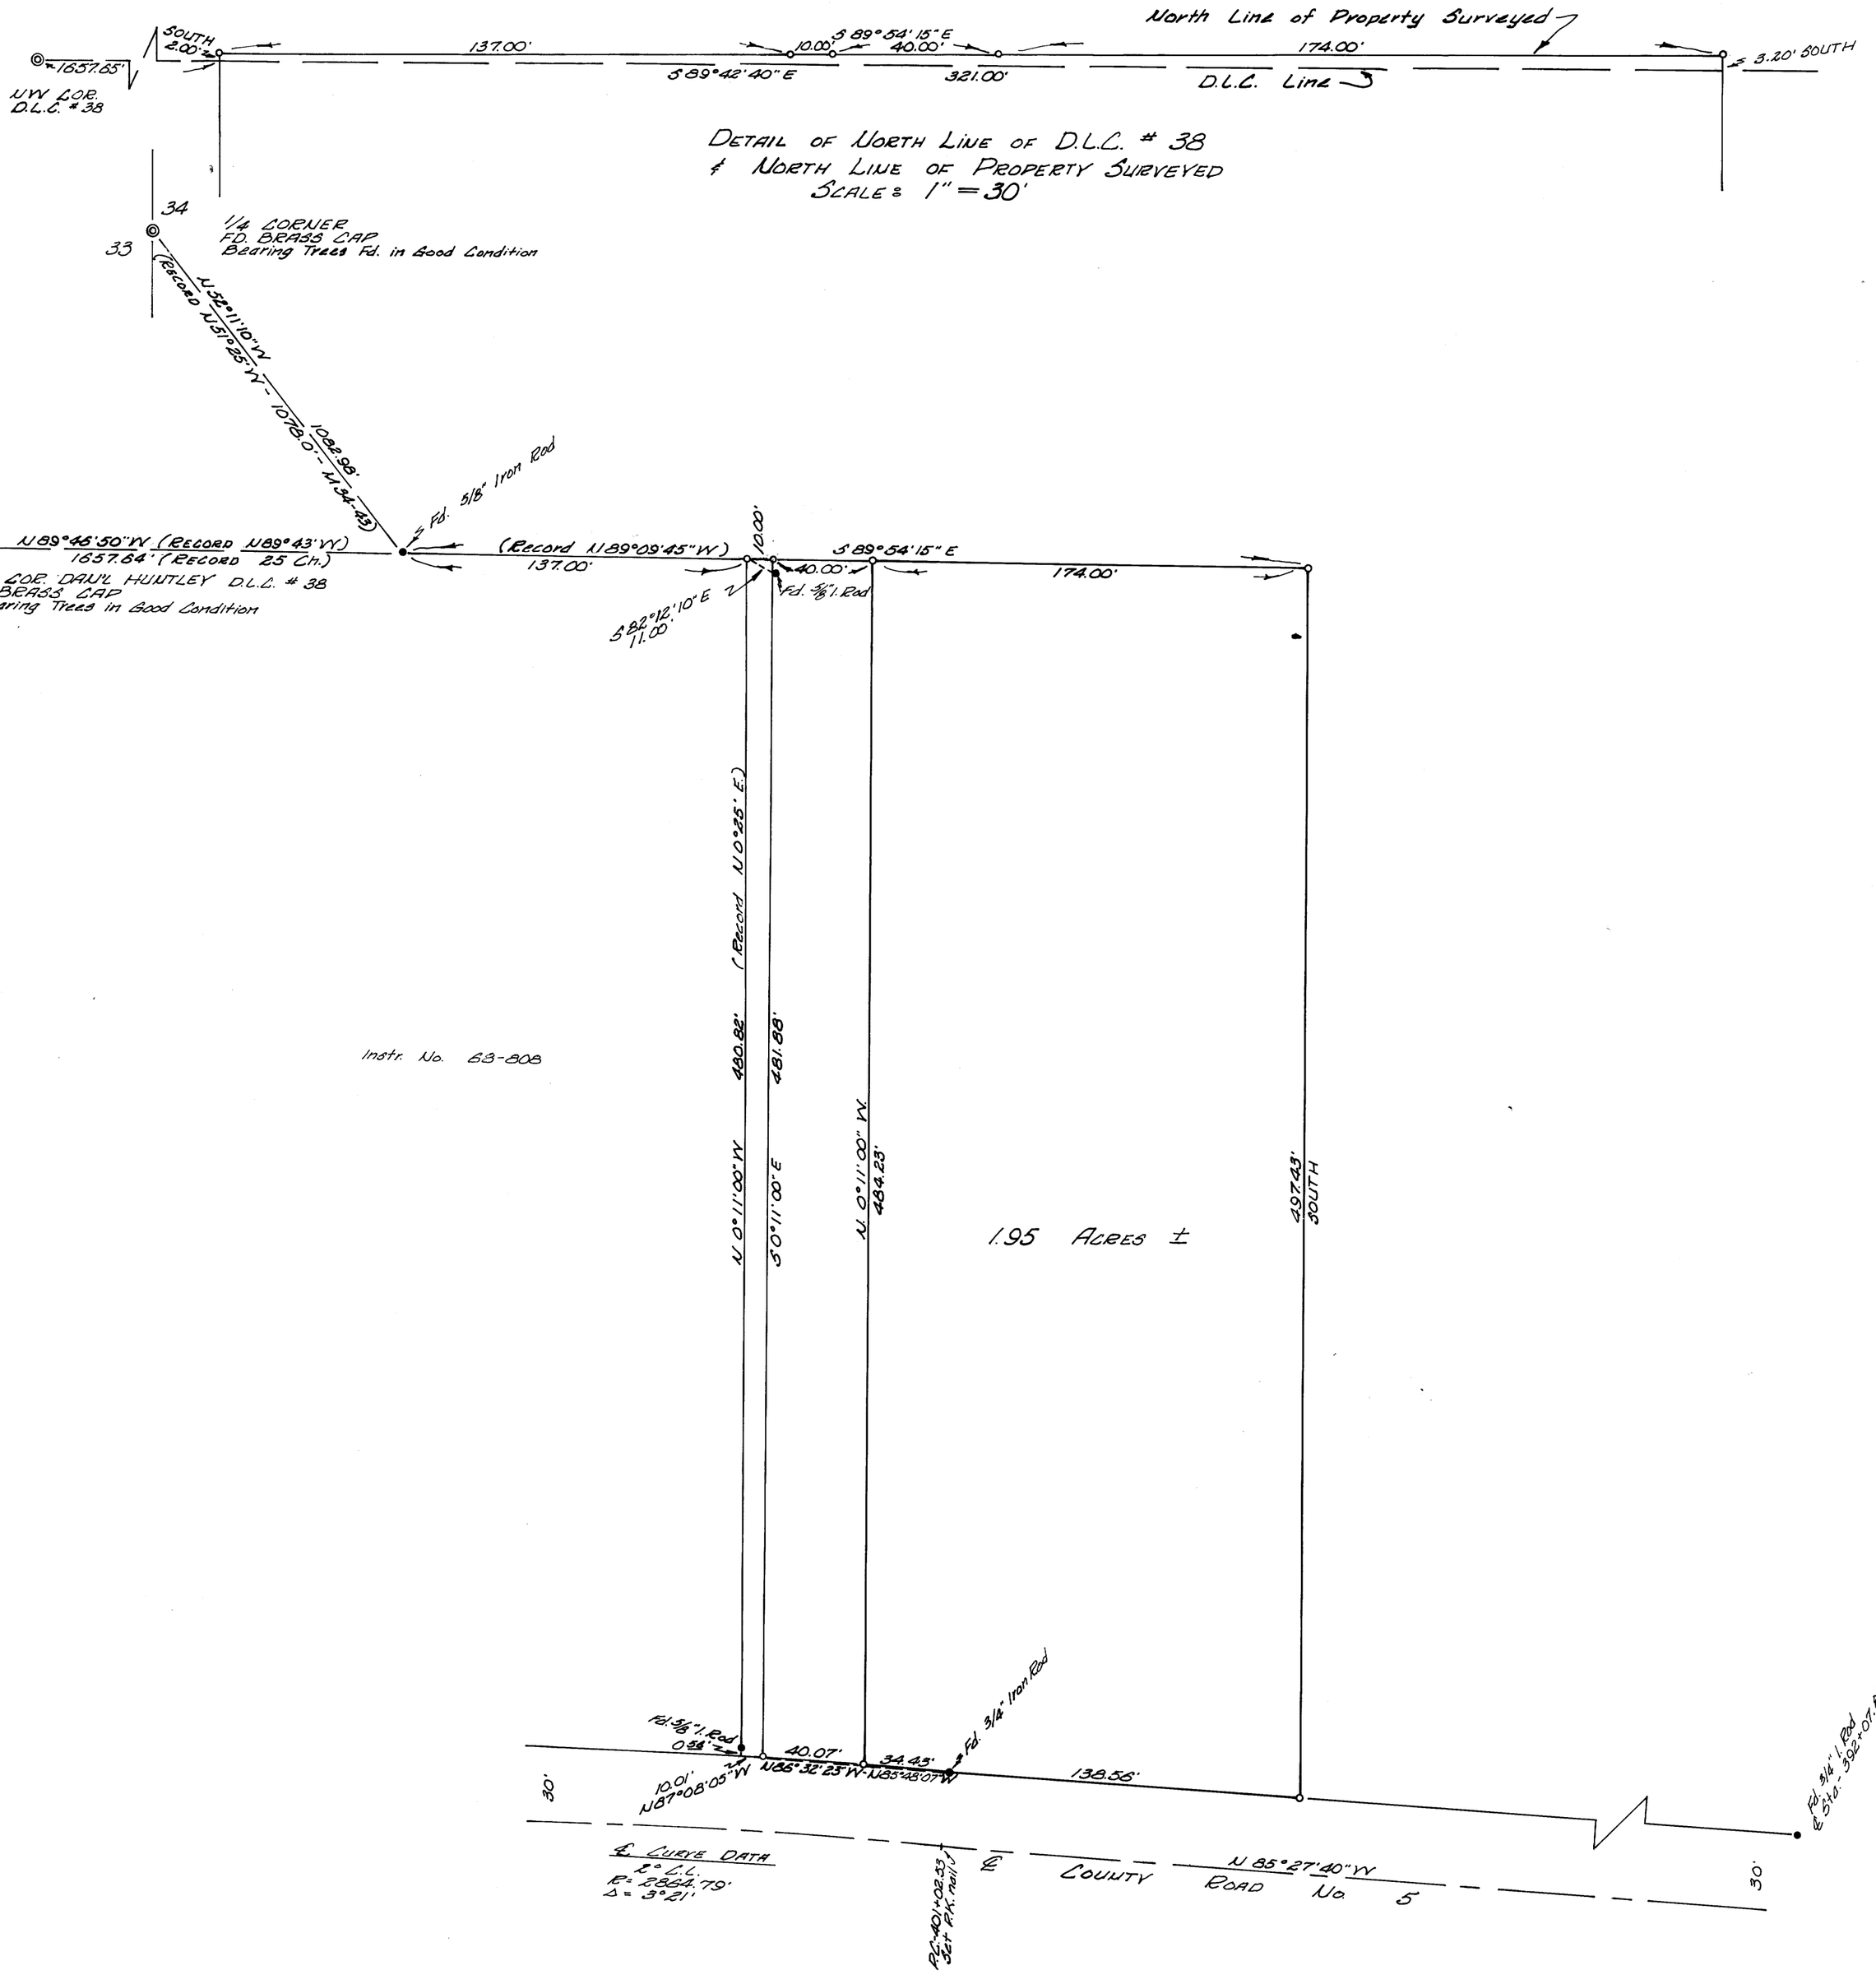

MAP FILE 37 - 68