MAP FILE M37-7

COUNTY SURVEYORS FILE DATA
DO NOT REMOVE FROM OFFICE

SURVEYED FOR DEED DESCRIPTION
SURVEY IN SEC. 14, T21S, R4W, W.M.
SURVEYED FOR JAMES B. DAVIS BY DON E. GARRETT
JANUARY, 1969 SCALE: 1" = 100'

REGISTERED
OREGON
LAND SURVEYOR
Don E. Garrett
JULY 14, 1961
DON E. GARRETT
544

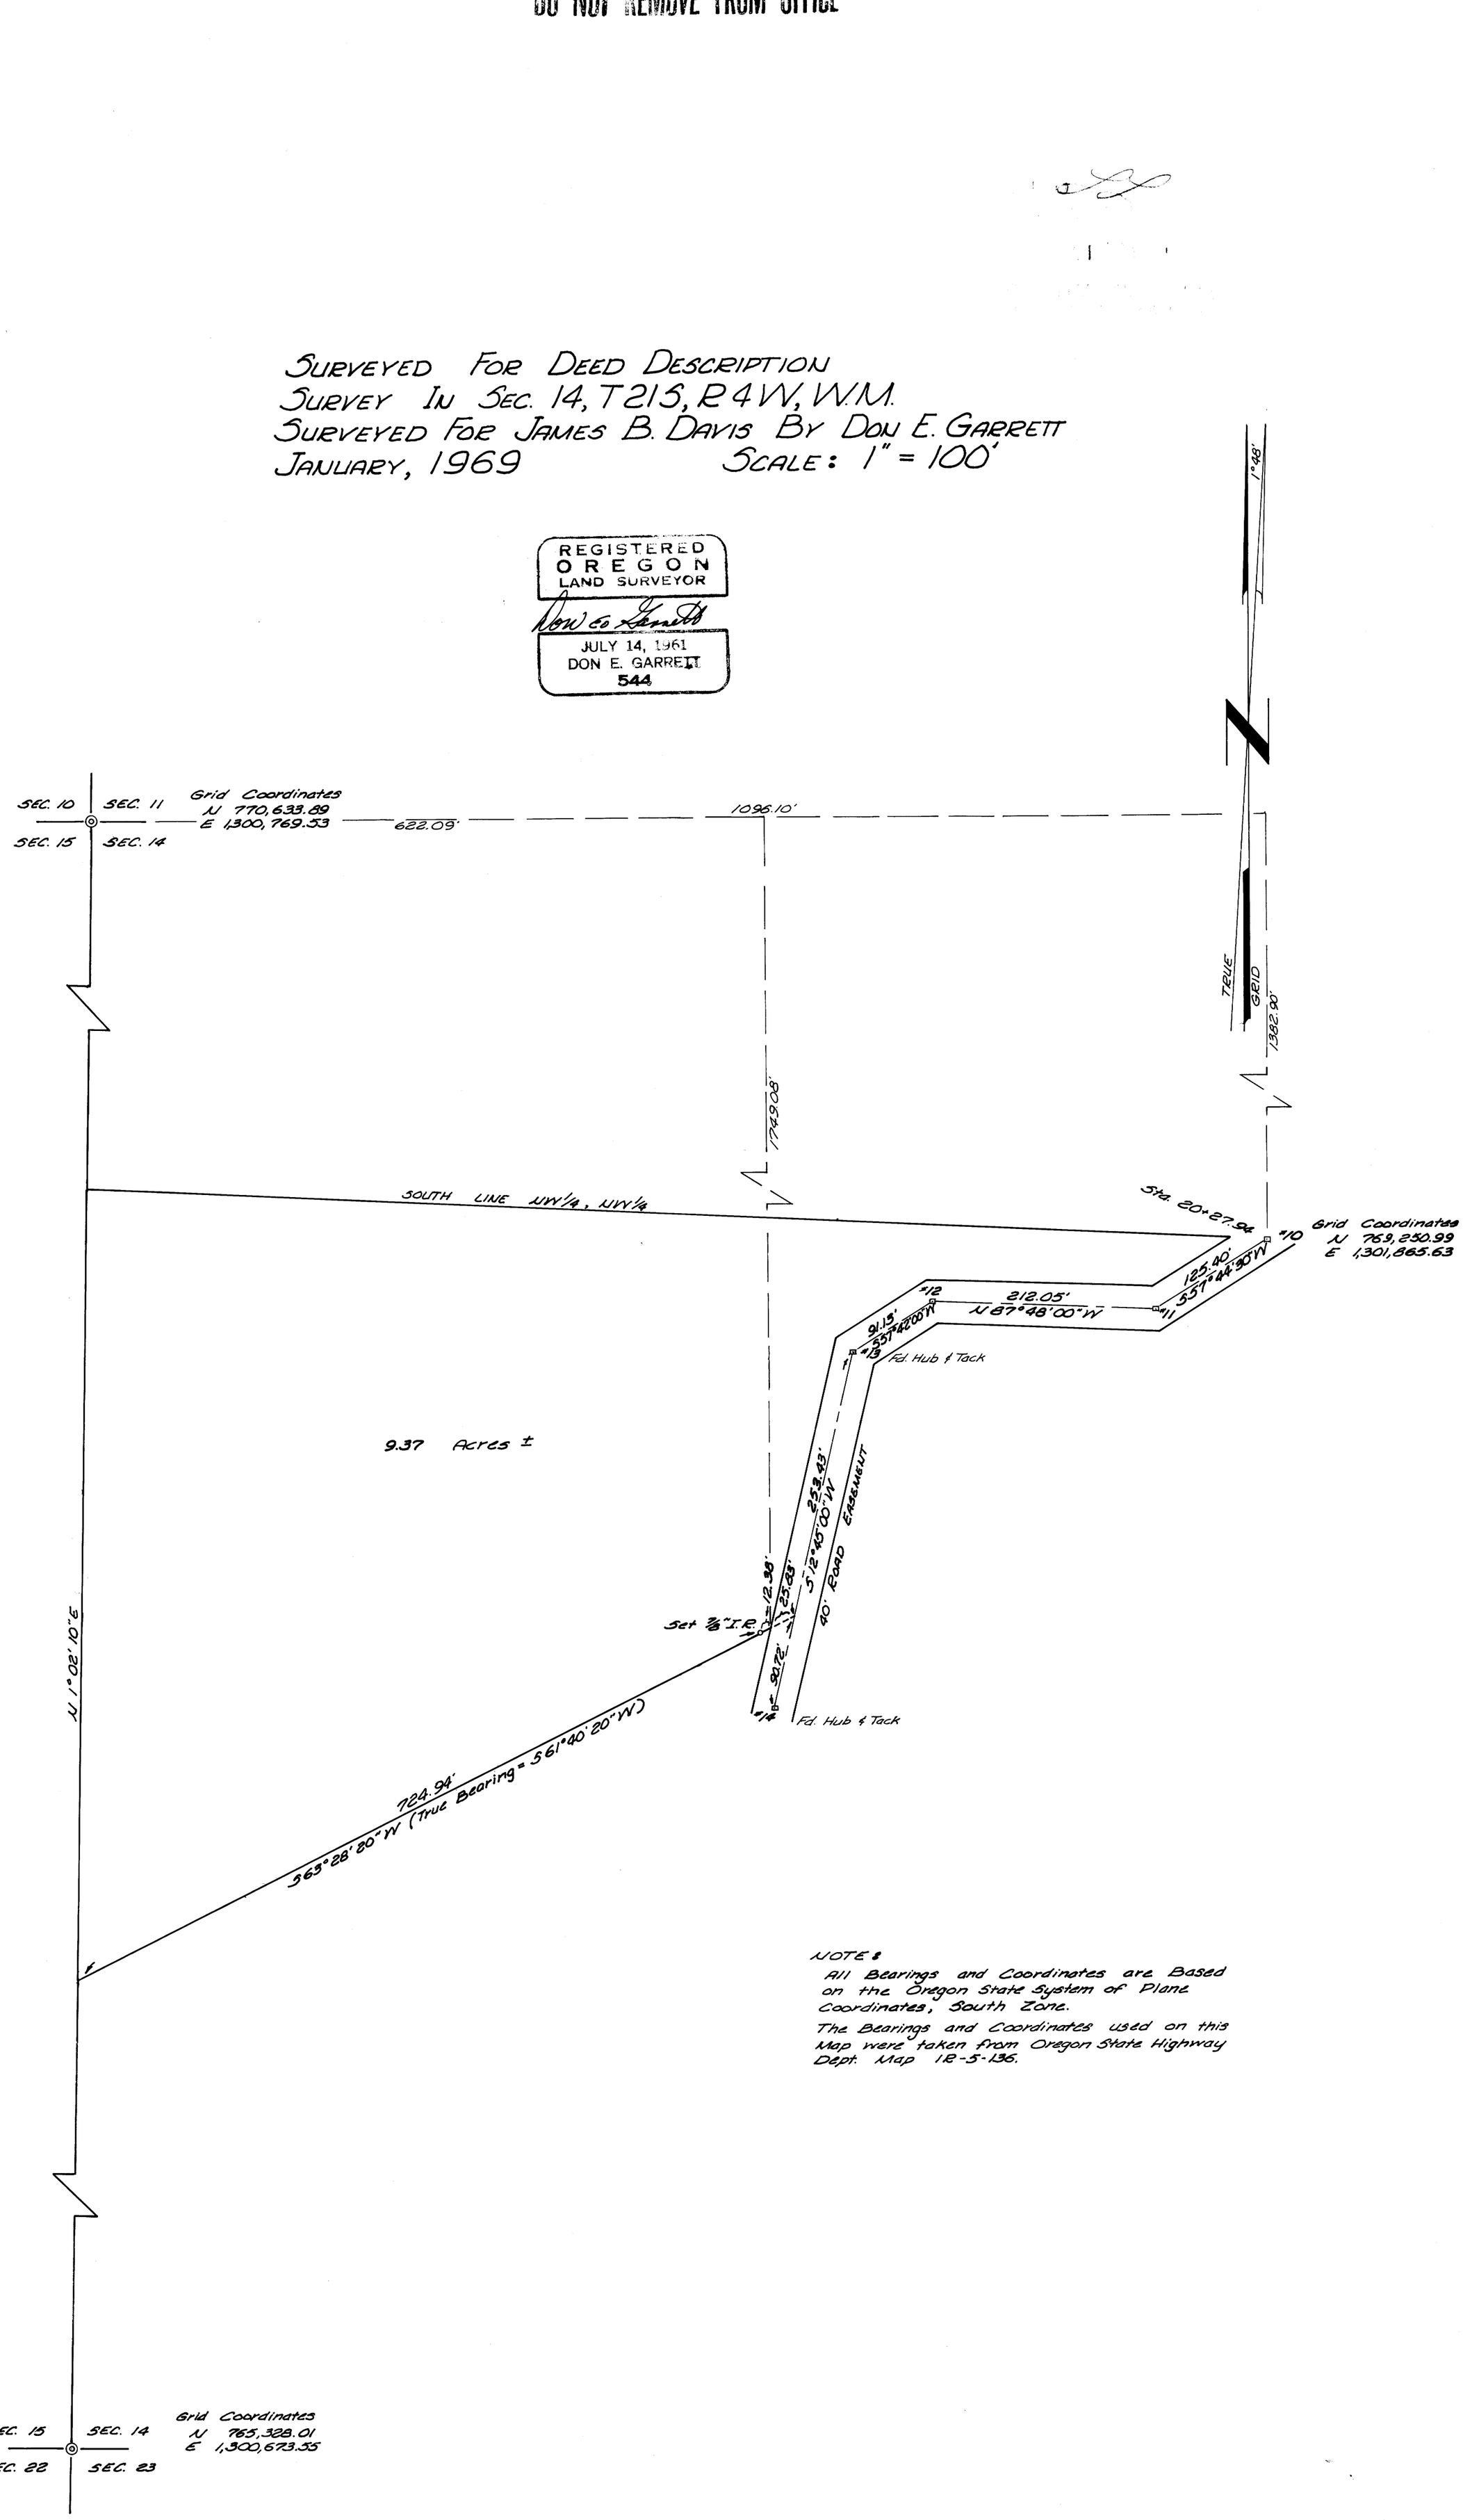

NOTE:
All Bearings and Coordinates are Based on the Oregon State System of Plane Coordinates, South Zone.
The Bearings and Coordinates used on this Map were taken from Oregon State Highway Dept. Map 1R-5-136.

MAP FILE M37-7
P