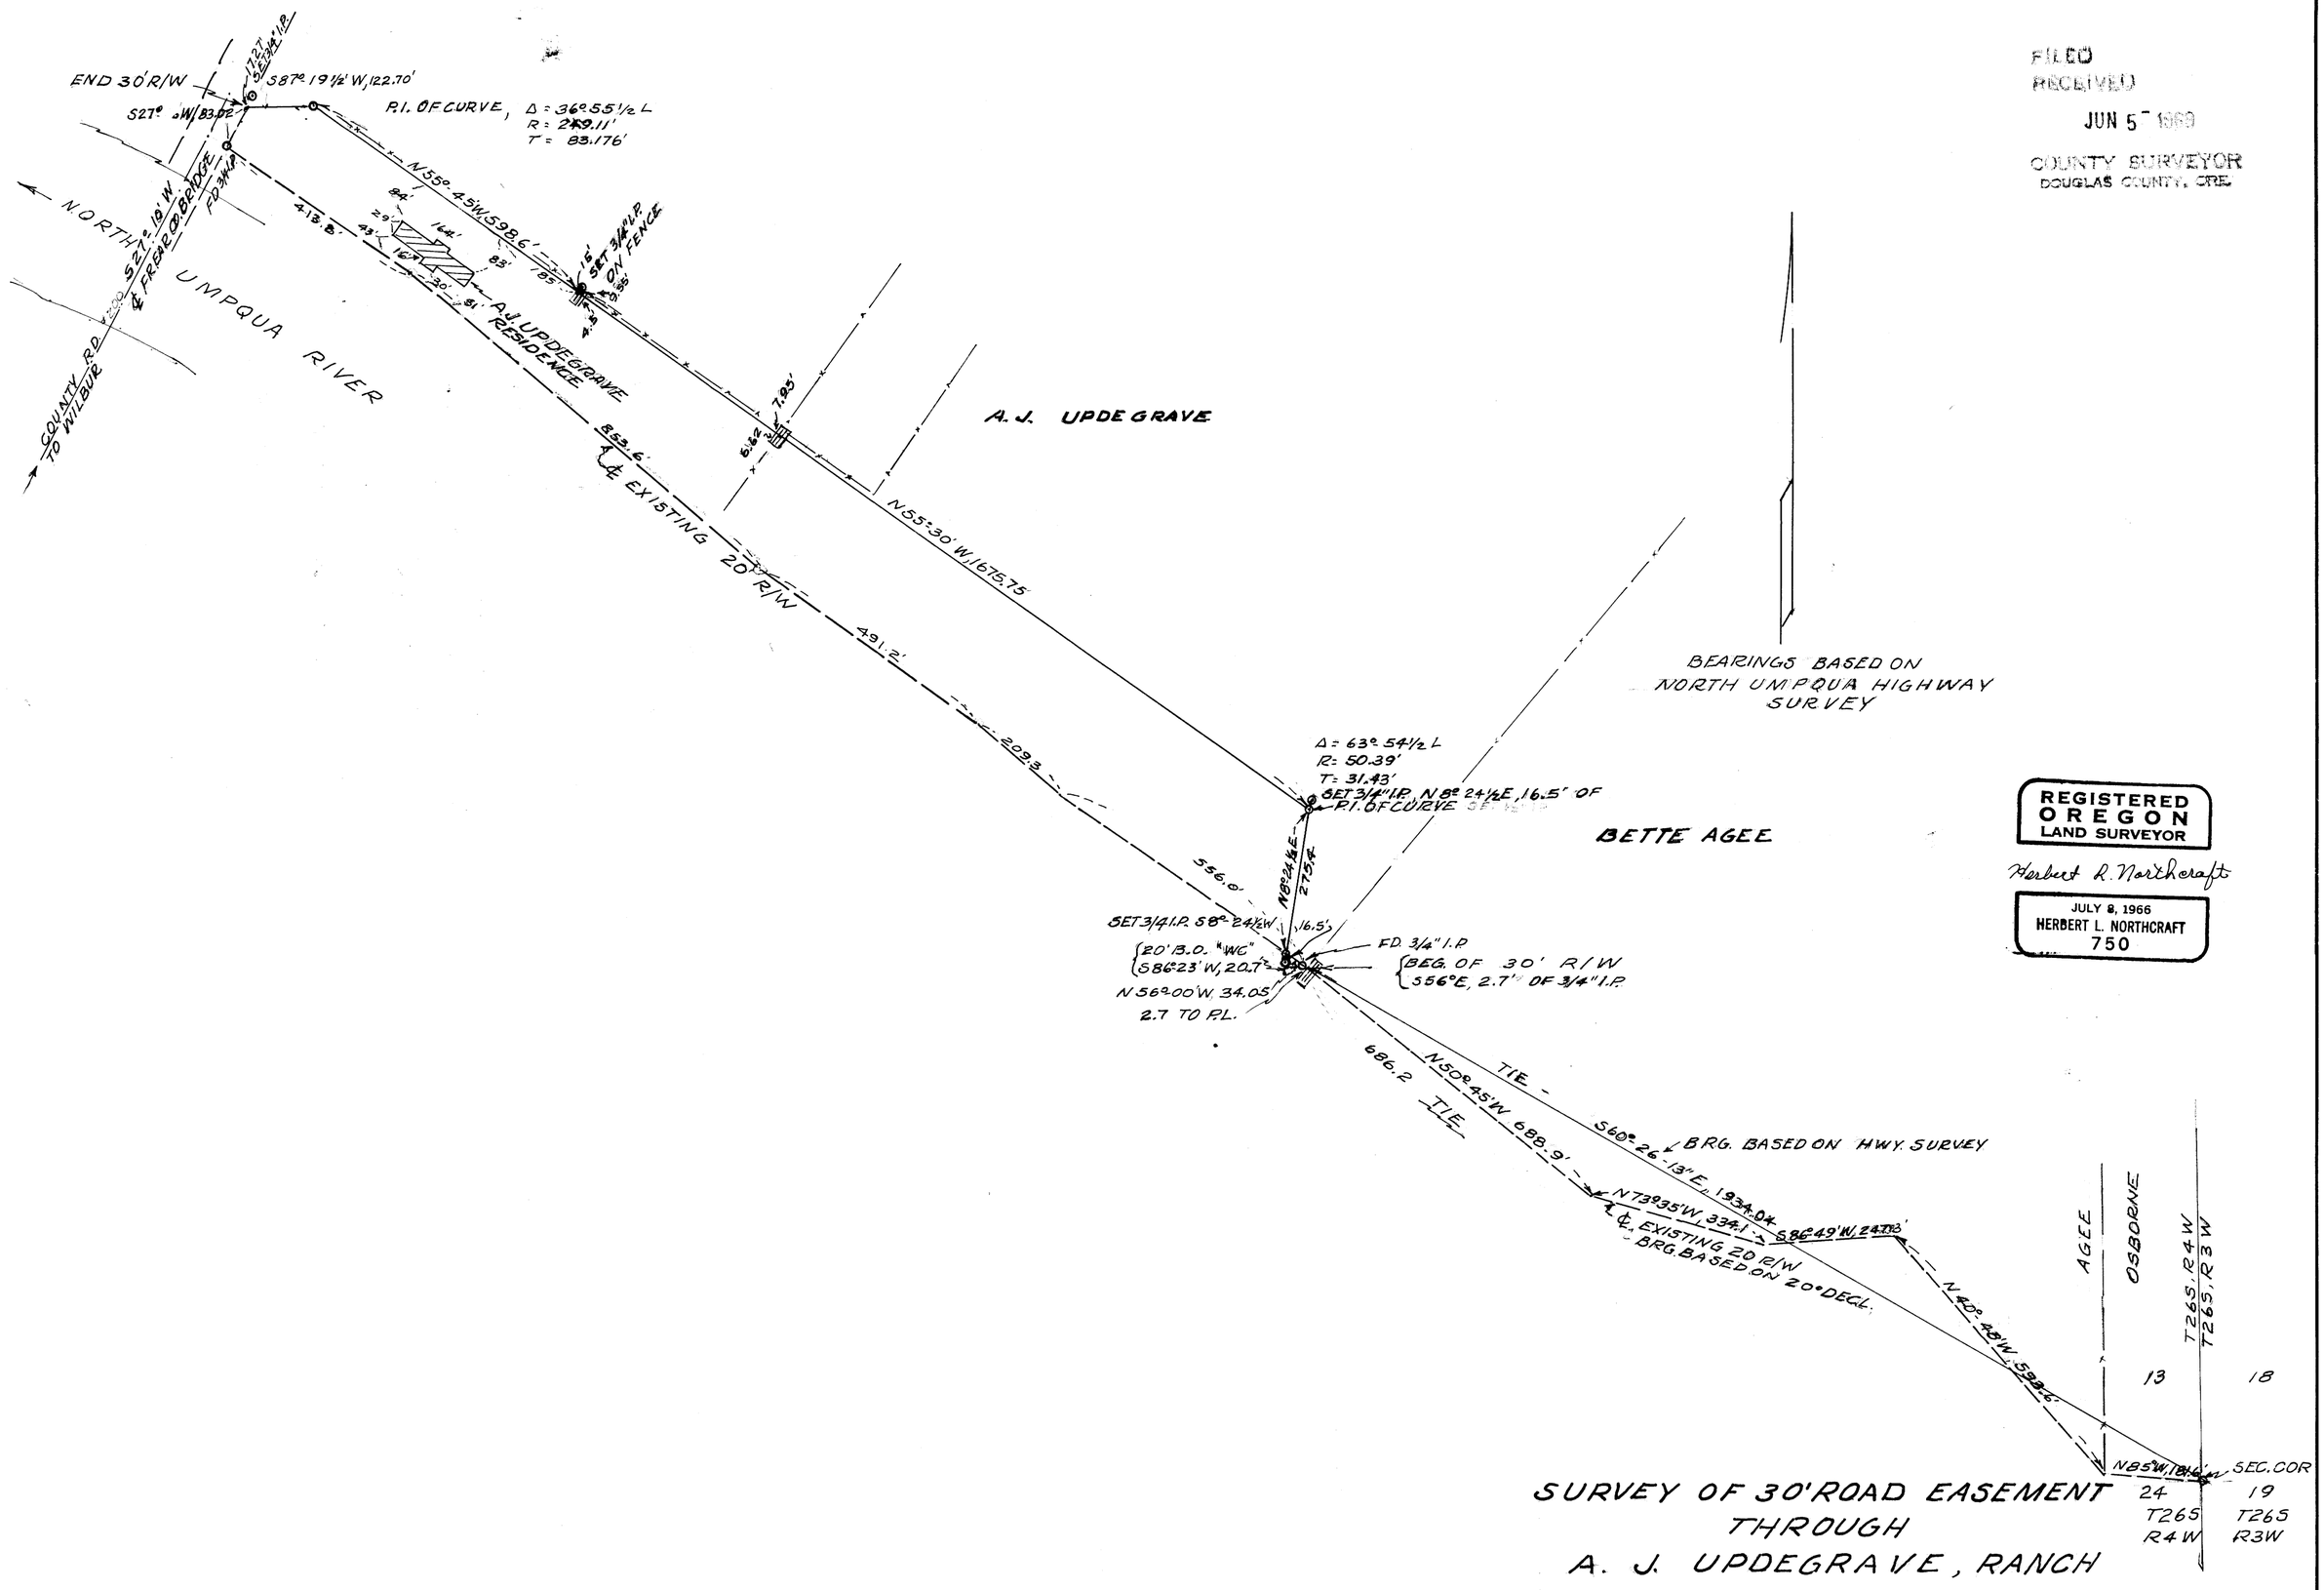

FILED
RECEIVED
JUN 5 1969
COUNTY SURVEYOR
DOUGLAS COUNTY, ORE.

MAP FILE M.37 P.78

REGISTERED OREGON LAND SURVEYOR

Herbert R. Northcraft

JULY 8, 1966
HERBERT L. NORTHCRAFT
750

SURVEY OF 30' ROAD EASEMENT
THROUGH
A. J. UPDEGRAVE, RANCH

SEC. 13 T26S, R4W, W.M.
GLIDE, DOUGLAS CO., ORE.
SCALE 1" = 200' APR. 1969

COUNTY SURVEYORS FILE DATA
DO NOT REMOVE FROM OFFICE

MAP FILE M.37 P.78