COUNTY SURVEYORS FILE DATA
DO NOT REMOVE FROM OFFICE

# SURVEY IN SECT. 30, DLC 63, T30S, R5W, W.M.

Surveyed for Do. County Road Dept. by Don E. Garrett
June 1969 Scale 1"= 40'

● - SET 5/8" I. ROD
Note: For original survey of this property see CS File 41/70.

FILED
RECEIVED
JUN 24 1969
COUNTY SURVEYOR
DOUGLAS COUNTY, ORE.

M38-14

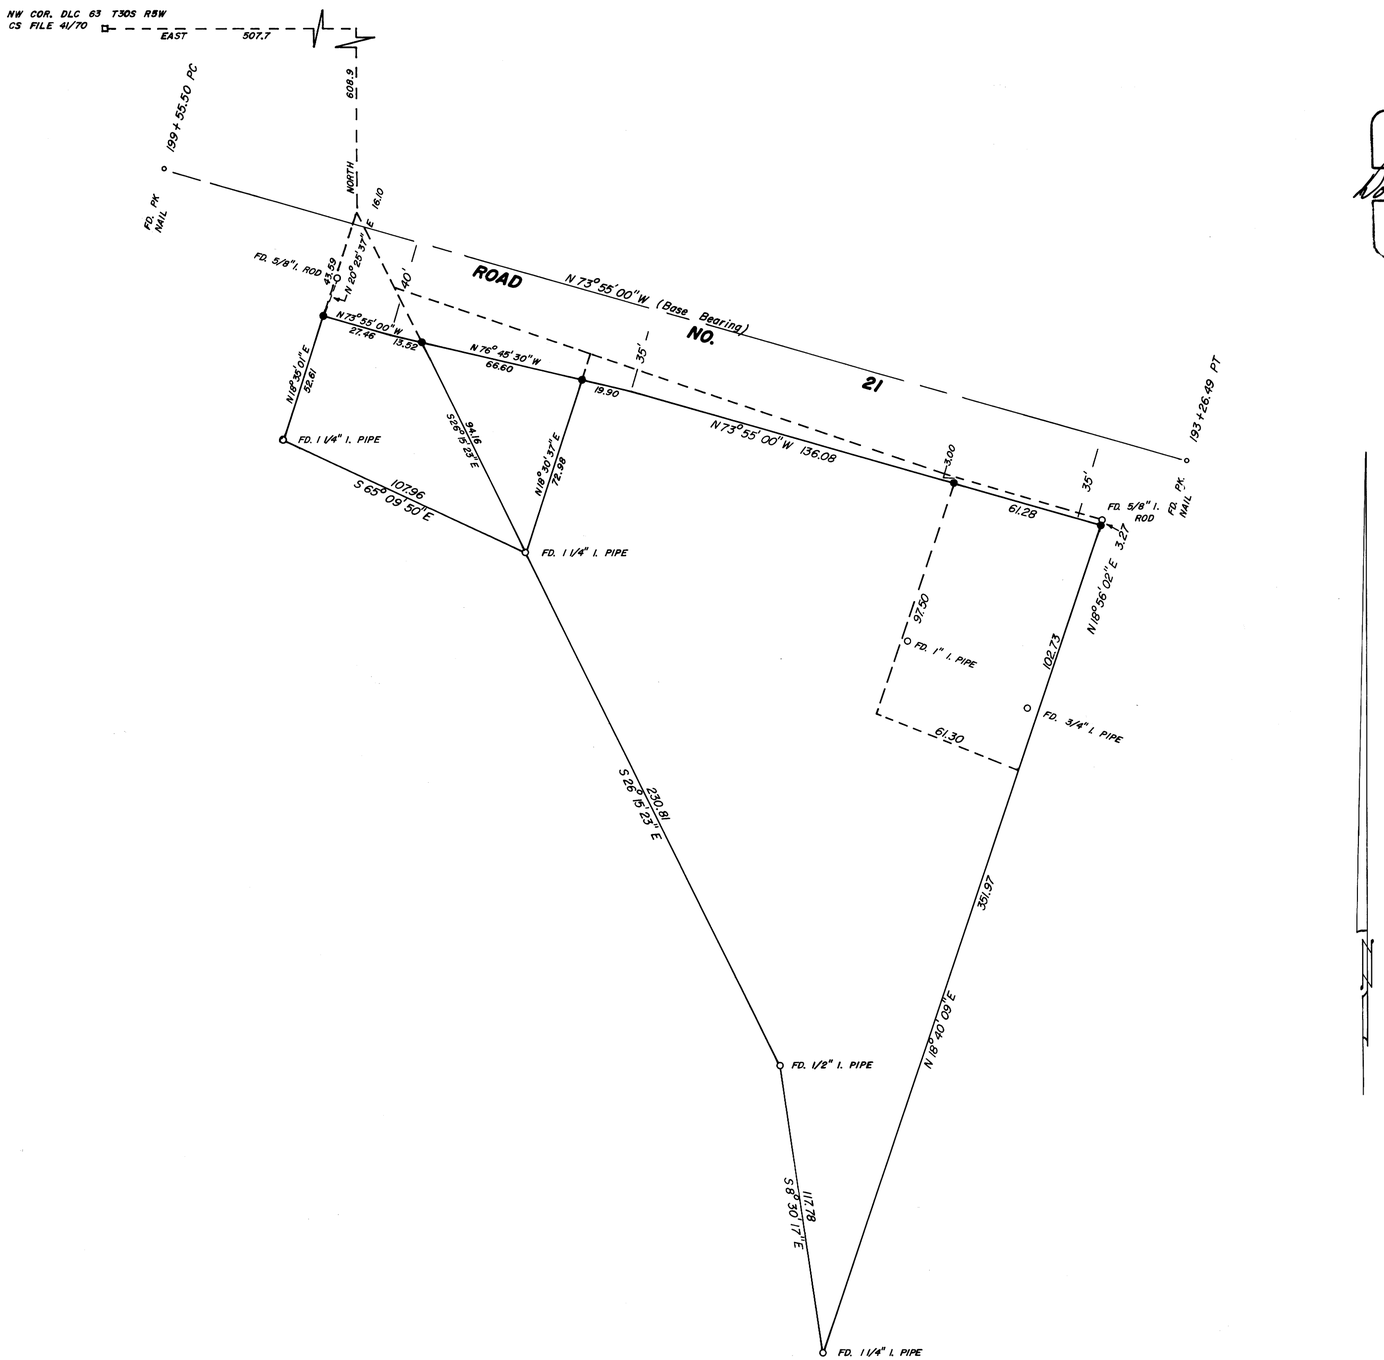


REGISTERED
OREGON
LAND SURVEYOR
Don E. Garrett
JULY 14, 1961
DON E. GARRETT
544

P
M38-14