COUNTY SURVEYORS FILE DATA
DO NOT REMOVE FROM OFFICE

FILED
RECEIVED
JUL 2
COUNTY SURVEYOR
DOUGLAS COUNTY, ORE.

SURVEY IN SECT. 1, TOWNSHIP 27 SOUTH, RANGE 7 WEST, WILLAMETTE MERIDIAN
Surveyed for The Douglas County Road Dept. by Don E. Garrett
June 1969

Scale 1 = 100'

O - SET 5/8" I. ROD

REGISTERED
OREGON
LAND SURVEYOR
Don E. Garrett
JULY 14, 1961
DON E. GARRETT
544

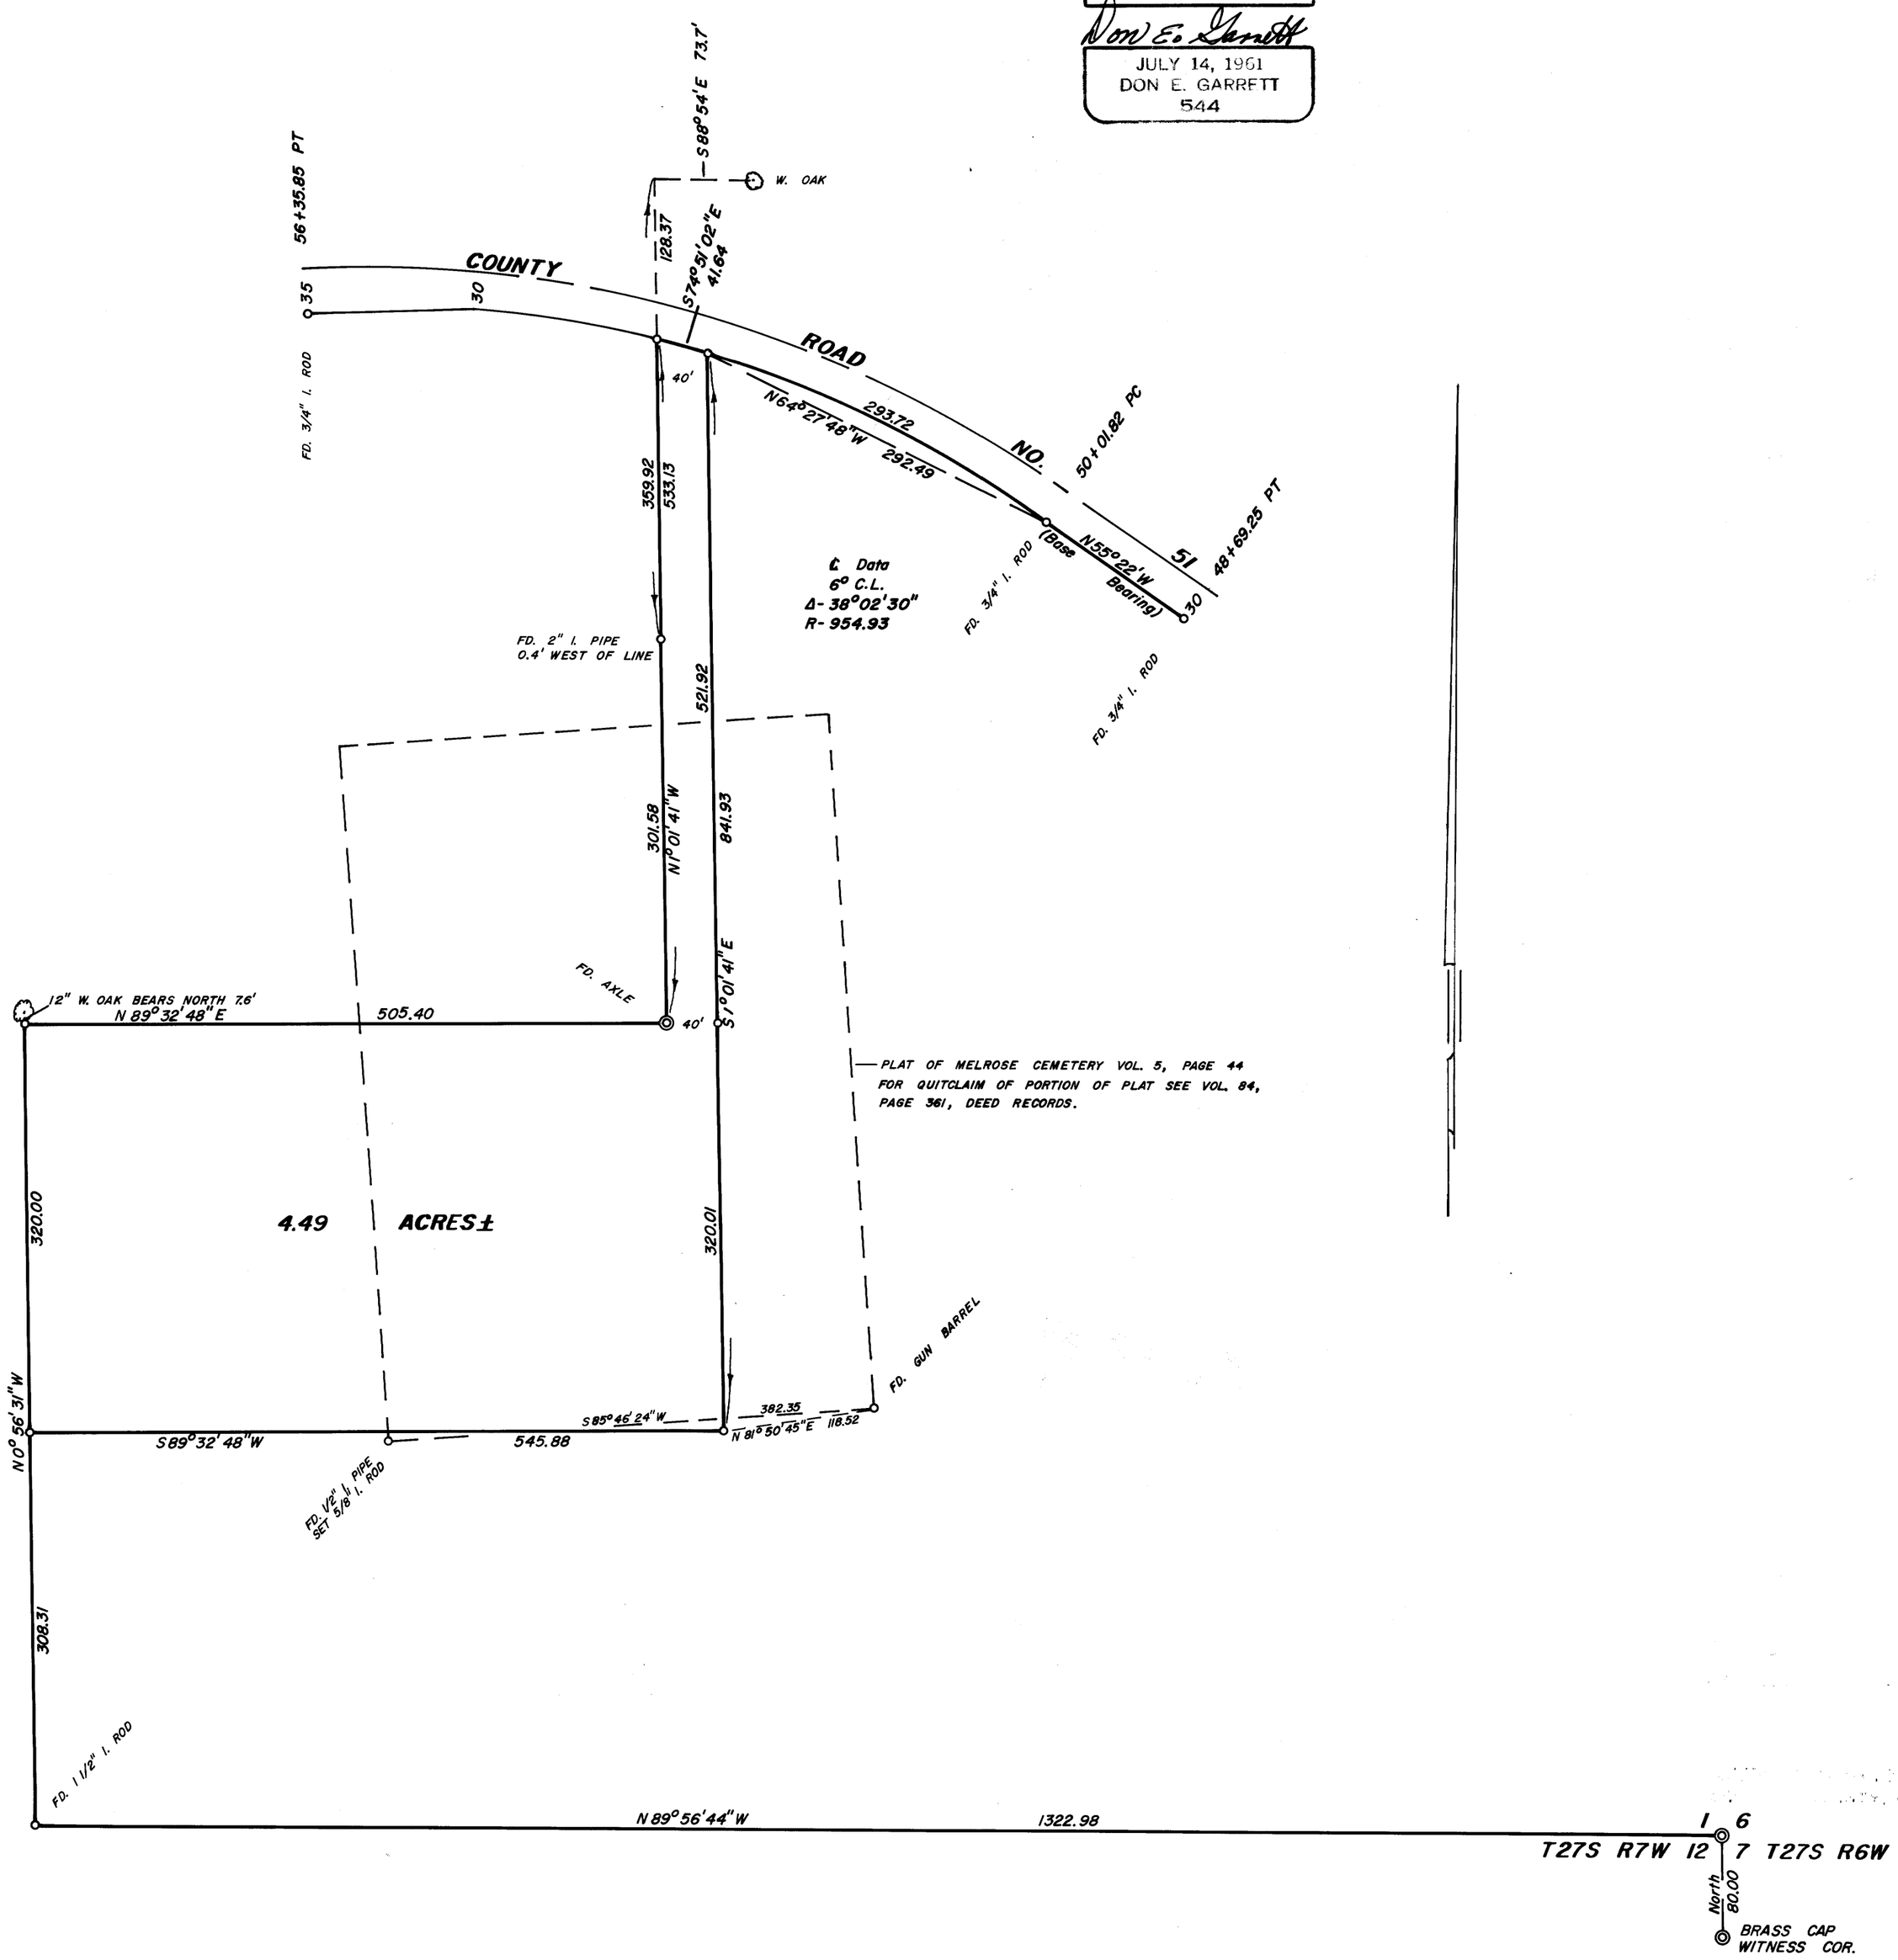

MAP FILE M38-17