COUNTY SURVEYORS FILE DATA
DO NOT REMOVE FROM OFFICE

FILED
RECEIVED
JUL 1 1969
COUNTY SURVEYOR
DOUGLAS COUNTY, OREGON

SURVEY IN LOT 4, TOWER SUBDIVISION & IN LOT 5, GLEN D. HART TRACT

SURVEYED FOR HAYWARD REED
SURVEYED BY DON E. GARRETT
JUNE, 1969 SCALE: 1" = 30'

○— DENOTES SET 5/8" IRON ROD
SEE PLAT OF TOWER SUBDIVISION (VOL. 10, PAGE 3) FOR BASE BEARING

REGISTERED
OREGON
LAND SURVEYOR
Don E. Garrett
JUL 14, 1961
DON E. GARRETT
944

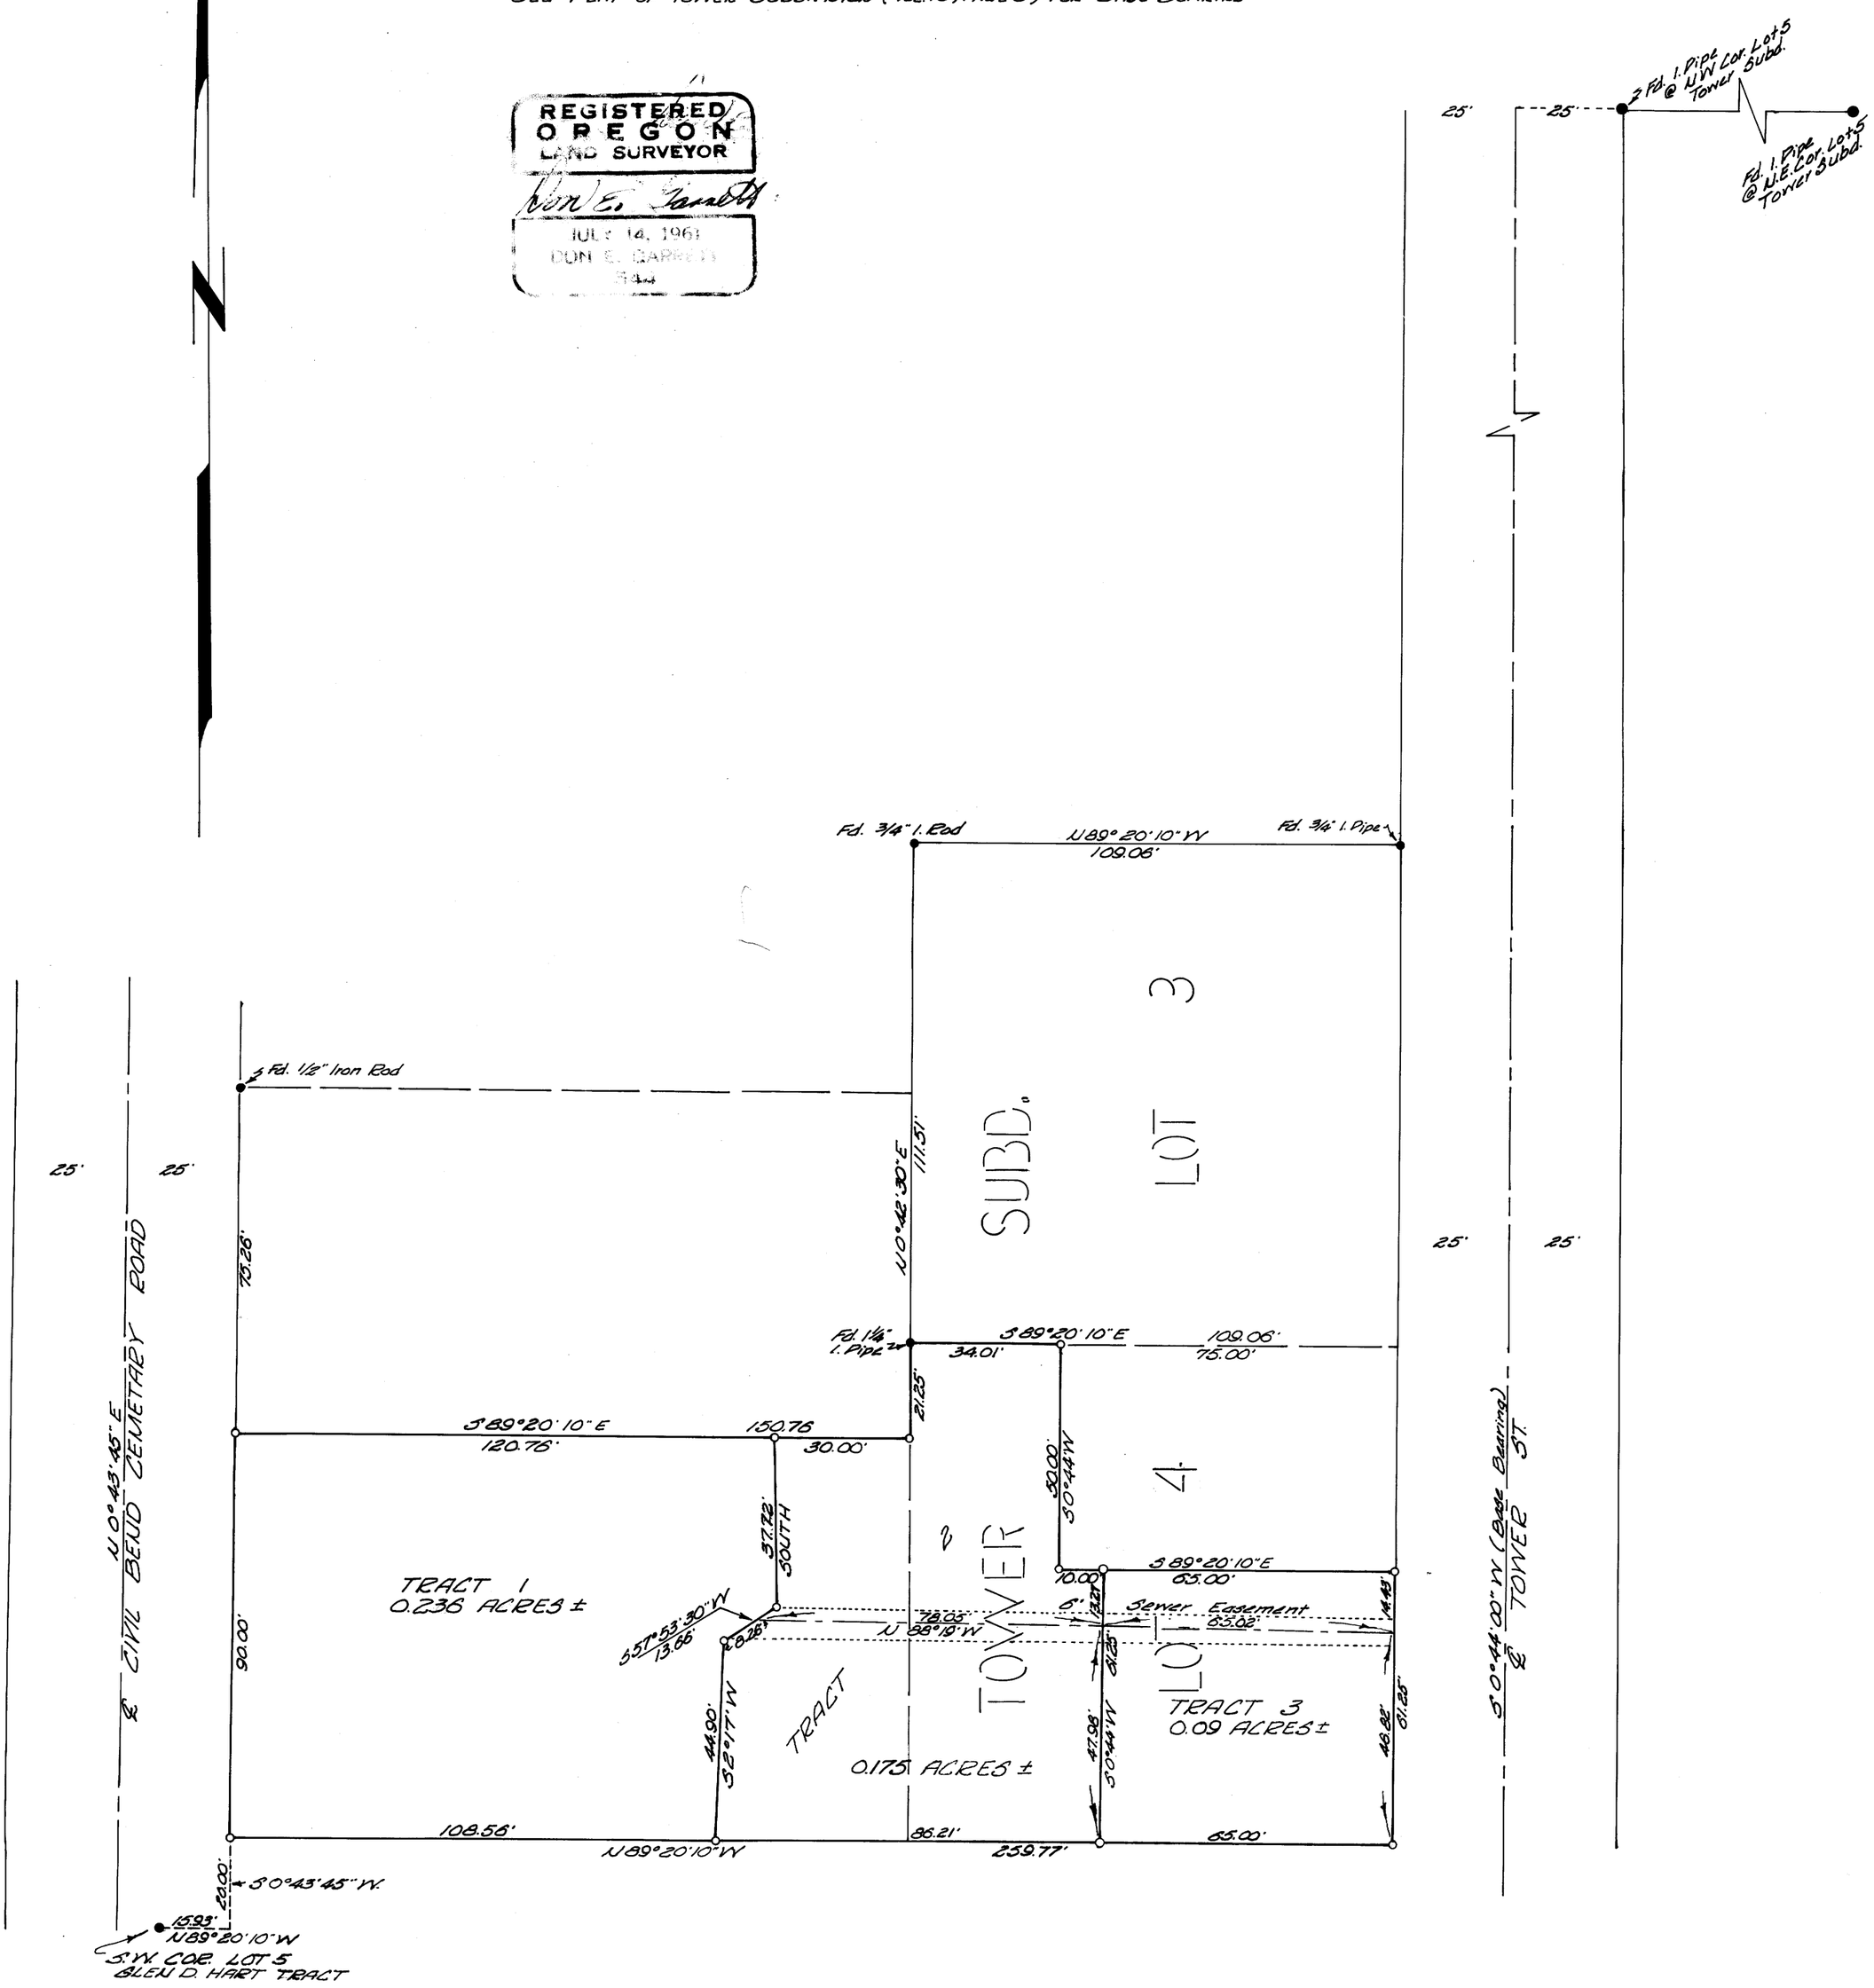

MAP FILE M38-20