M38-34

FILED
RECEIVED
AUG 18 1969
COUNTY SURVEYOR
DOUGLAS COUNTY, ORE.

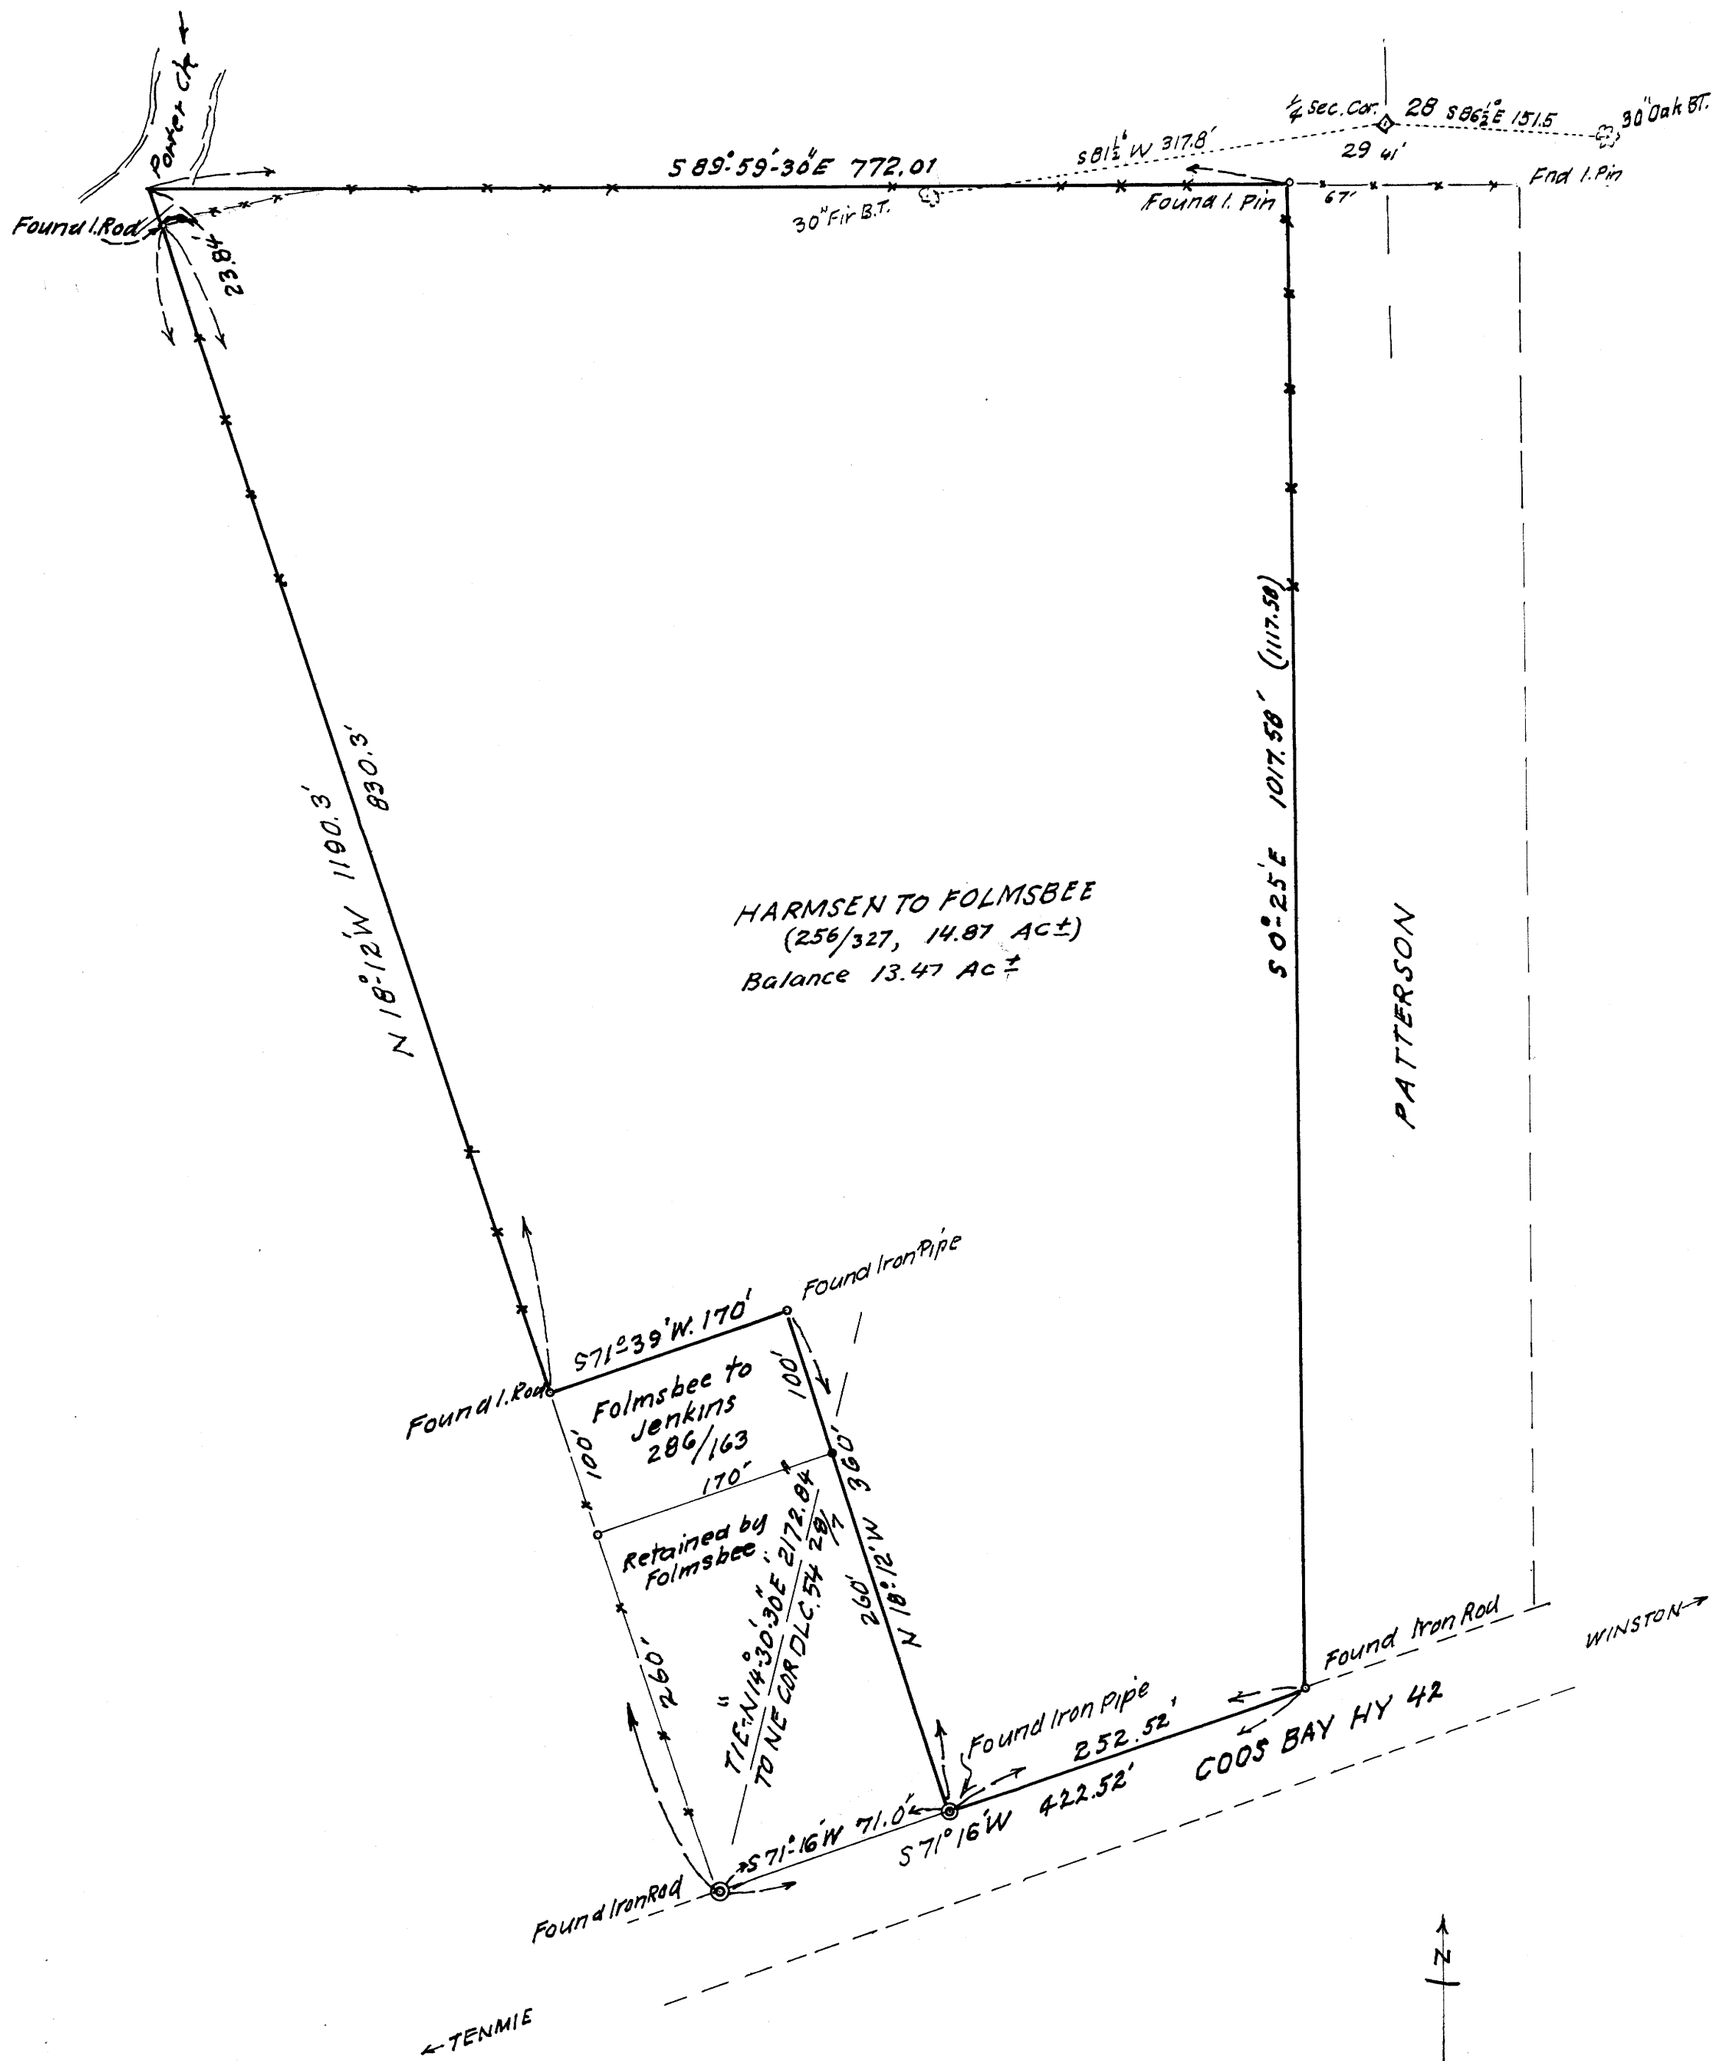

REGISTERED PROFESSIONAL ENGINEER 1981 OREGON MAY 5, 1933 ARTHUR BOYER

FOLMSBEE RANCH
1¾ MI. E. OF TENMILE P.O.
IN SE¼ SEC. 29, T28S; R7W; W.M.
DOUGLAS COUNTY, ORE.
AUG. 1969 1"=100 ft

COUNTY SURVEYORS FILE
DO NOT REMOVE FROM FILES

M38-34