SEC. COR. RESTORATION & SUBDIVISON OF SECTION 20, T.32S., R.2 W.W.M.

SURVEYED FOR THE UMPQUA NATIONAL FOREST
TILLER RANGER DISTRICT CONTRACT NO. 002440
BY BAUGHMAN & ACKARET INC. JULY 1969

SCALE: 1" = 400'

COUNTY SURVEYORS FILE
DO NOT REMOVE FROM OFFICE

FILED
RECEIVED
AUG 29 1969
COUNTY SURVEYOR
DOUGLAS COUNTY, ORE.

REGISTERED
OREGON
LAND SURVEYOR
Glenn S. Baughman
JULY 14, 1961
GLENN S. BAUGHMAN
536

◉ DENOTES SET BRASS CAP
◎ DENOTES FOUND AS SHOWN

*NOTE NO. 1 BEARING TREE TAGS PLACED ON ALL B.T.

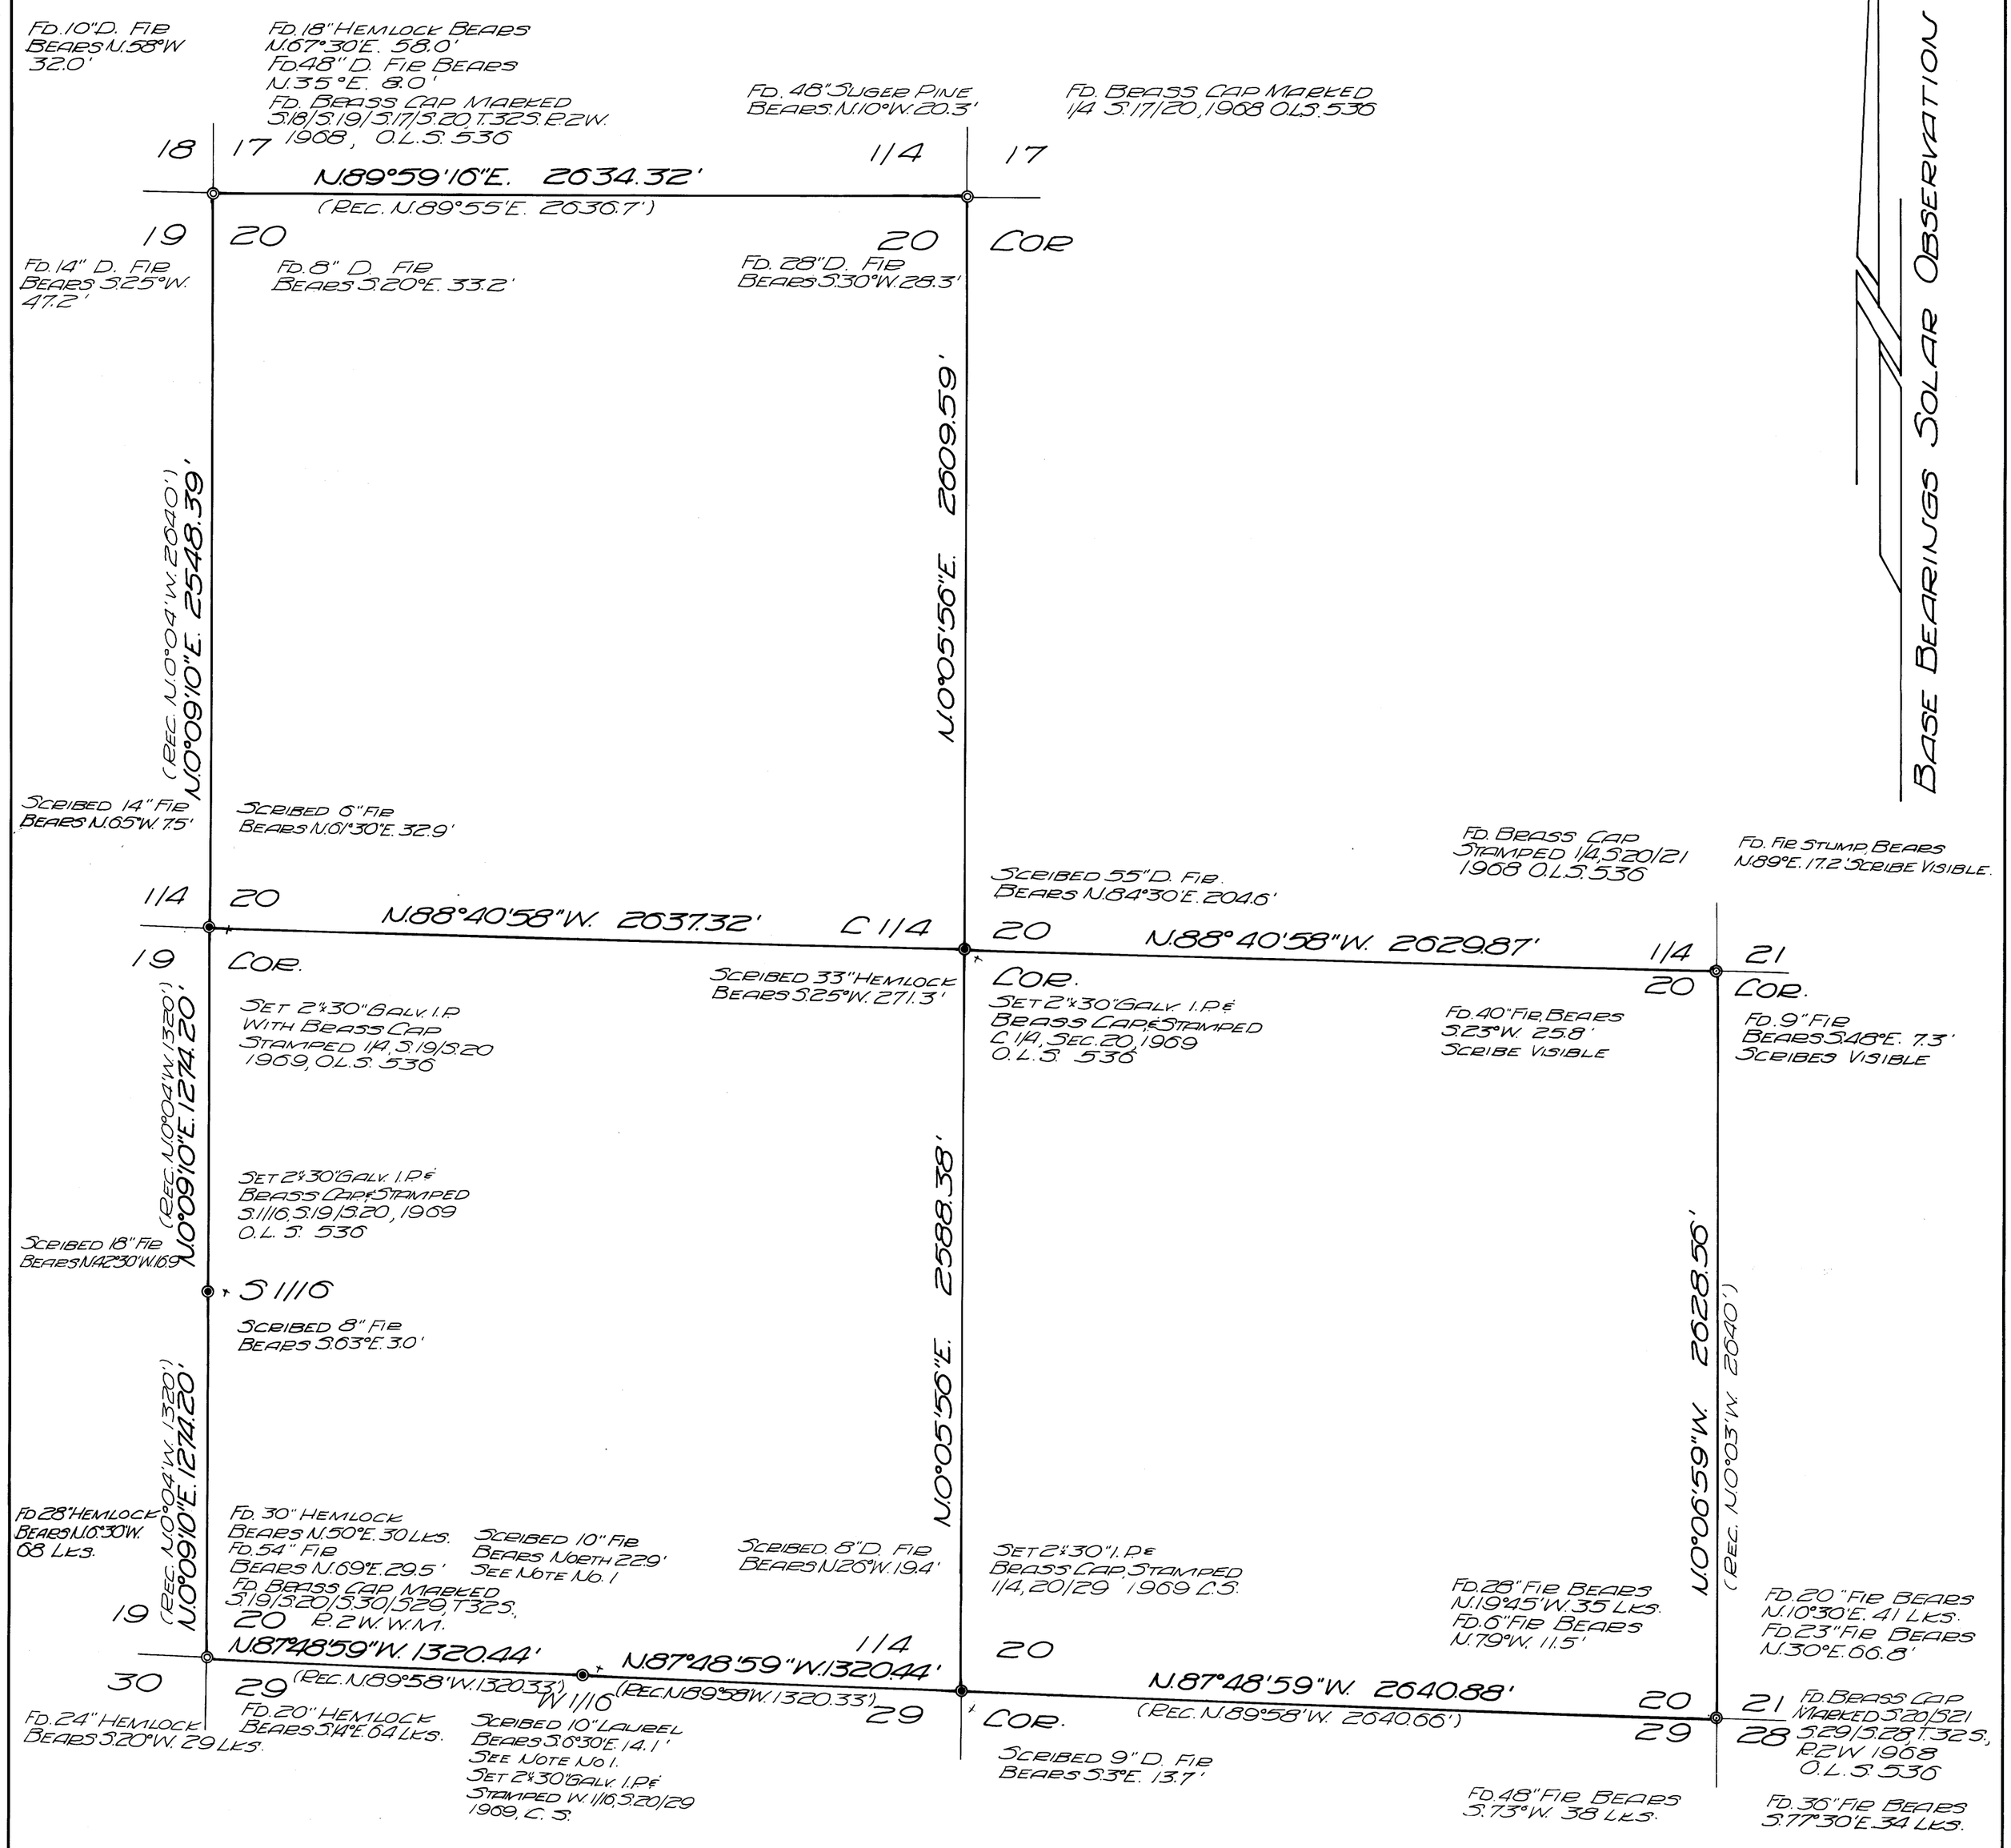

55/124

M38 - 37