FILED
RECEIVED
SEP 3 1969
COUNTY SURVEYOR
DOUGLAS COUNTY, OREG.

MAP FILE M 38-42

COUNTY SURVEYORS FILE DATA
DO NOT REMOVE FROM OFFICE

SECT 19, T.22 S., R.7 W., W.M.
city of EIKTON OREGON
Scale 1" = 100' June 1969
for
EIKTON HIGHSCHOOL

REGISTERED
OREGON
LAND SURVEYOR
Wilford N. Haines
MAY 7, 1948
WILFORD N. HAINES
239

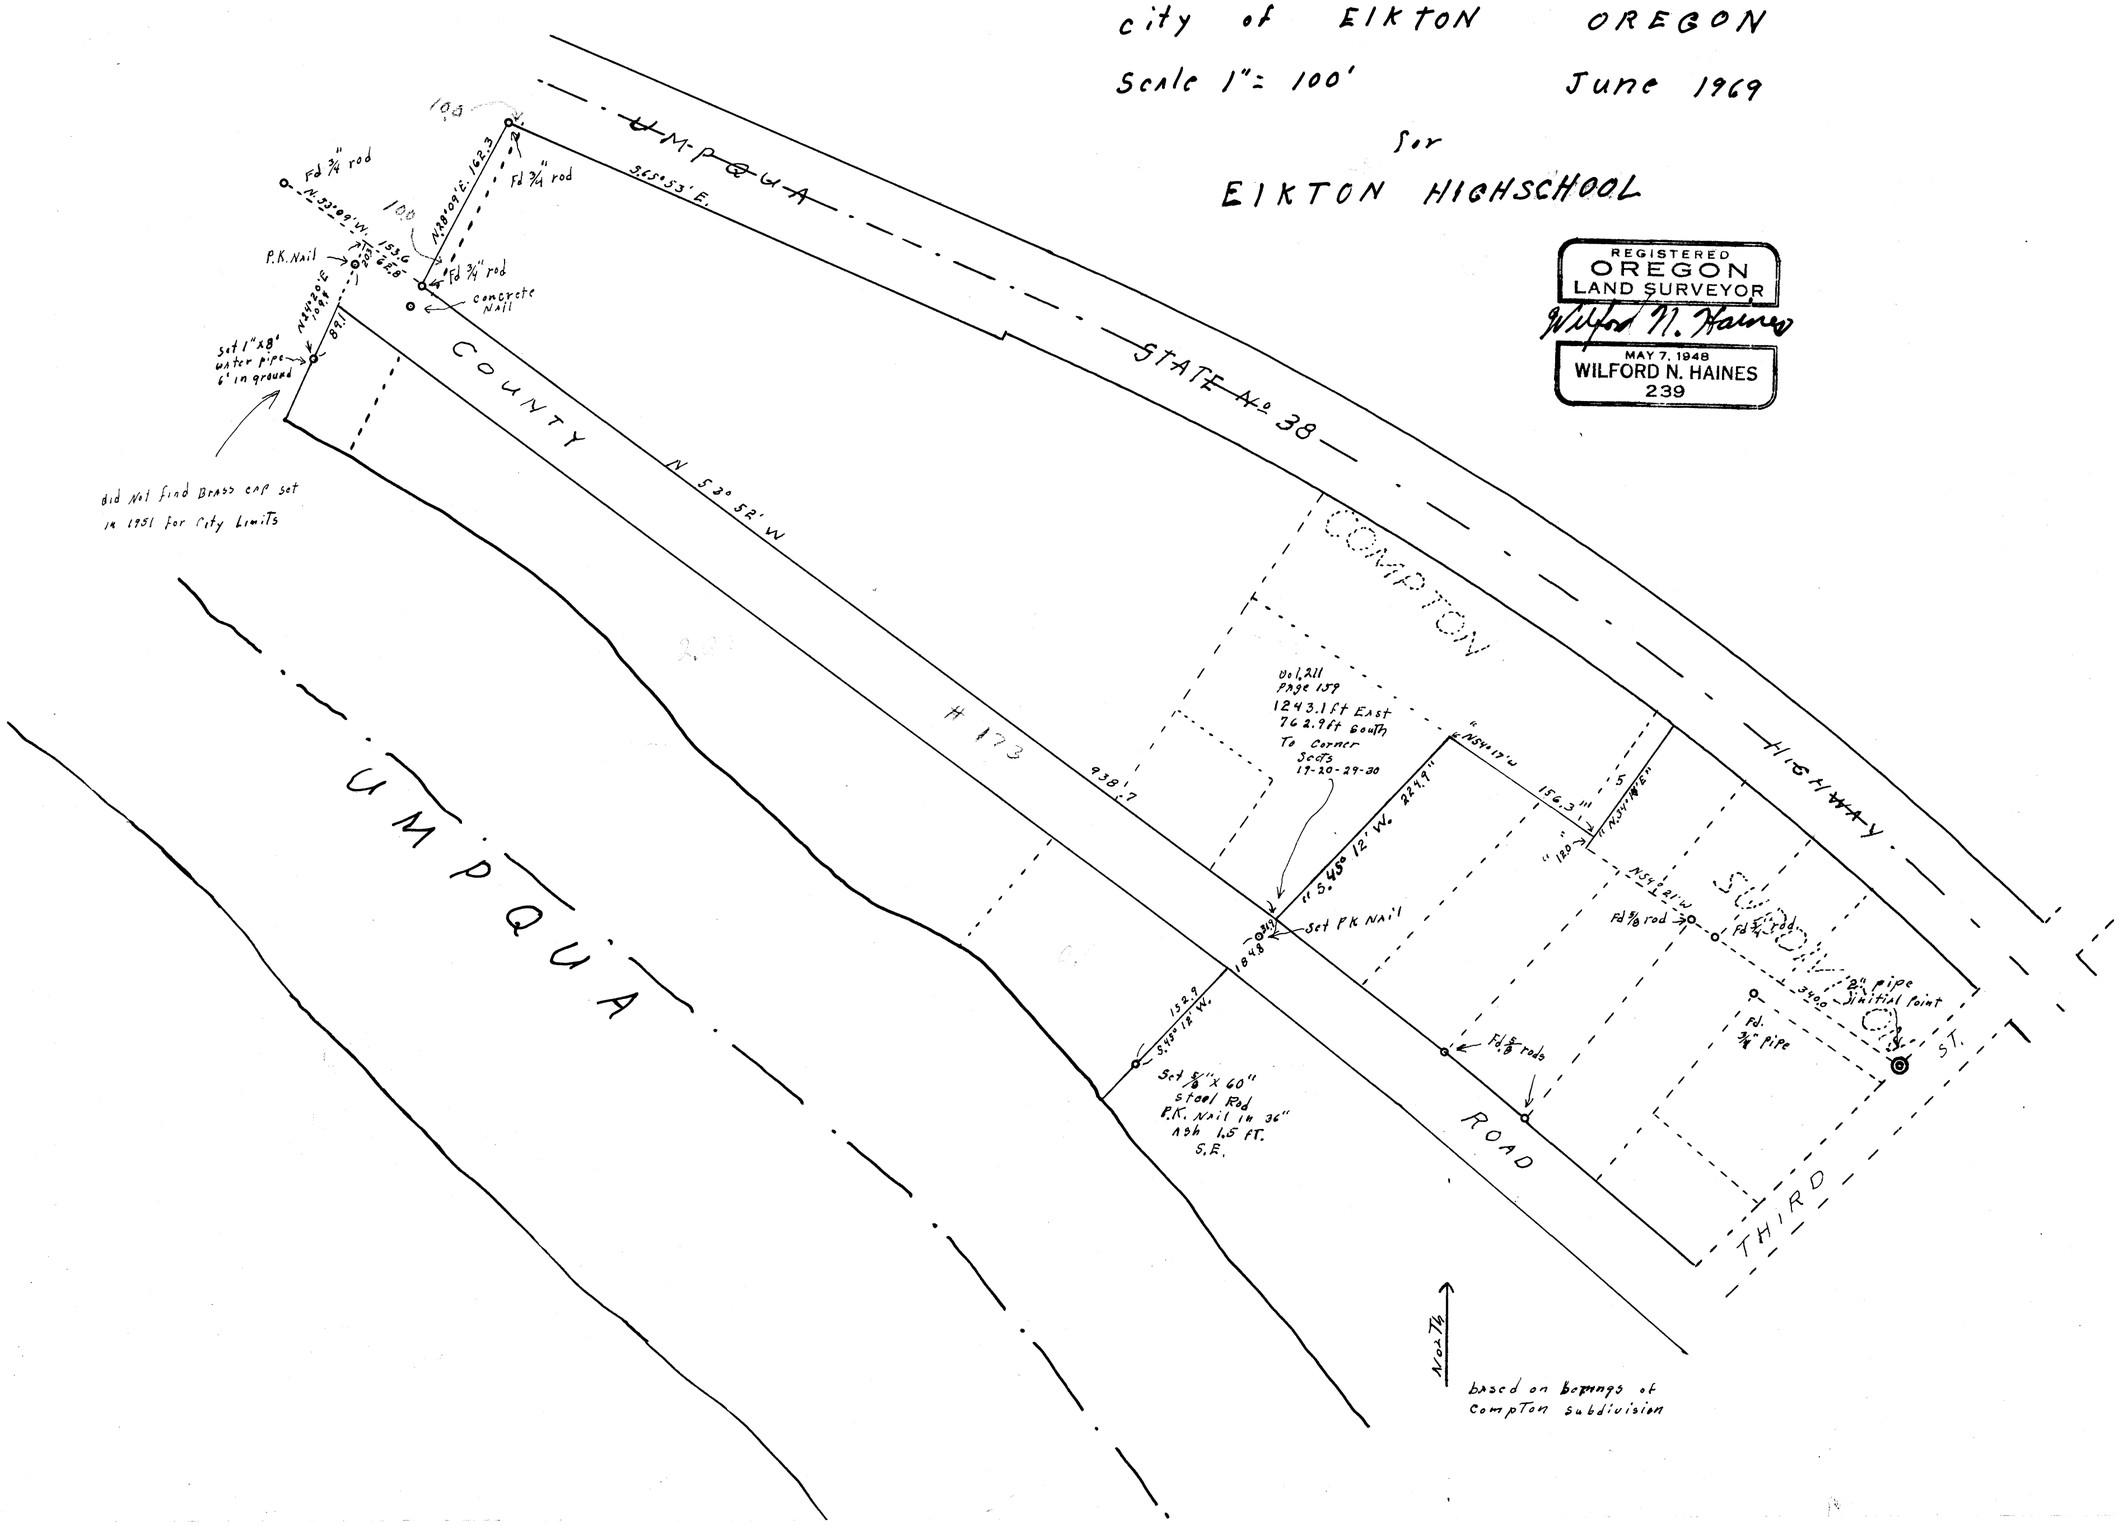

M 38 - 42