FILED
RECEIVED
SEP 30 1969
COUNTY SURVEYOR
DOUGLAS COUNTY, ORE.

M38-50

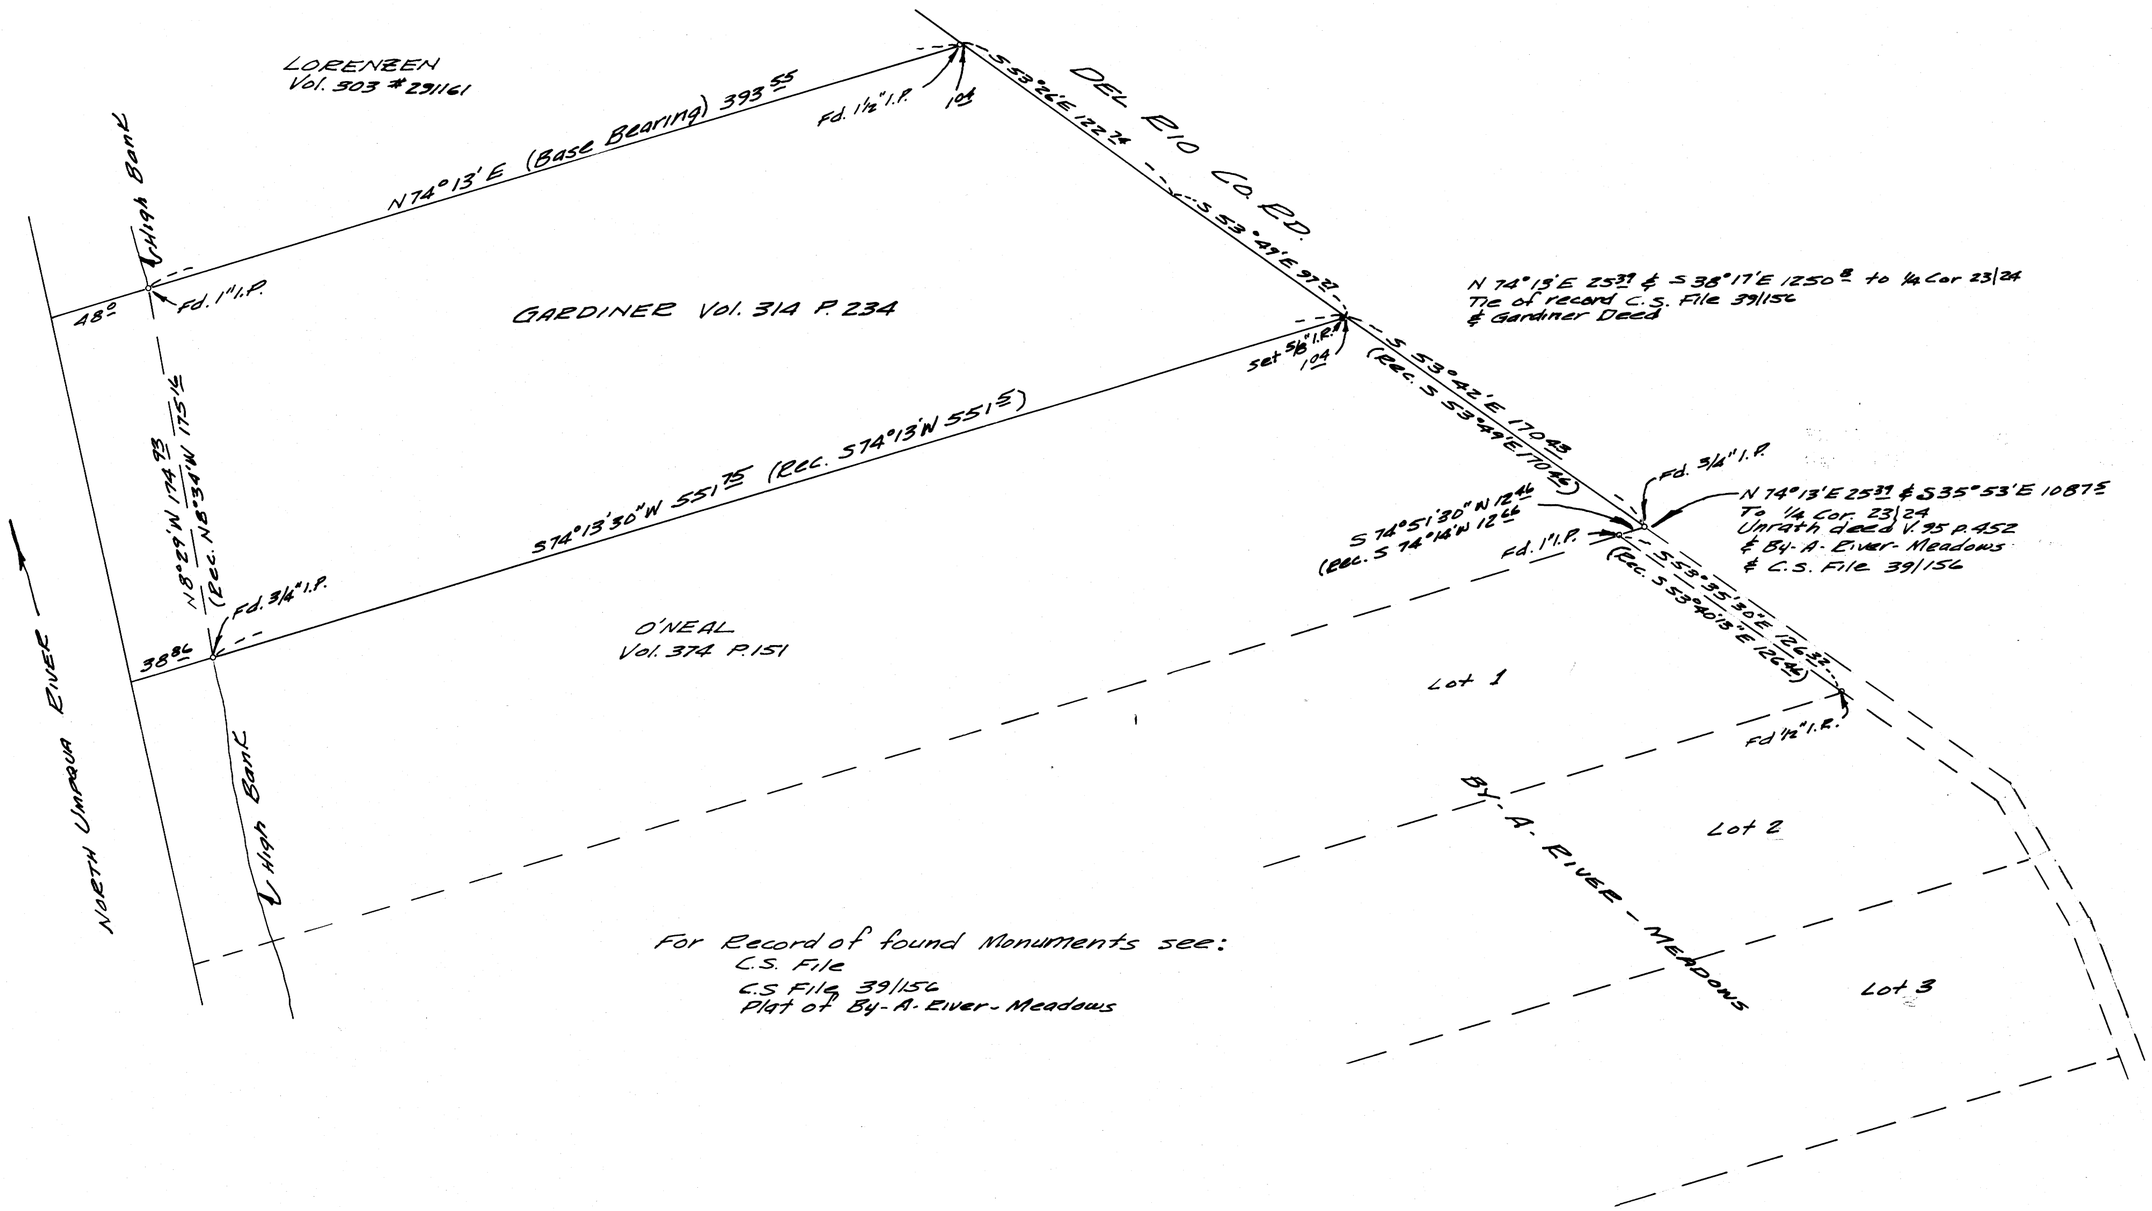

For Record of found Monuments see:
C.S. File
C.S File 39/156
Plat of By-A-River-Meadows

SURVEY TO SET PROPERTY CORNERS
IN SEC. 23, T. 26S., R. 6 W.W.M.
FOR LESTER GARDINER JR.
by BRUCE ROGERS
SEPT. 1969
1" = 50'

REGISTERED
OREGON
LAND SURVEYOR
Bruce R. Rogers
JULY 10, 1964
BRUCE R. ROGERS
660

COUNTY SURVEYORS FILE
DO NOT REMOVE FROM FILE

MAP FILE M38-50