C.S. FILE 54/95
M38-62

14 | 13
23 | 24

FD. ALL BT'S. PER RENEWAL Nº 88; SET BRASS CAP AT COR., MKD. COUNTY SURVEYOR'S OFFICE, 1969, T.26S., R.6W. S. 13, 14, 23 & 24.

NOTE: BEARINGS BASED ON COUNTY ROAD Nº 115

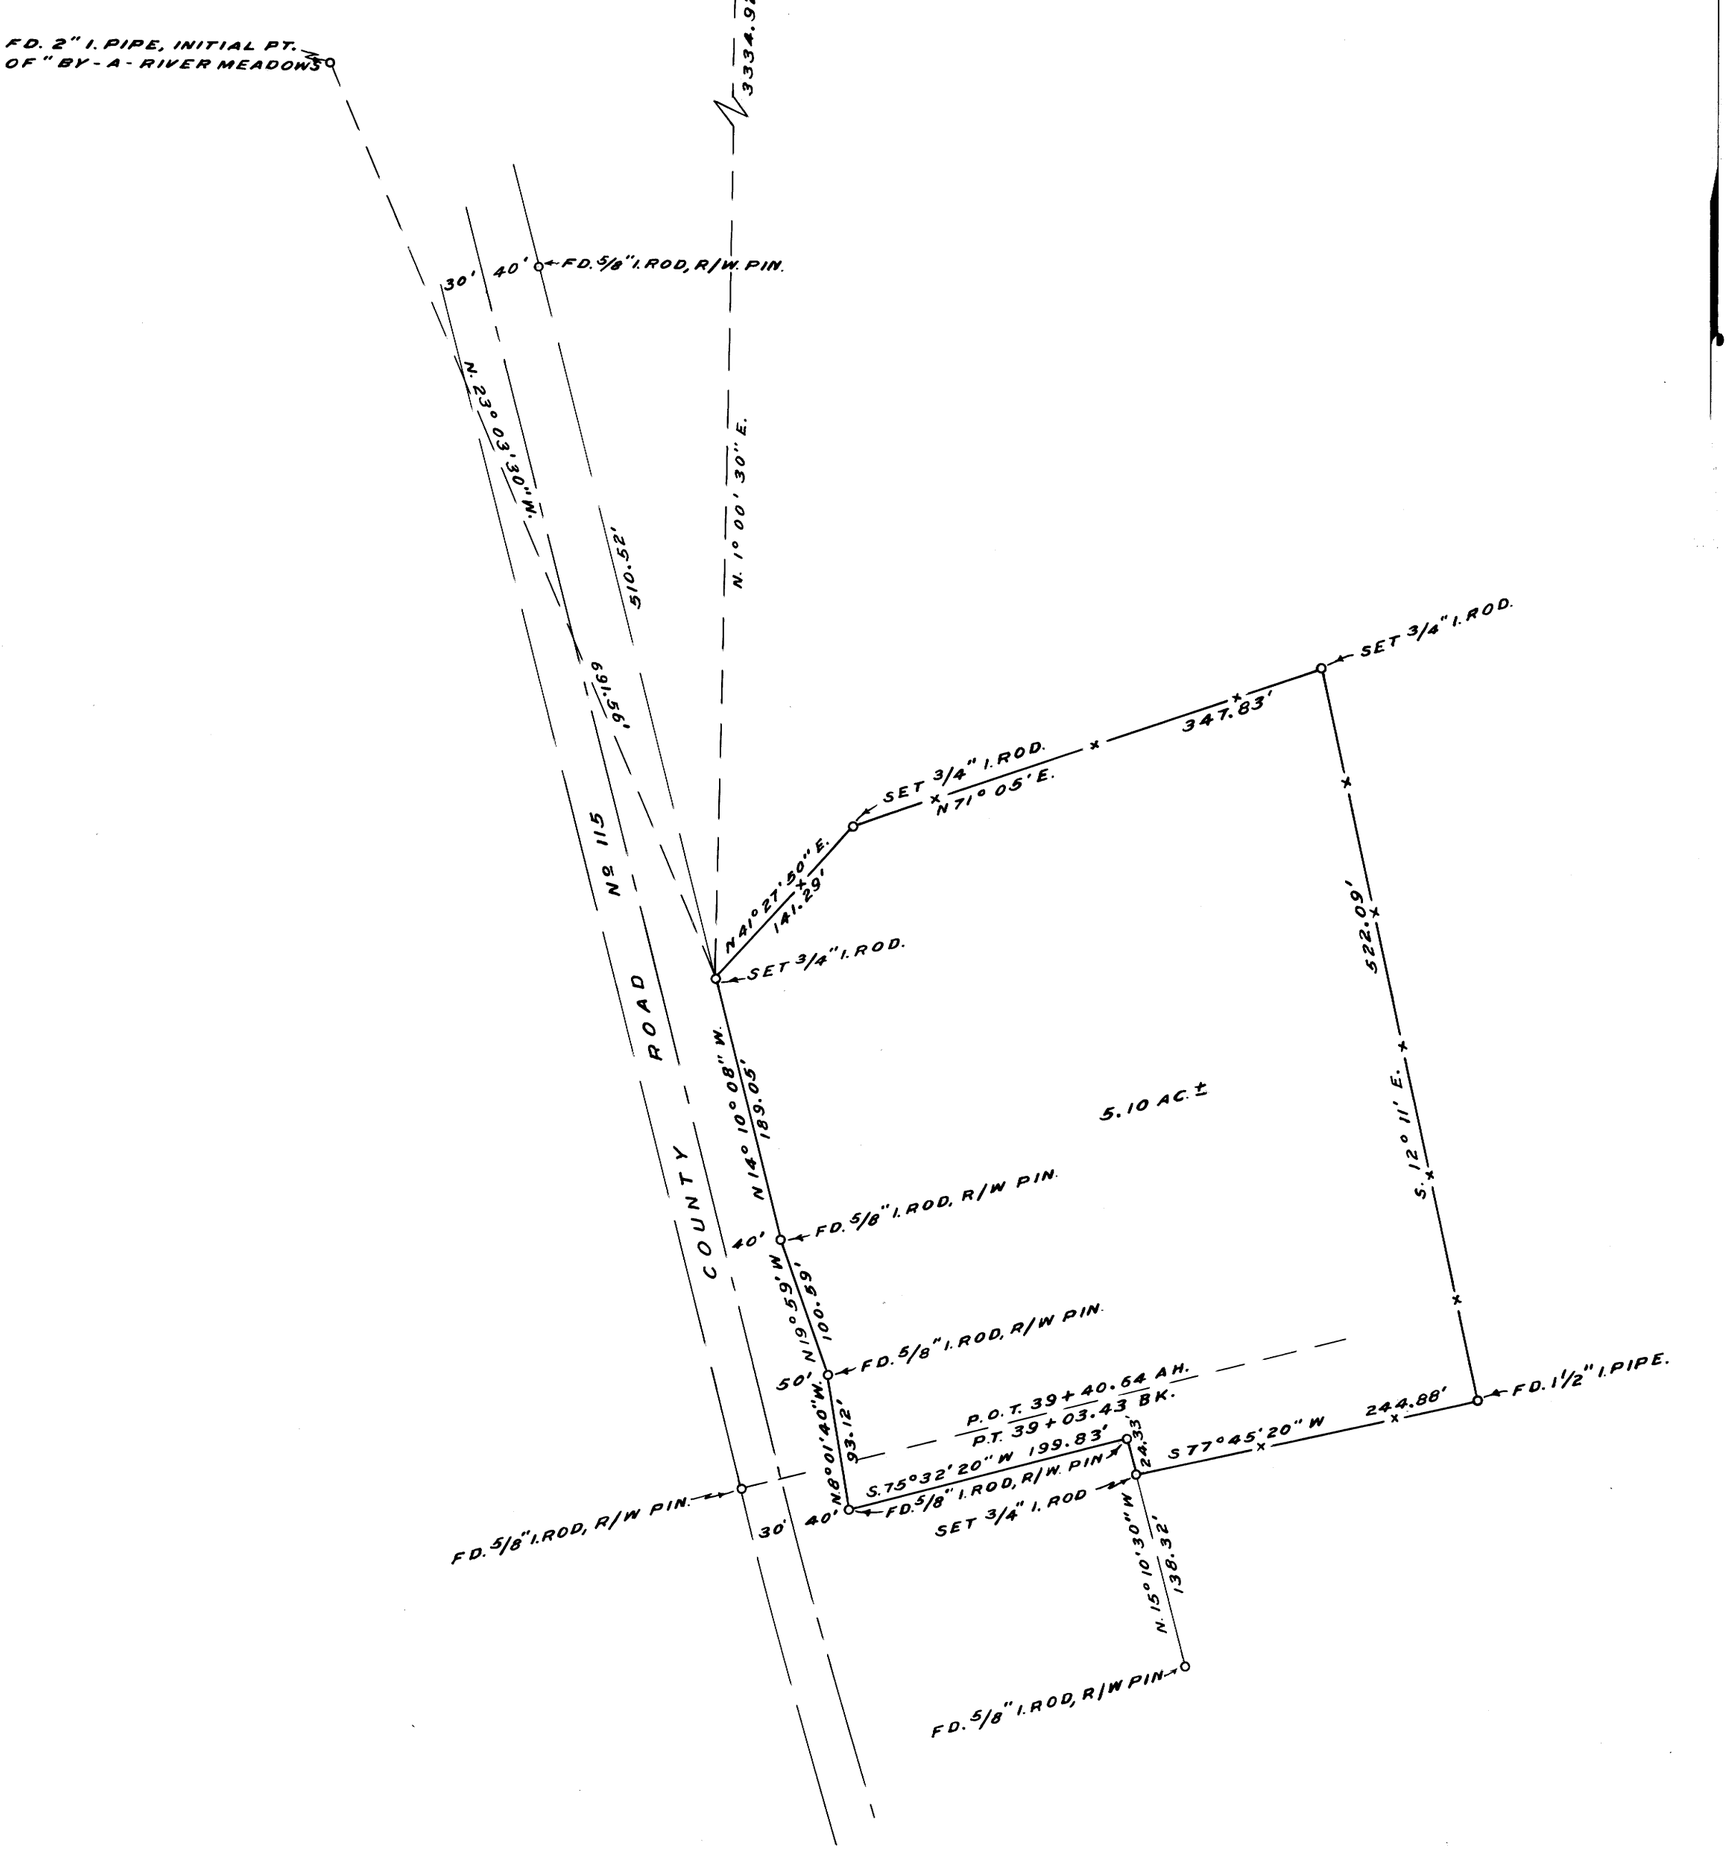

COUNTY SURVEYOR'S OFFICE
DOUGLAS COUNTY, OREGON

SURVEY TO SET PROPERTY CORNERS,
SECTION 24, T.26S., R.6W., W.M.

JAMES W. BYRON
SURVEYED NOV. 4, 1969

COUNTY SURVEYOR
SCALE 1" = 100'

SURVEYED FOR DOUGLAS COUNTY

REGISTERED
OREGON
LAND SURVEYOR

James W. Byron

NOV. 6 1969
JAMES W. BYRON
303

REMOVE FROM OFFICE

C.S. FILE 54/95
M38-62