COUNTY SURVEYORS FILE DATA
DO NOT REMOVE FROM OFFICE

FILED
RECEIVED
JUN 20 1969
COUNTY SURVEYOR
DOUGLAS COUNTY, ORE.

MAP FILE M38 p.8

SURVEY IN SECTION 16, T27S, R7W, W.M.

Surveyed for Casey Morgan by Don E. Garrett
June 1969 Scale 1" = 200'

●-Set 5/8" I. Rod

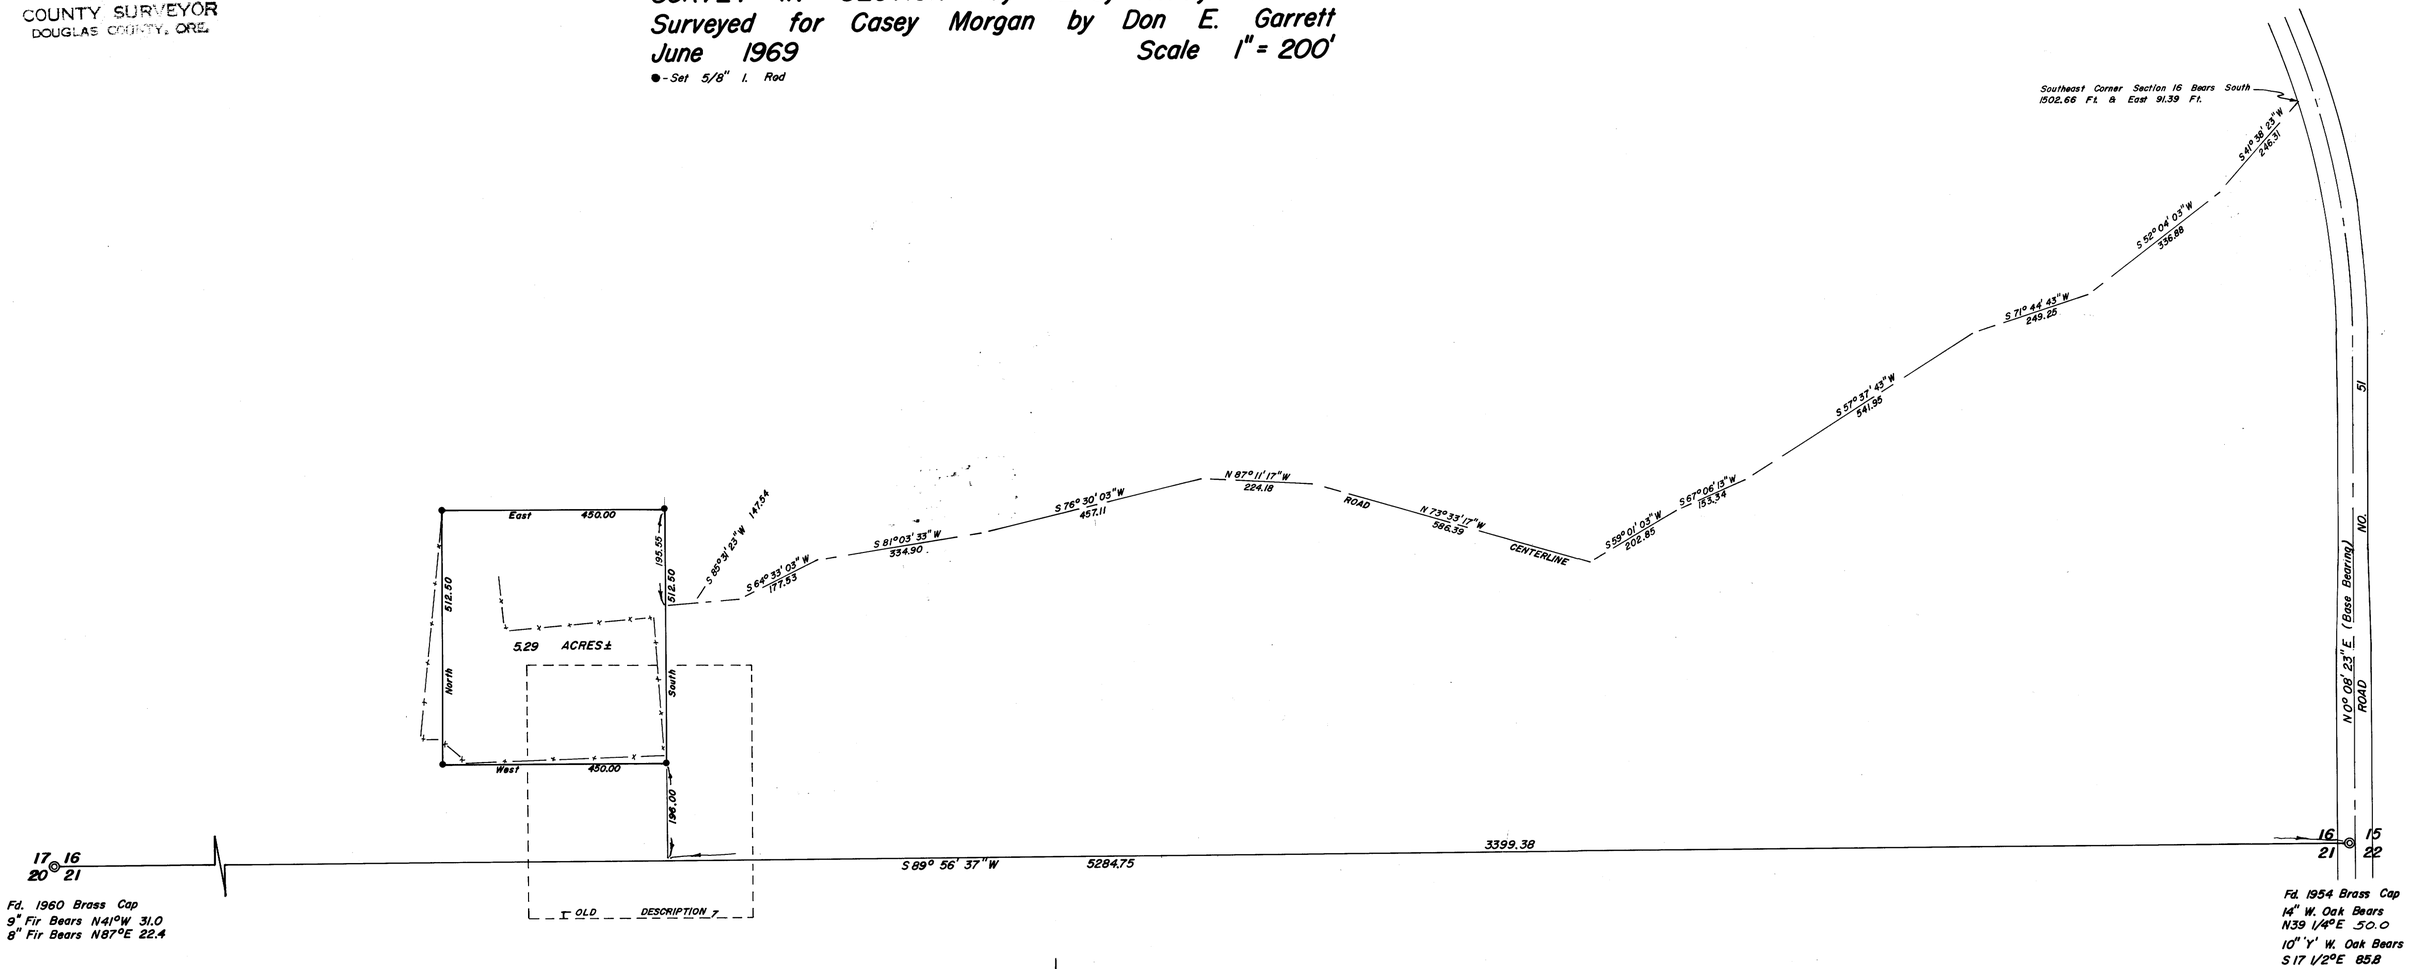

REGISTERED
OREGON
LAND SURVEYOR
Don E. Garrett
JULY 14, 1961
DON E. GARRETT
544

MAP FILE M38 p.8