M 39-10

SURVEYED FOR DEED DESCRIPTION

SITUATED IN SEC. 15, TWP. 27 S., RG. 6 W. W. M.
SURVEYED FOR BOB BAILEY DEC. 1969
BY BAUGHMAN & ACKARET INC.

FILED
RECEIVED
FEB 13 1970
COUNTY SURVEYOR
DOUGLAS COUNTY, ORE.
COUNTY SURVEYORS FILE DATA
DO NOT REMOVE FROM OFFICE

LEGEND
∘ FOUND AS SHOWN
• SET 5/8" IRON ROD
—·-·— ℄ OF A 30 FT. EASEMENT
SCALE 1"=100'

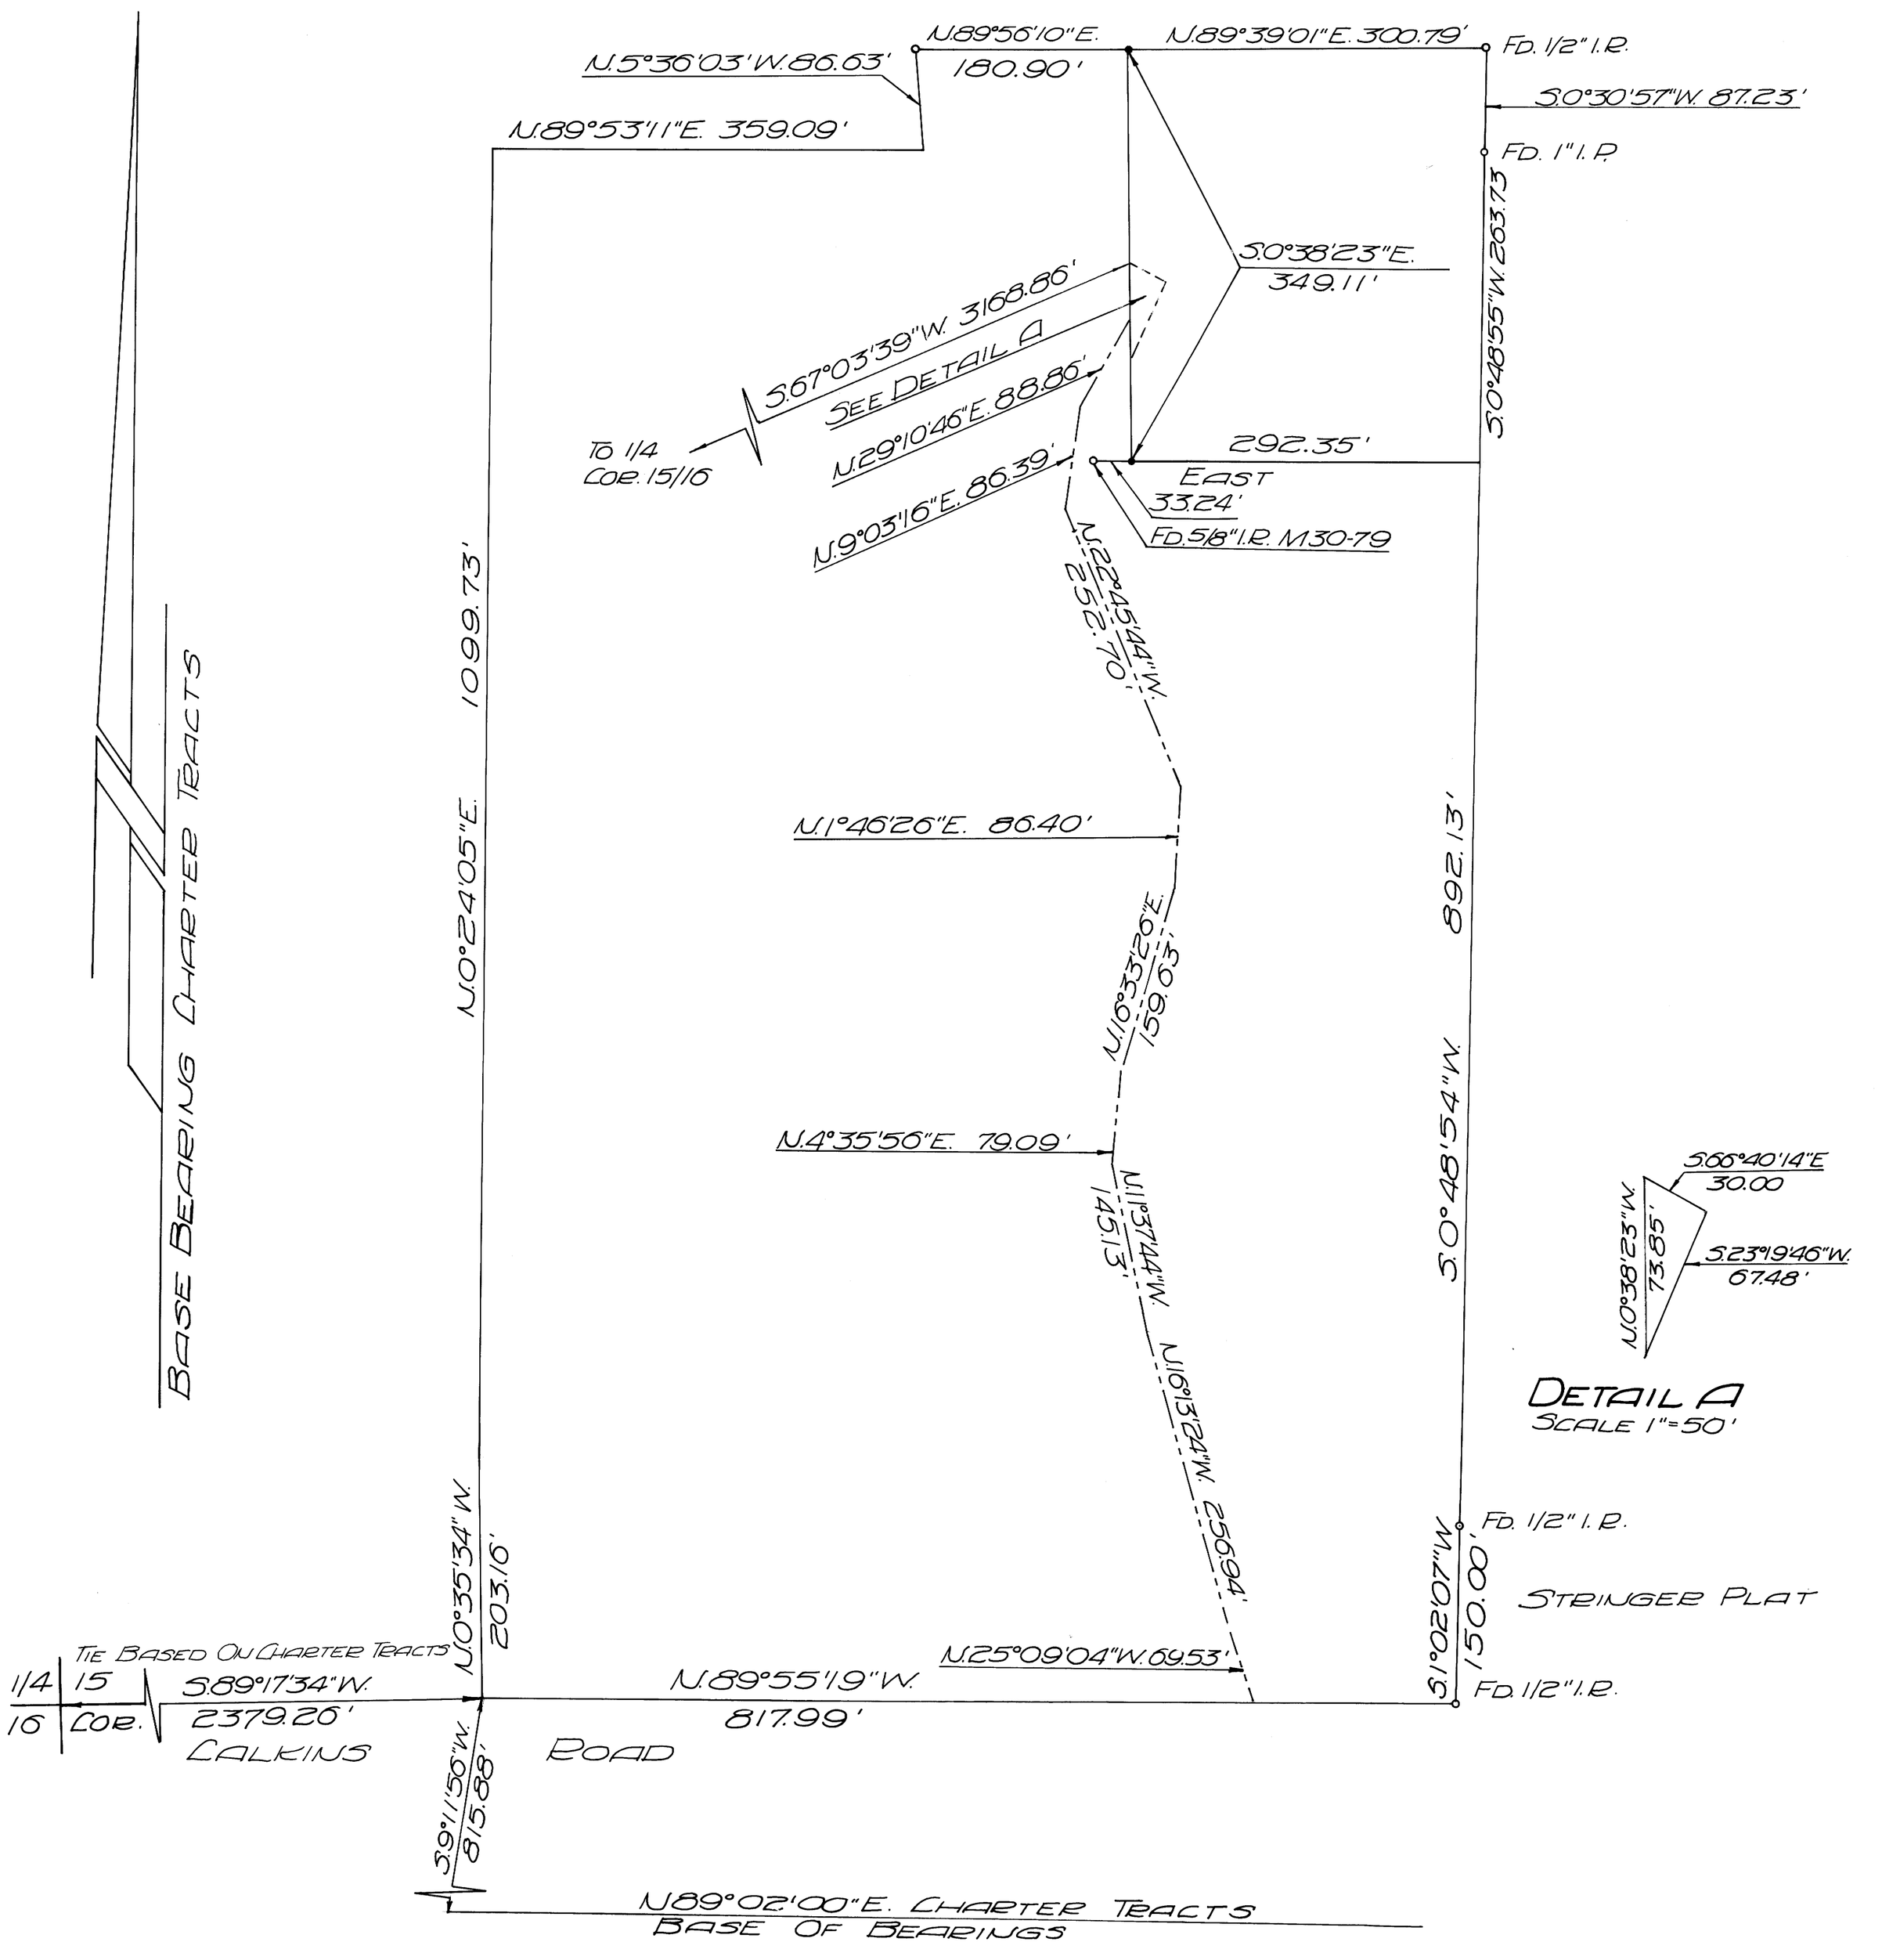

MAP FILE M 39 - 10