COUNTY SURVEYORS FILE DATA
DO NOT REMOVE FROM OFFICE

20 FT. RIGHT OF WAY ACROSS Wm J. JONES PROPERTY IN SEC. 18, T 25 S, R 5 W. W. M., DOUGLAS CO., ORE.

SURVEYED FOR - Wm J. JONES
SURVEYED BY - W. S. BARNES

FEB. 1970
SCALE 1" = 50'

FILED
RECEIVED
COUNTY SURVEYOR
DOUGLAS COUNTY, ORE.

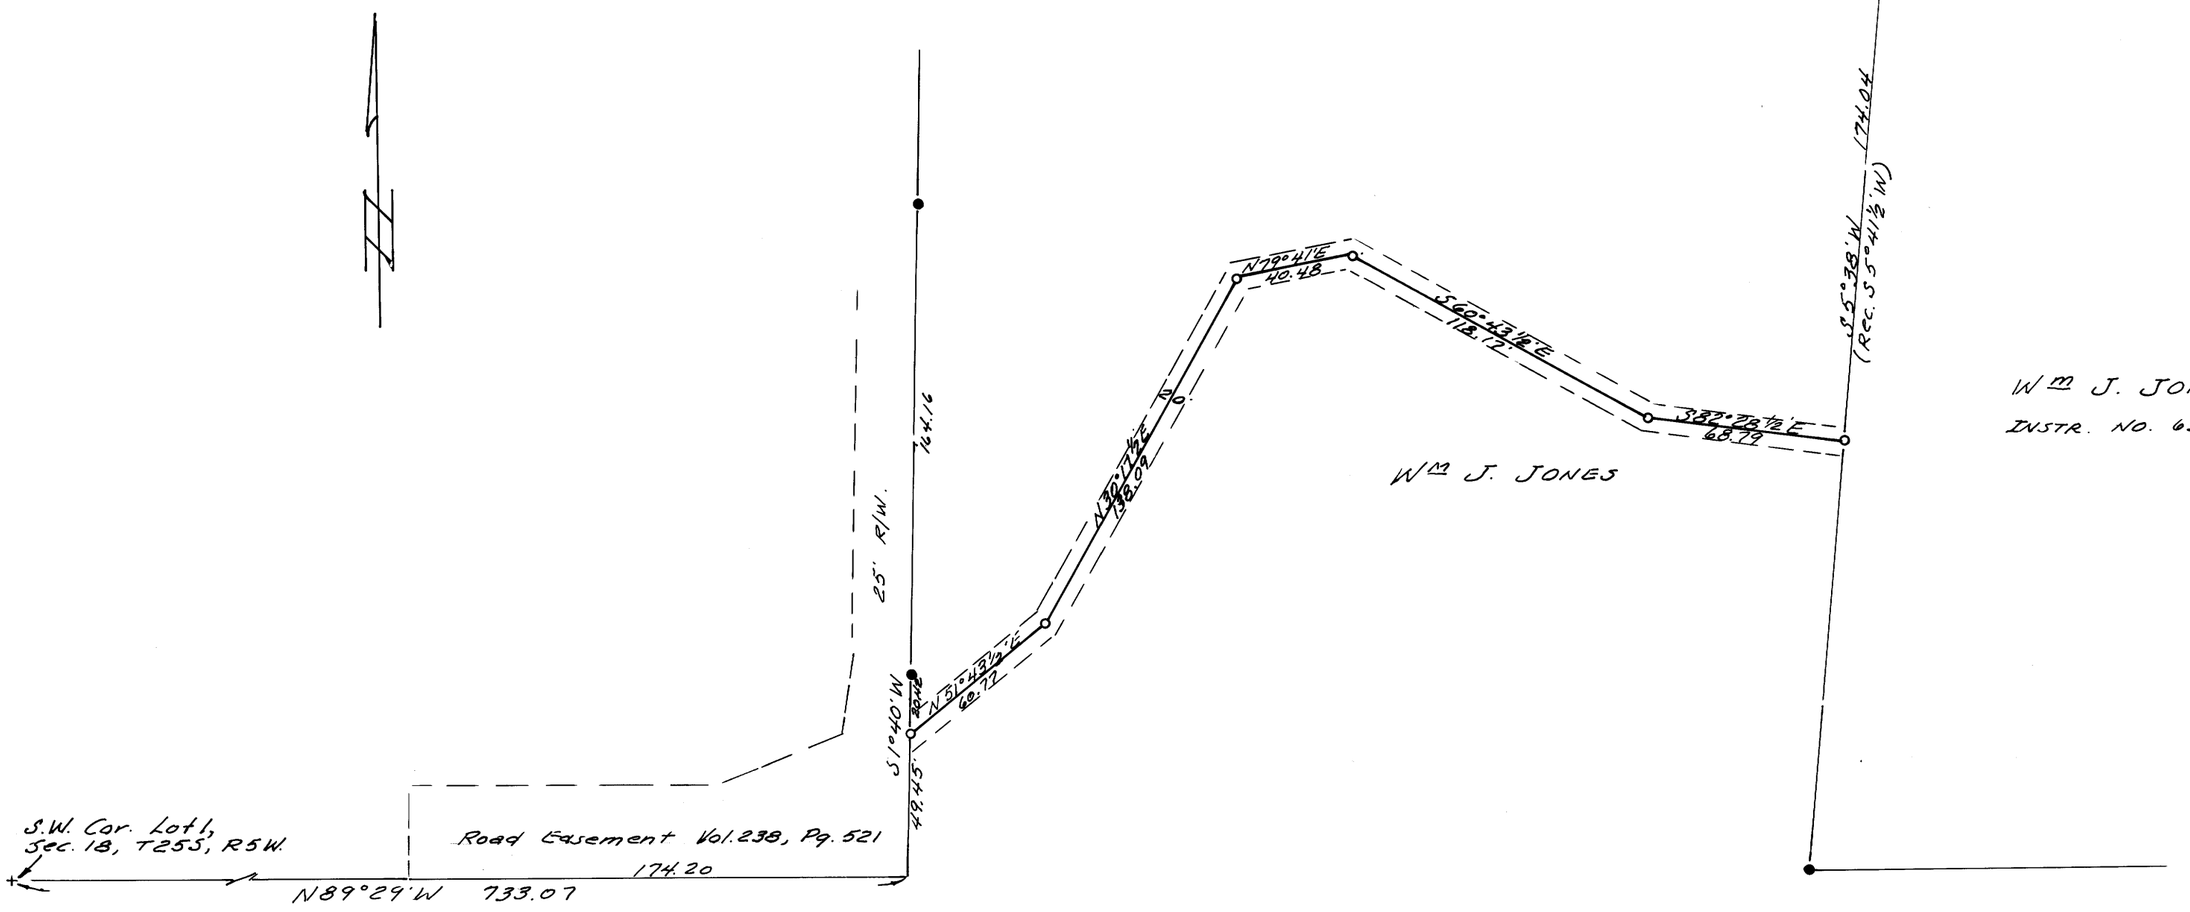

• Monuments Found.
○ 3/4" I.P.'s set.
Base bearing taken from east line of Pages' R/W.
References - C.S. File - M 9-70 & M 14-79

REGISTERED PROFESSIONAL ENGINEER
2128
OREGON
SEPT. 5, 1941
William S. Barnes

W. S. Barnes

M 39-27

MAP FILE M39 - 27