M 39-28

COUNTY SURVEYORS FILE DATA
DO NOT REMOVE FROM OFFICE

FILED
RECEIVED
MAR 5 1970
COUNTY SURVEYOR
DOUGLAS COUNTY, ORE.

SURVEY FOR DEED DESCRIPTION IN LOT 21, BLOCK 1, PLAT J, S.L. & W. CO., DOUGLAS COUNTY, ORE.

SURVEYED FOR - MR. PALERMO
SURVEYED BY - W.S. BARNES

MAR. 1970
SCALE 1" = 60'

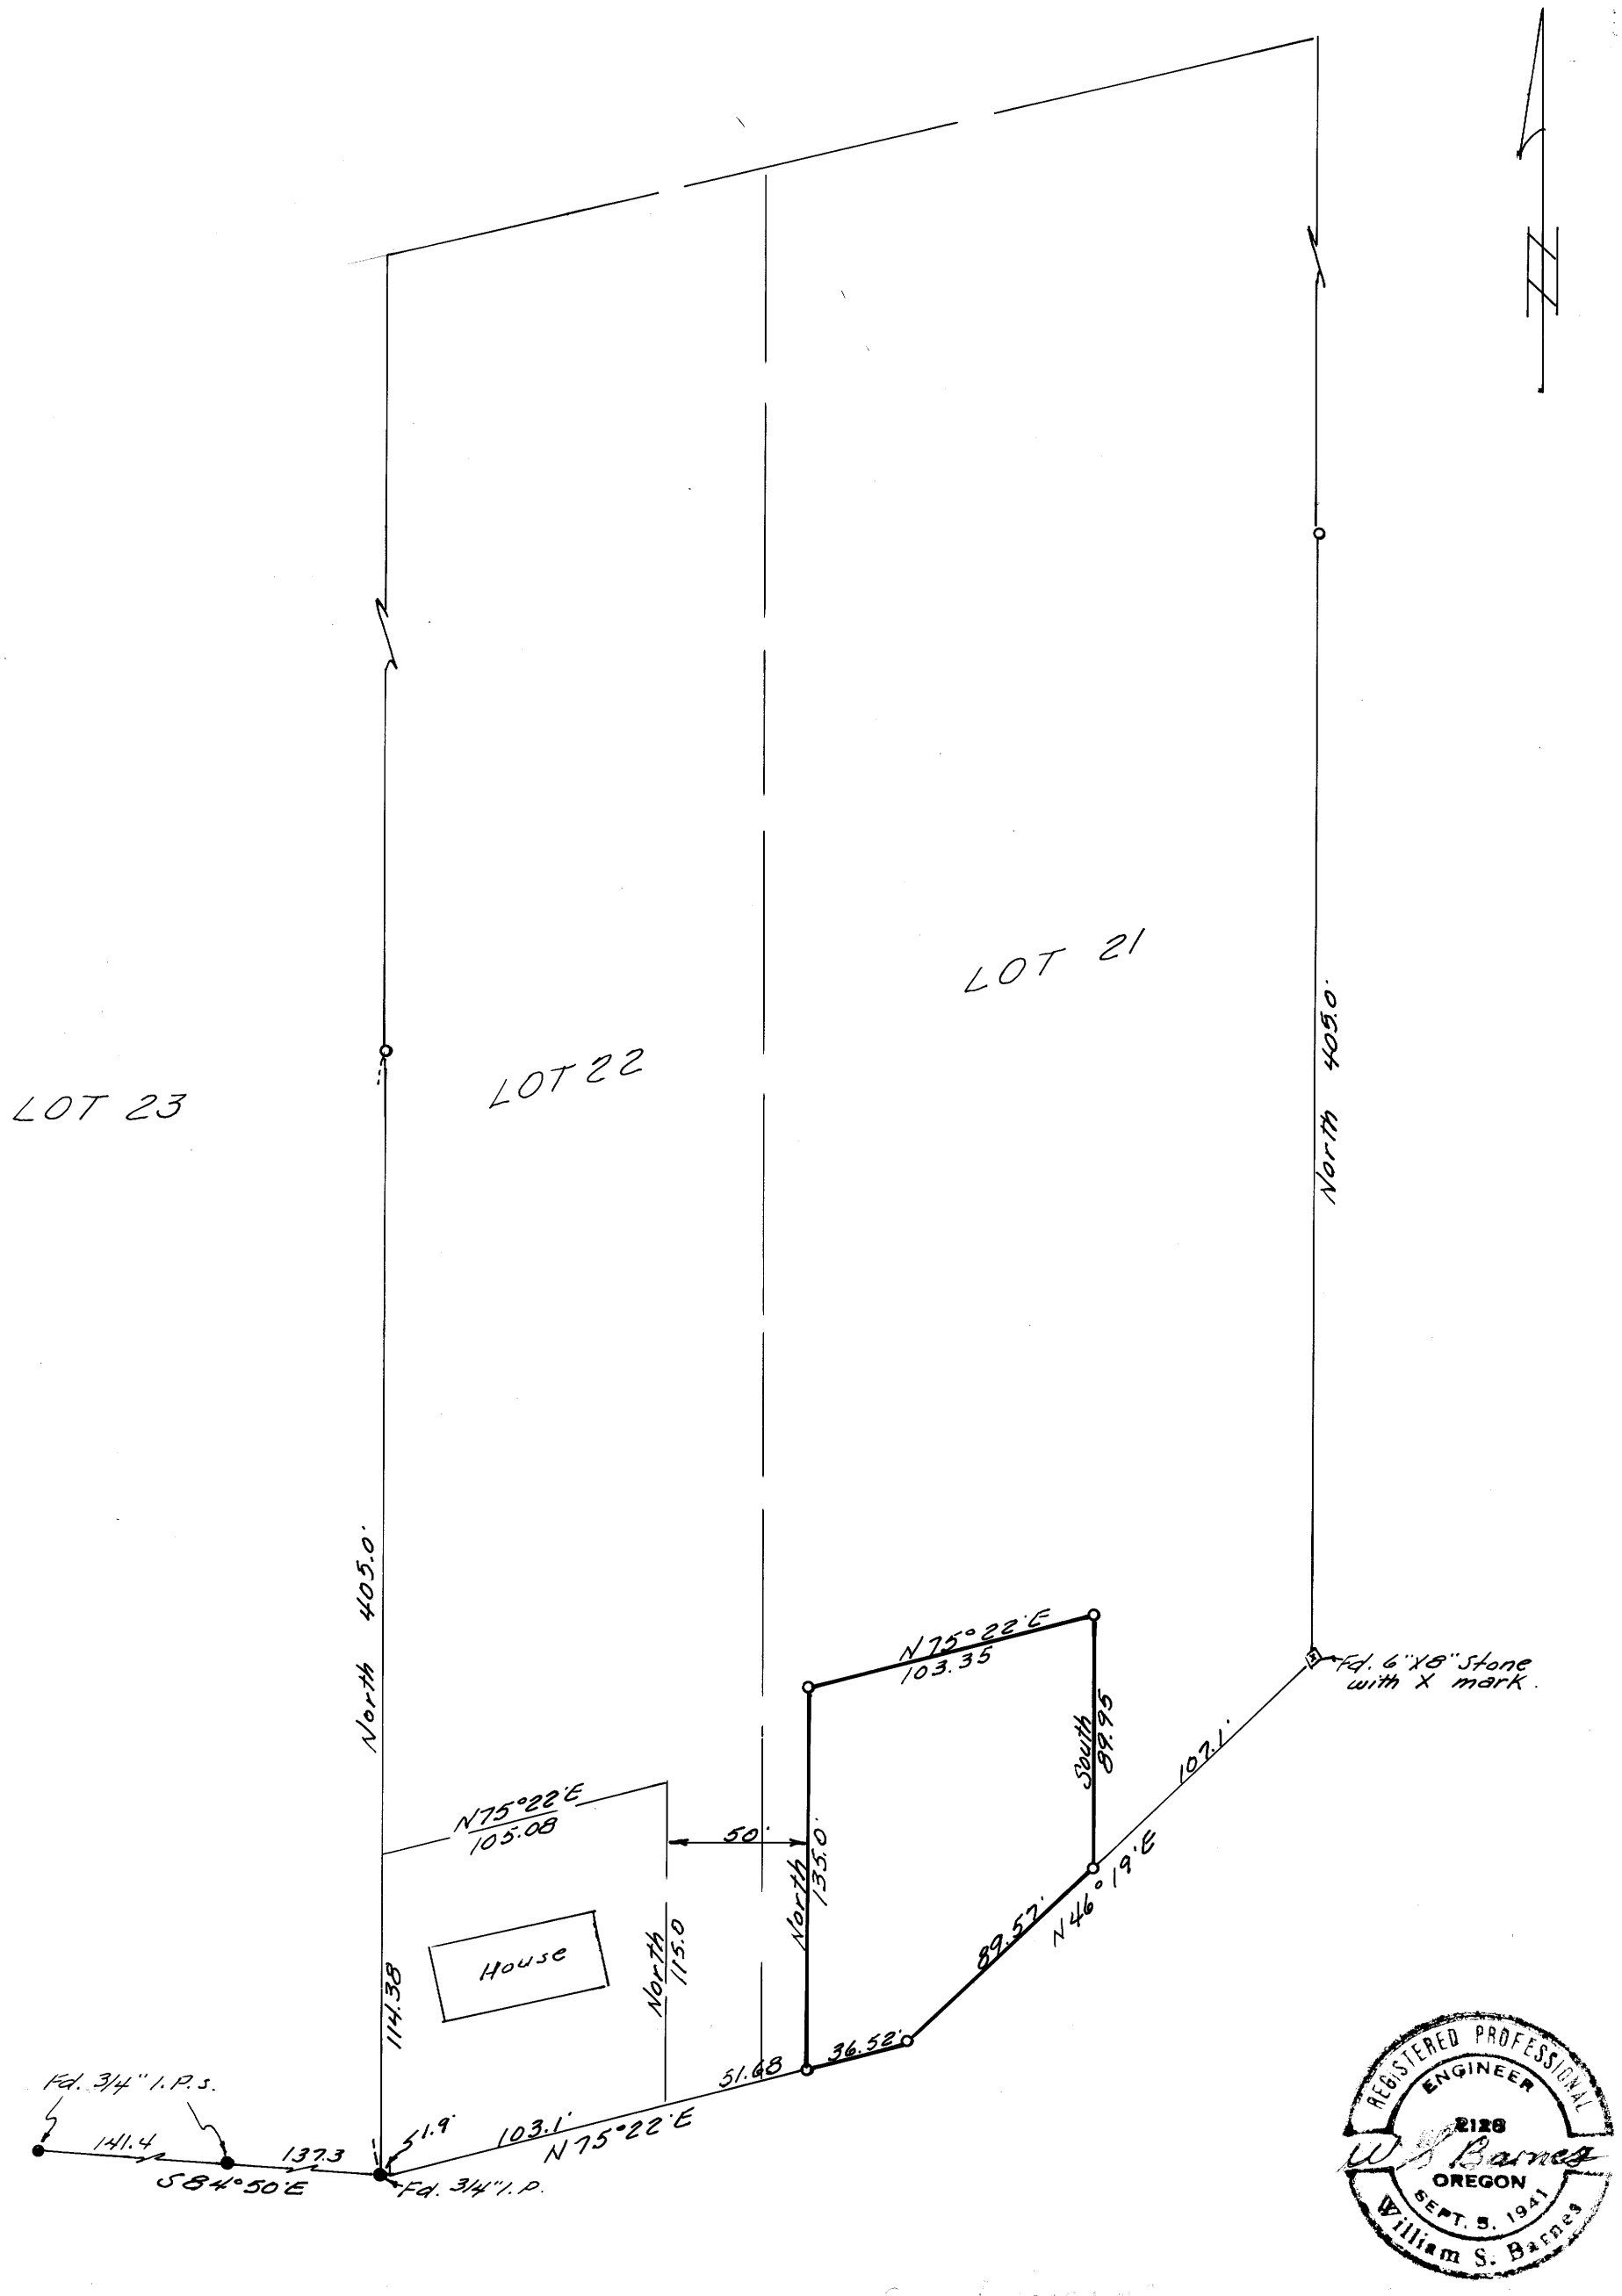

SEE ASSOCIATED SURV M 40-62

- ○ 5/8" iron rods set
- ● monuments found.

Base bearing taken from south line of LOTS 23 & 24.

MAP FILE M39 - 28