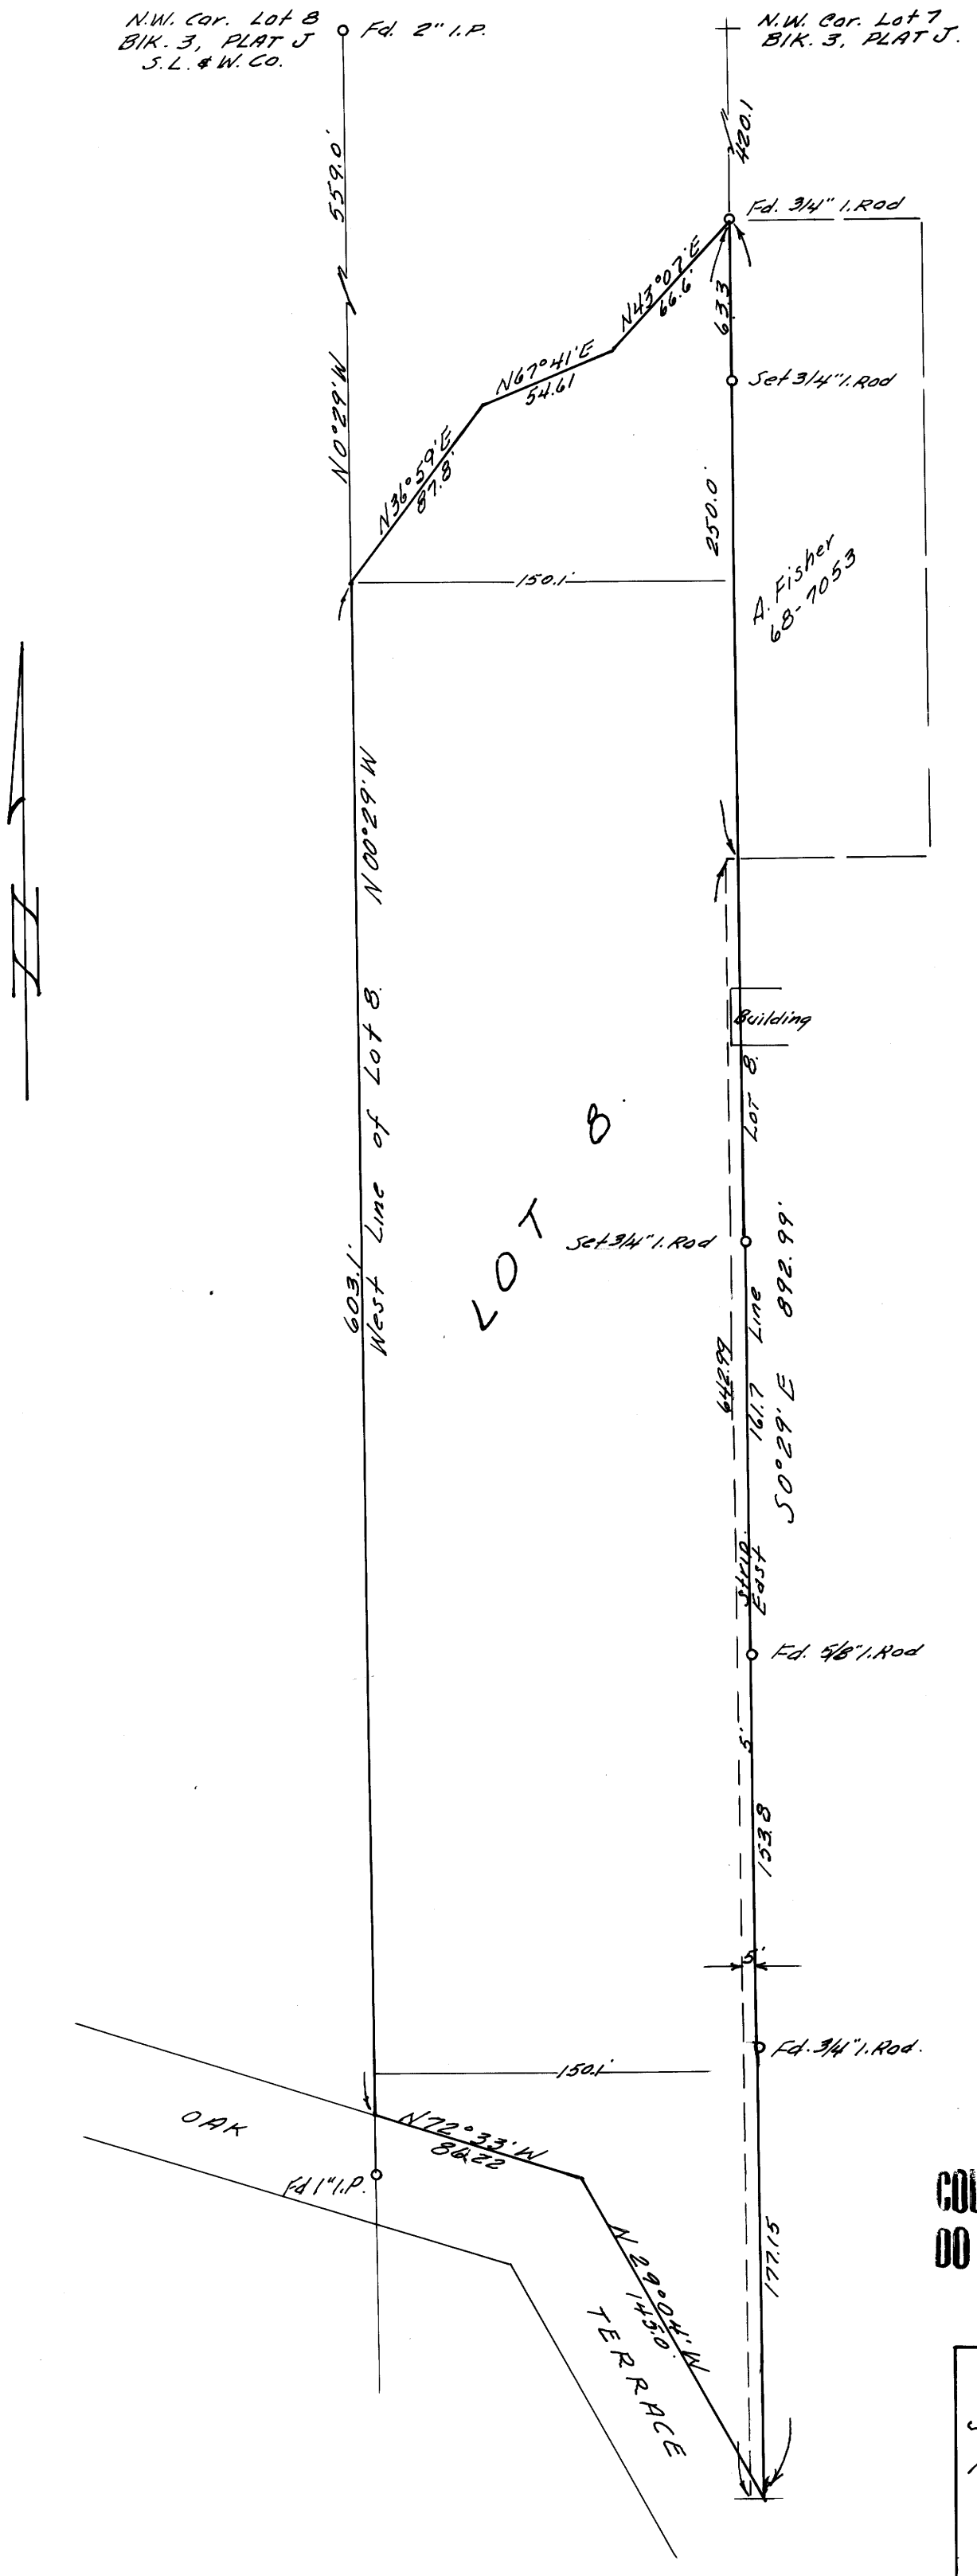

FILED
RECEIVED
JAN 22 1970
COUNTY SURVEYOR
DOUGLAS COUNTY, ORE.

COUNTY SURVEYORS FILE DATA
DO NOT REMOVE FROM OFFICE

REGISTERED PROFESSIONAL ENGINEER
2128
W. S. Barnes
OREGON
SEPT. 5, 1941
William S. Barnes

SURVEY TO ESTABLISH PROPERTY LINES IN LOT 8, BLK. 3, PLAT J, S.L. & W. CO.

SURVEYED FOR - CHRIS JENSEN NOV. 1969
SURVEYED BY - W. S. BARNES SCALE - 1" = 60'