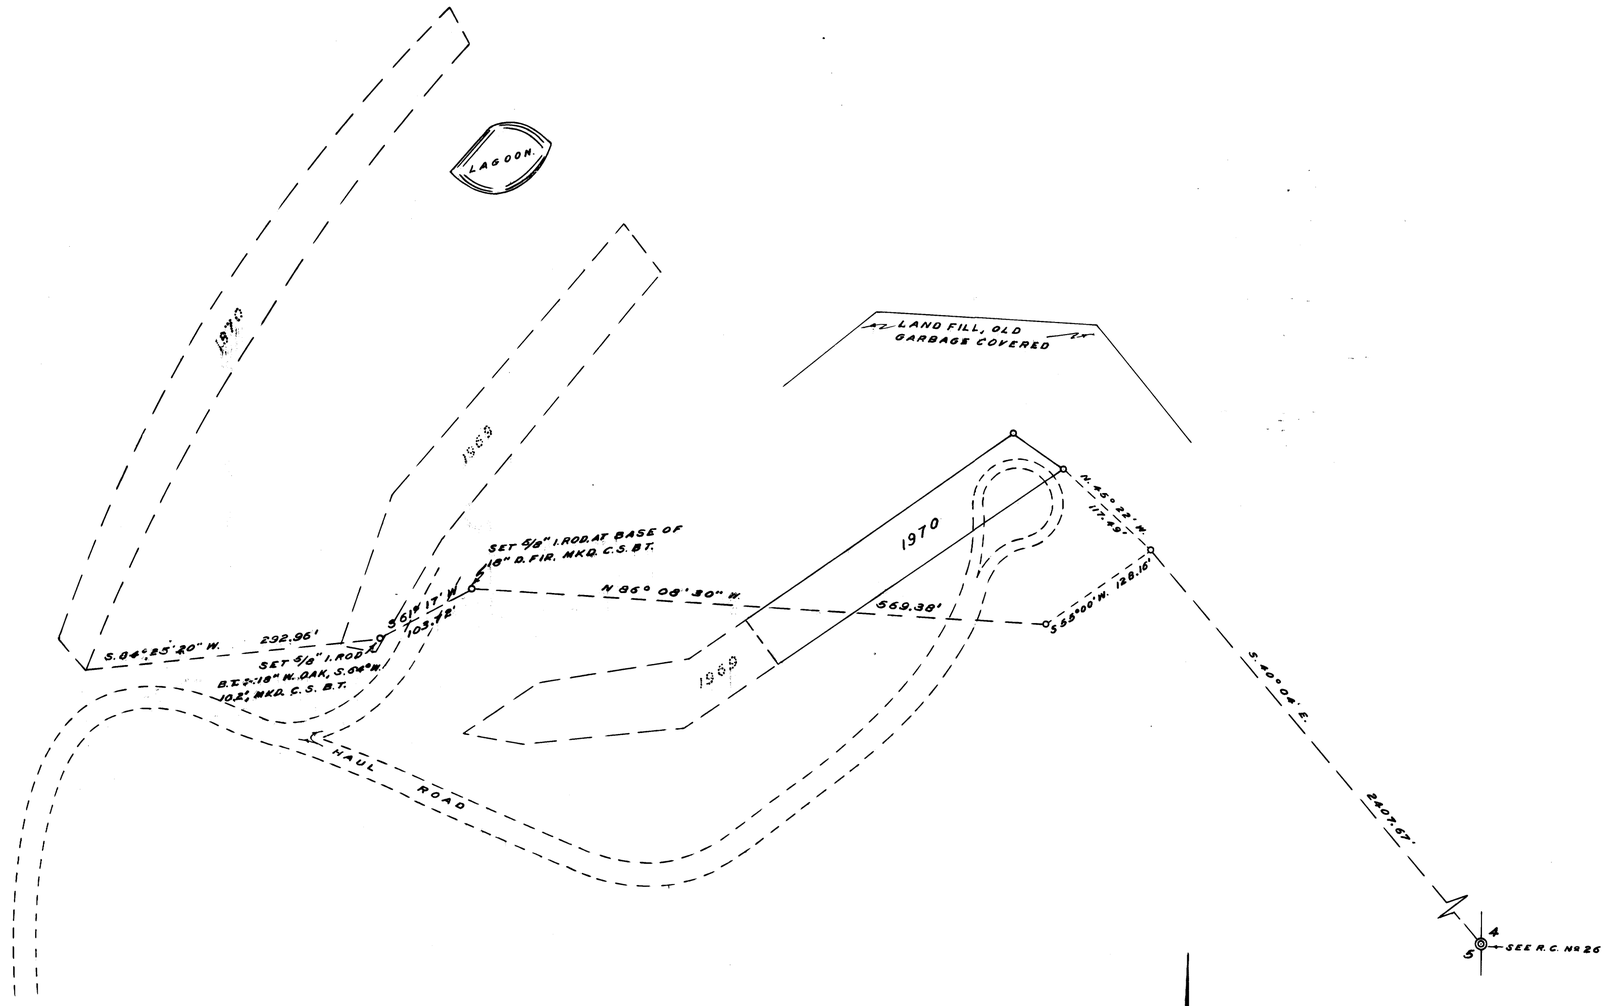

OAKLAND SOLID WASTE SITE

COUNTY SURVEYOR'S OFFICE
DOUGLAS COUNTY, OREGON

TOPOGRAPHY SURVEY OF SANITARY FILL,
SECTION 5, T.25S., R.5W., W.M.

JAMES W. BYRON — COUNTY SURVEYOR
SURVEYED MAR. 12, 1970 — SCALE 1" = 100'
SURVEYED FOR DOUGLAS COUNTY

REGISTERED
OREGON
LAND SURVEYOR
James W. Byron
JAMES W. BYRON
303

— — — = OPEN TRENCH & YEAR.
———— = CLOSED TRENCH & YEAR
o = 5/8" I.RODS SET.

NOTE:- BEARINGS ARE MAGNETIC,
WITH A VAR. OF 20° 00'.

COUNTY SURVEYORS FILE DATA
DO NOT REMOVE FROM OFFICE

C.S. FILE 54/106
M 39-32