FILED
RECEIVED
MAR 25 1970
COUNTY SURVEYOR
DOUGLAS COUNTY, ORE.

COUNTY SURVEYORS FILE DATA
DO NOT REMOVE FROM OFFICE

SURVEY IN SECTION 22, T22S, R5W, W.M.

SURVEYED FOR THEORDORE M. ZIEGALIS
SURVEYED BY DON E. GARRETT
MARCH, 1970 SCALE: 1" = 50'

○ — DENOTES SET 5/8" IRON ROD
BEARING BASED ON SOLAR OBSERVATION TAKEN MARCH 20, 1970

REGISTERED
OREGON
LAND SURVEYOR
Don E. Garrett
JULY 14, 1961
DON E. GARRETT
544

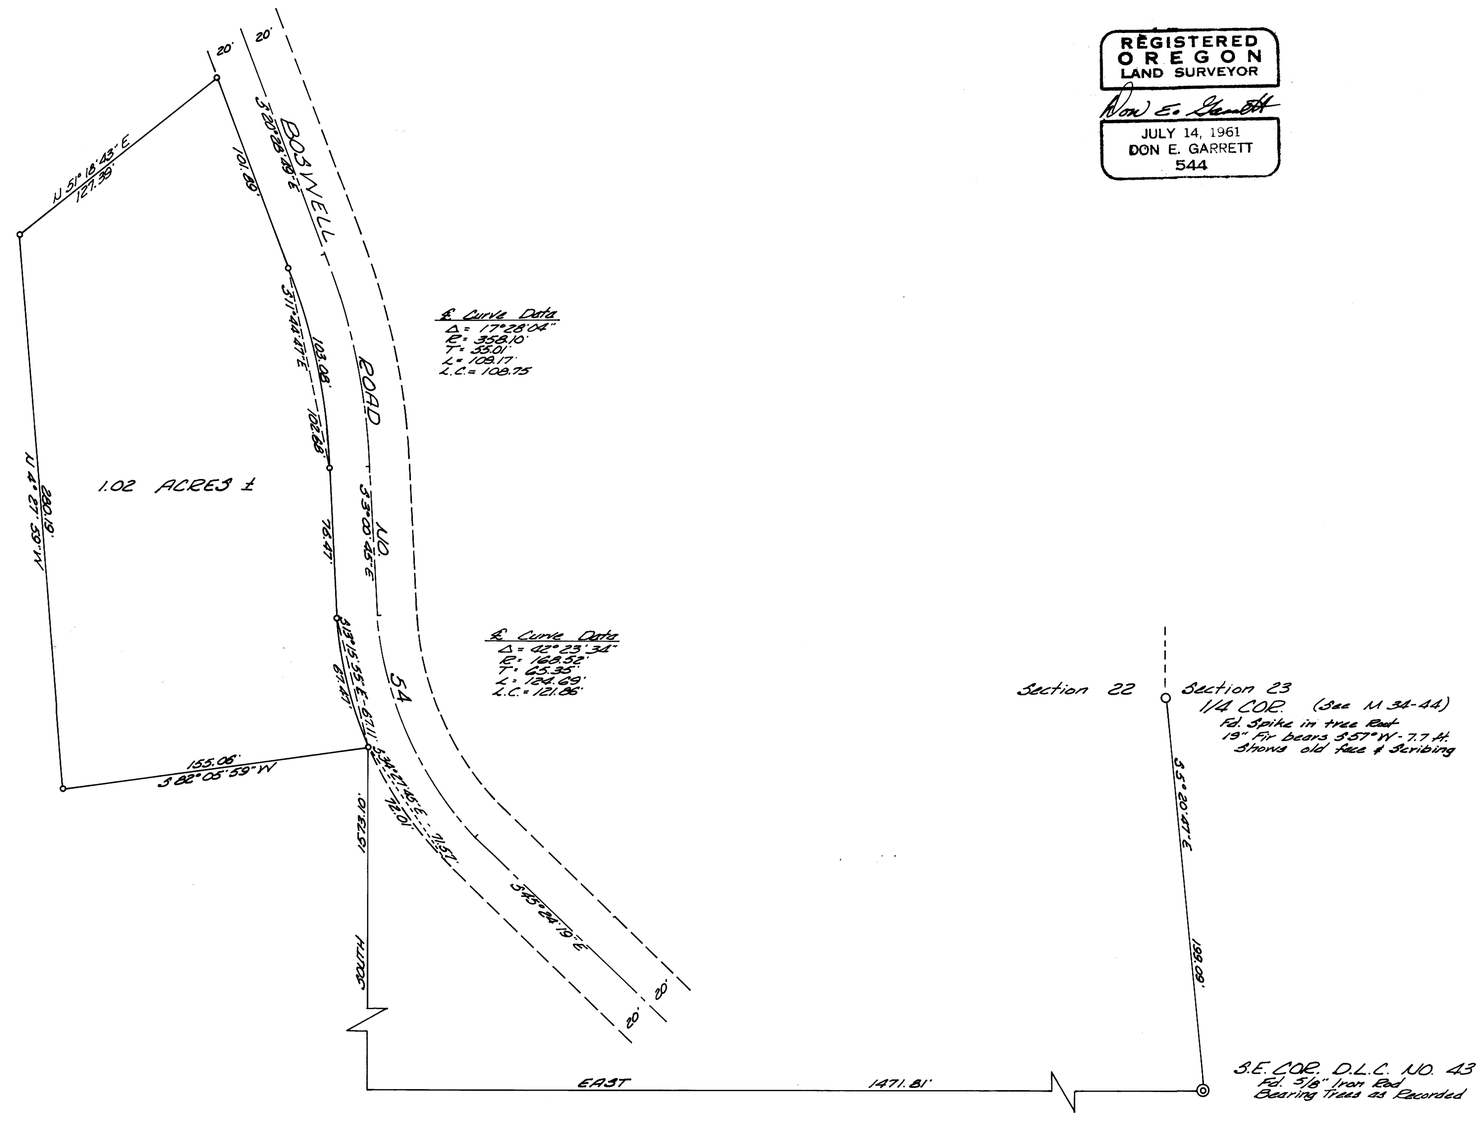

MAP FILE M 39 - 34

MAP FILE M 39 - 34