LR

May 7

M-39-59

COUNTY SURVEYORS FILE DATA
DO NOT REMOVE FROM OFFICE

SURVEY IN D.L.C. #64, SECTION 7, TWP. 27 S., RNG. 6 W., W.M.

SURVEYED FOR HERMAN STOFFEL
SURVEYED BY DON E. GARRETT
APRIL, 1970 SCALE: 1" = 200'

o — DENOTES SET 5/8" IRON ROD

REGISTERED
OREGON
LAND SURVEYOR
Don E. Garrett
JULY 14, 1961
DON E. GARRETT
544

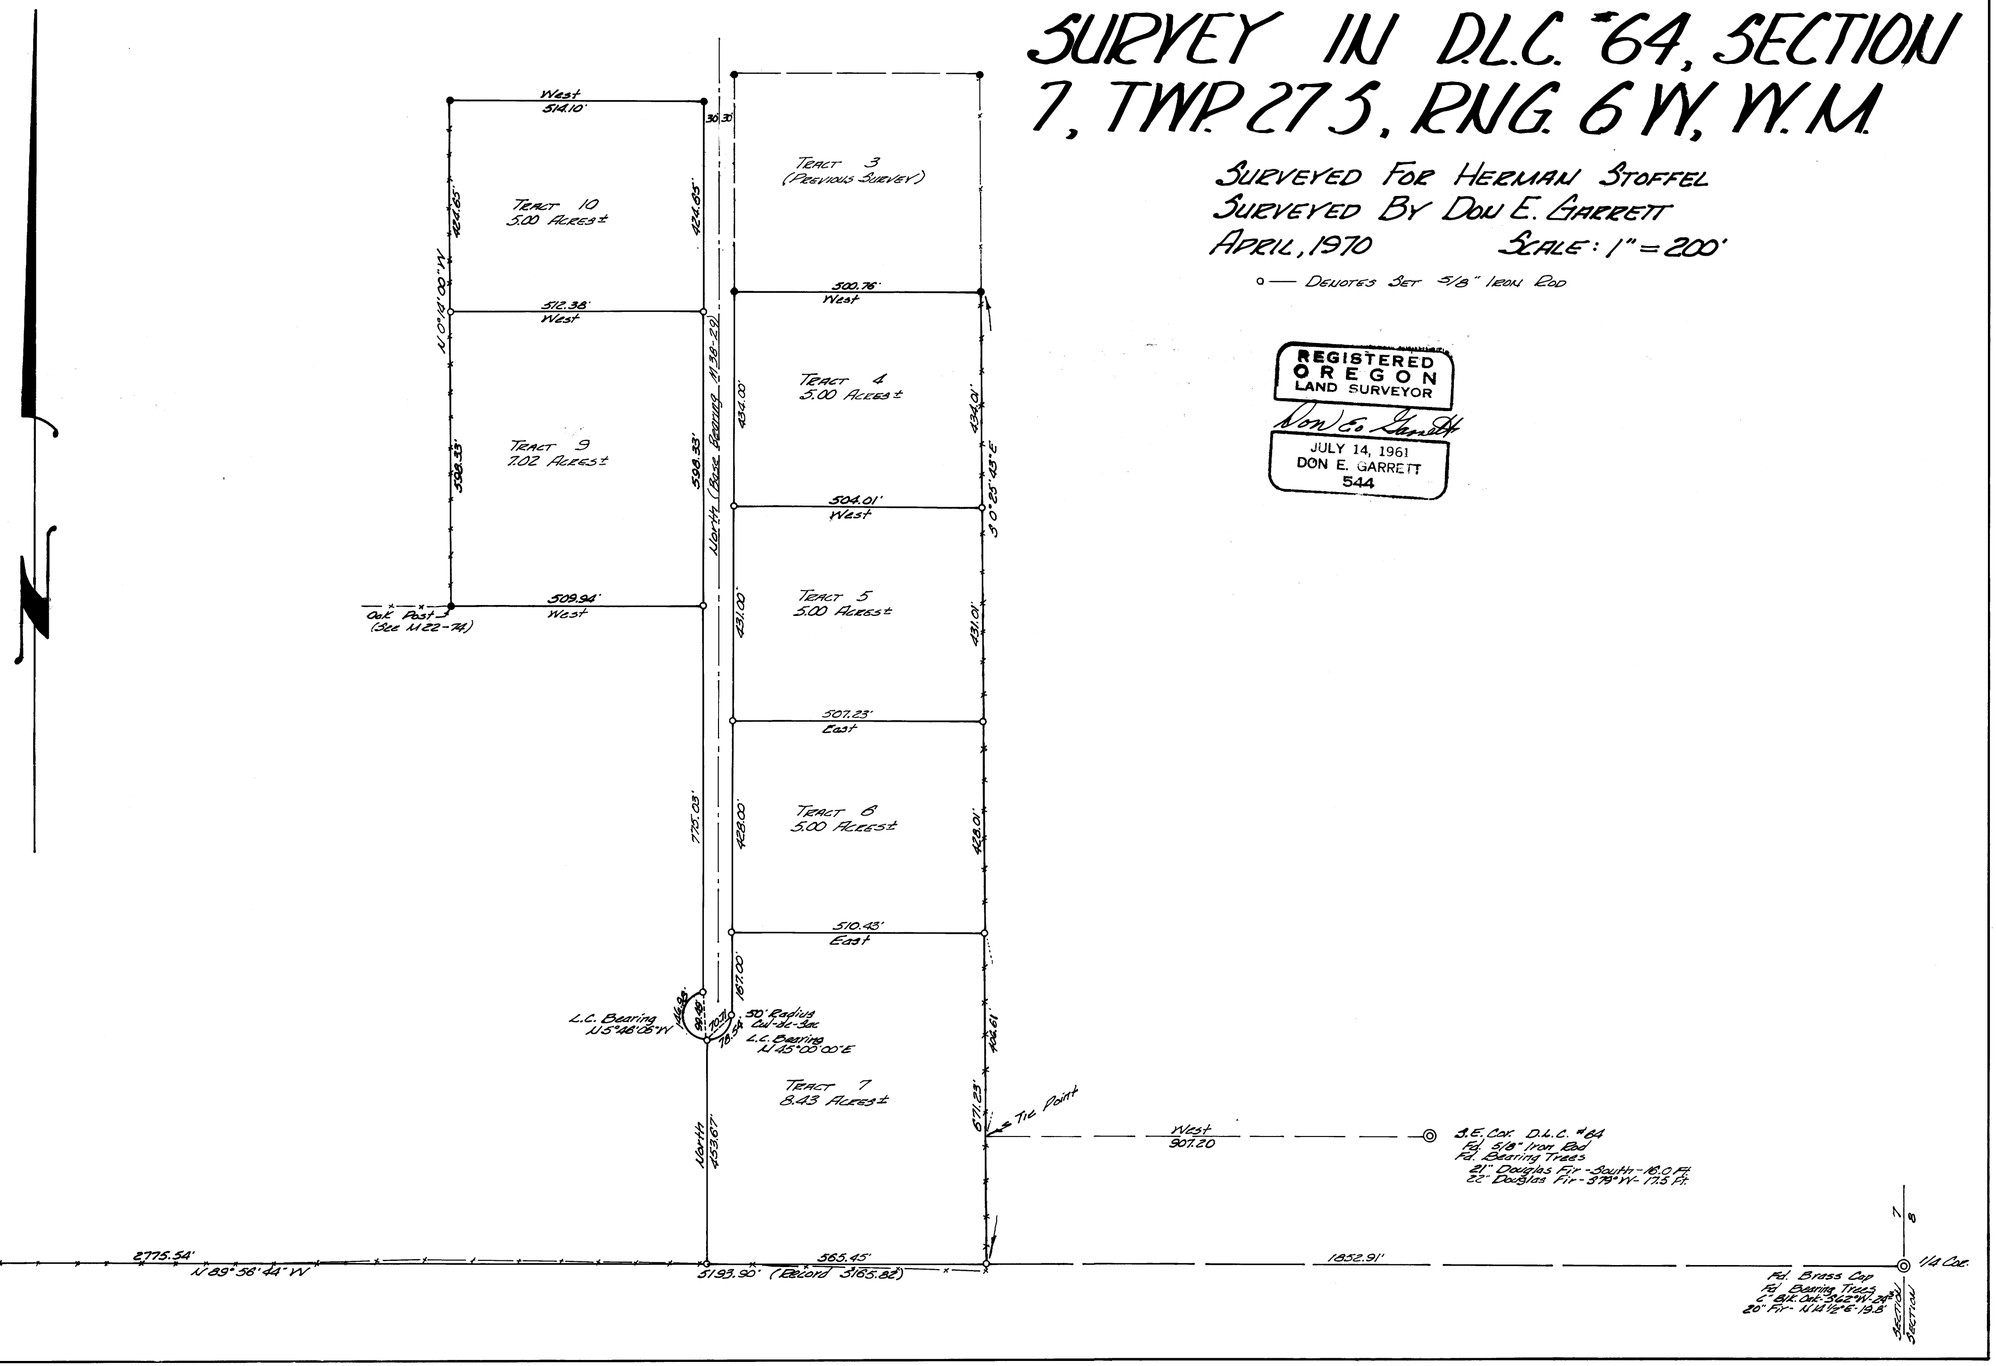

M39-59