SURVEY FOR DEED DESCRIPTIONS
IN SEC. 15, T 27 S, R 6 W. W.M.
DOUGLAS COUNTY, ORE.

SURVEYED FOR - BYRD SMITH — MAY 1970
SURVEYED BY - W.S. BARNES — SCALE 1" = 40'

COUNTY SURVEYORS FILE DATA
DO NOT REMOVE FROM OFFICE

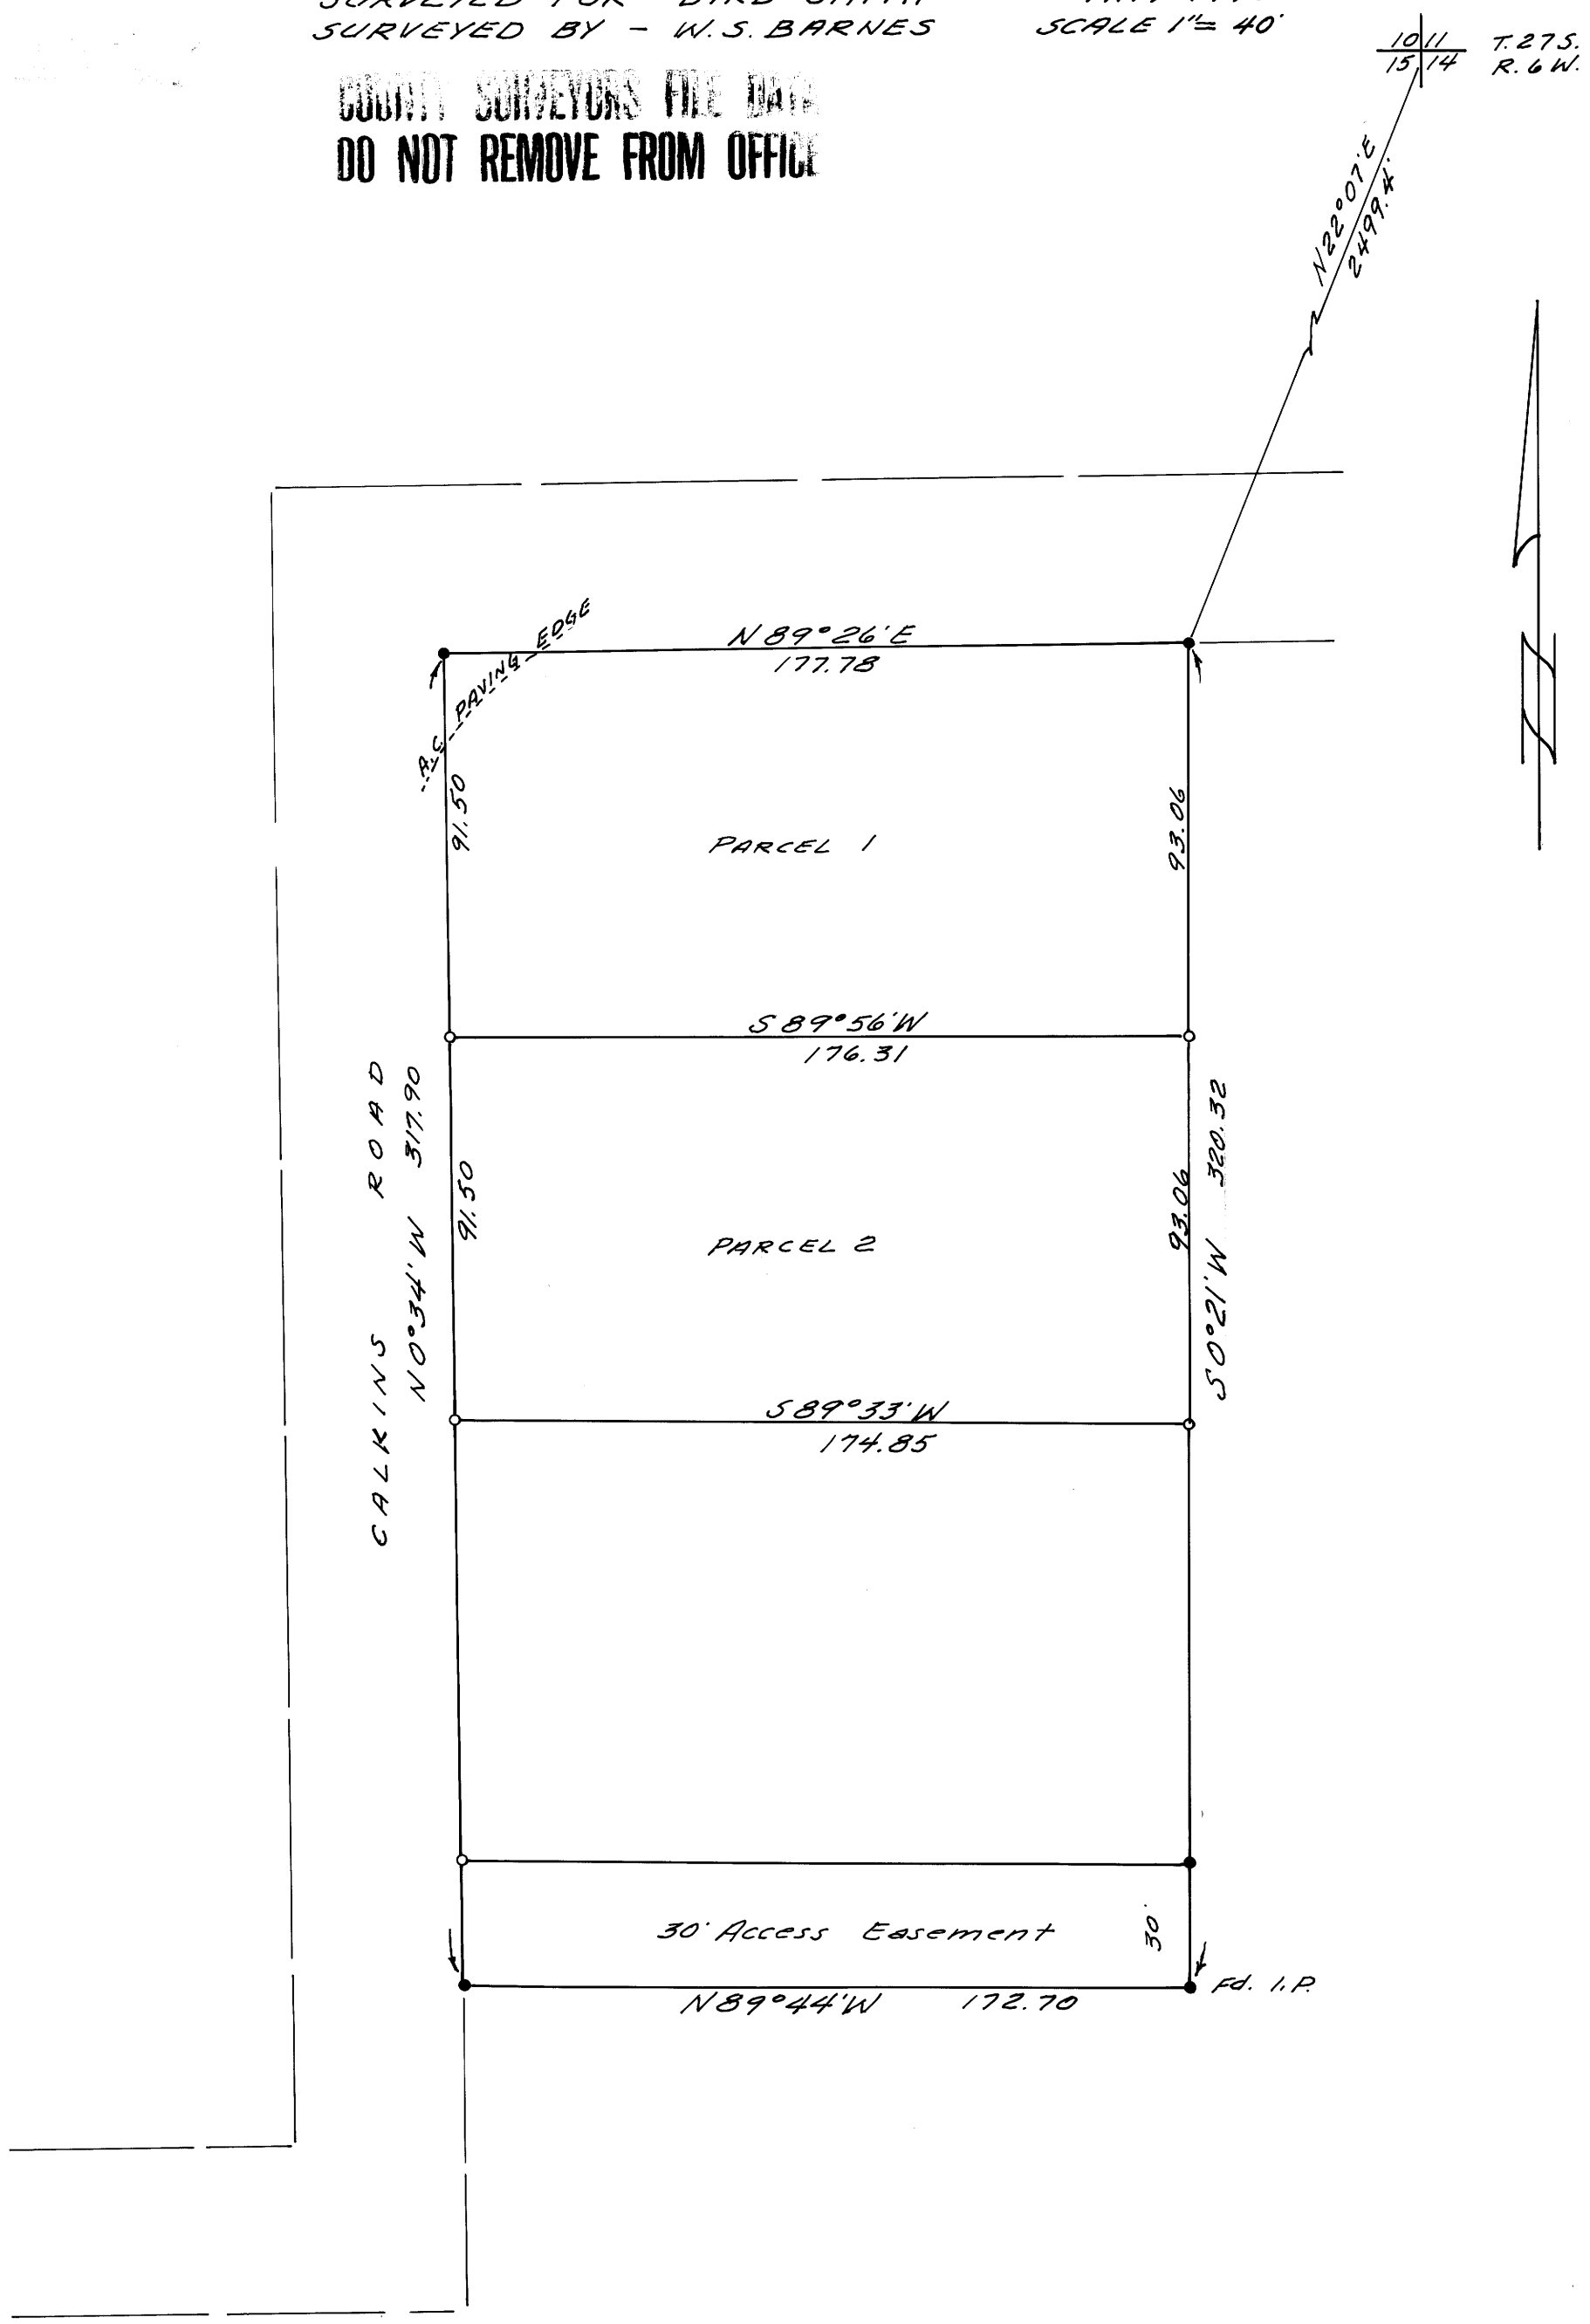

• 3/4" iron rod found, except where designated.
○ 5/8" iron rods set.
Base bearing taken from C.S. File - M 18-44.
Refr. C.S. - M 18-44

REGISTERED PROFESSIONAL ENGINEER 2128 OREGON SEPT. 5, 1941 William S. Barnes

W. S. Barnes

M39-61