29-6EW

COUNTY SURVEYORS FILE COPY
DO NOT REMOVE FROM OFFICE

SURVEY IN SECTS. 33, T28S, R6W & 4, T29S, R6W, W.M.

Surveyed for A. J. Rice by Don E. Garrett

May 1970 Scale 1" = 100'

○ - Set 5/8" I. Rod
● - Found 5/8" I. Rod
Bearings are based on a solar observation taken Feb. 10, 1968.
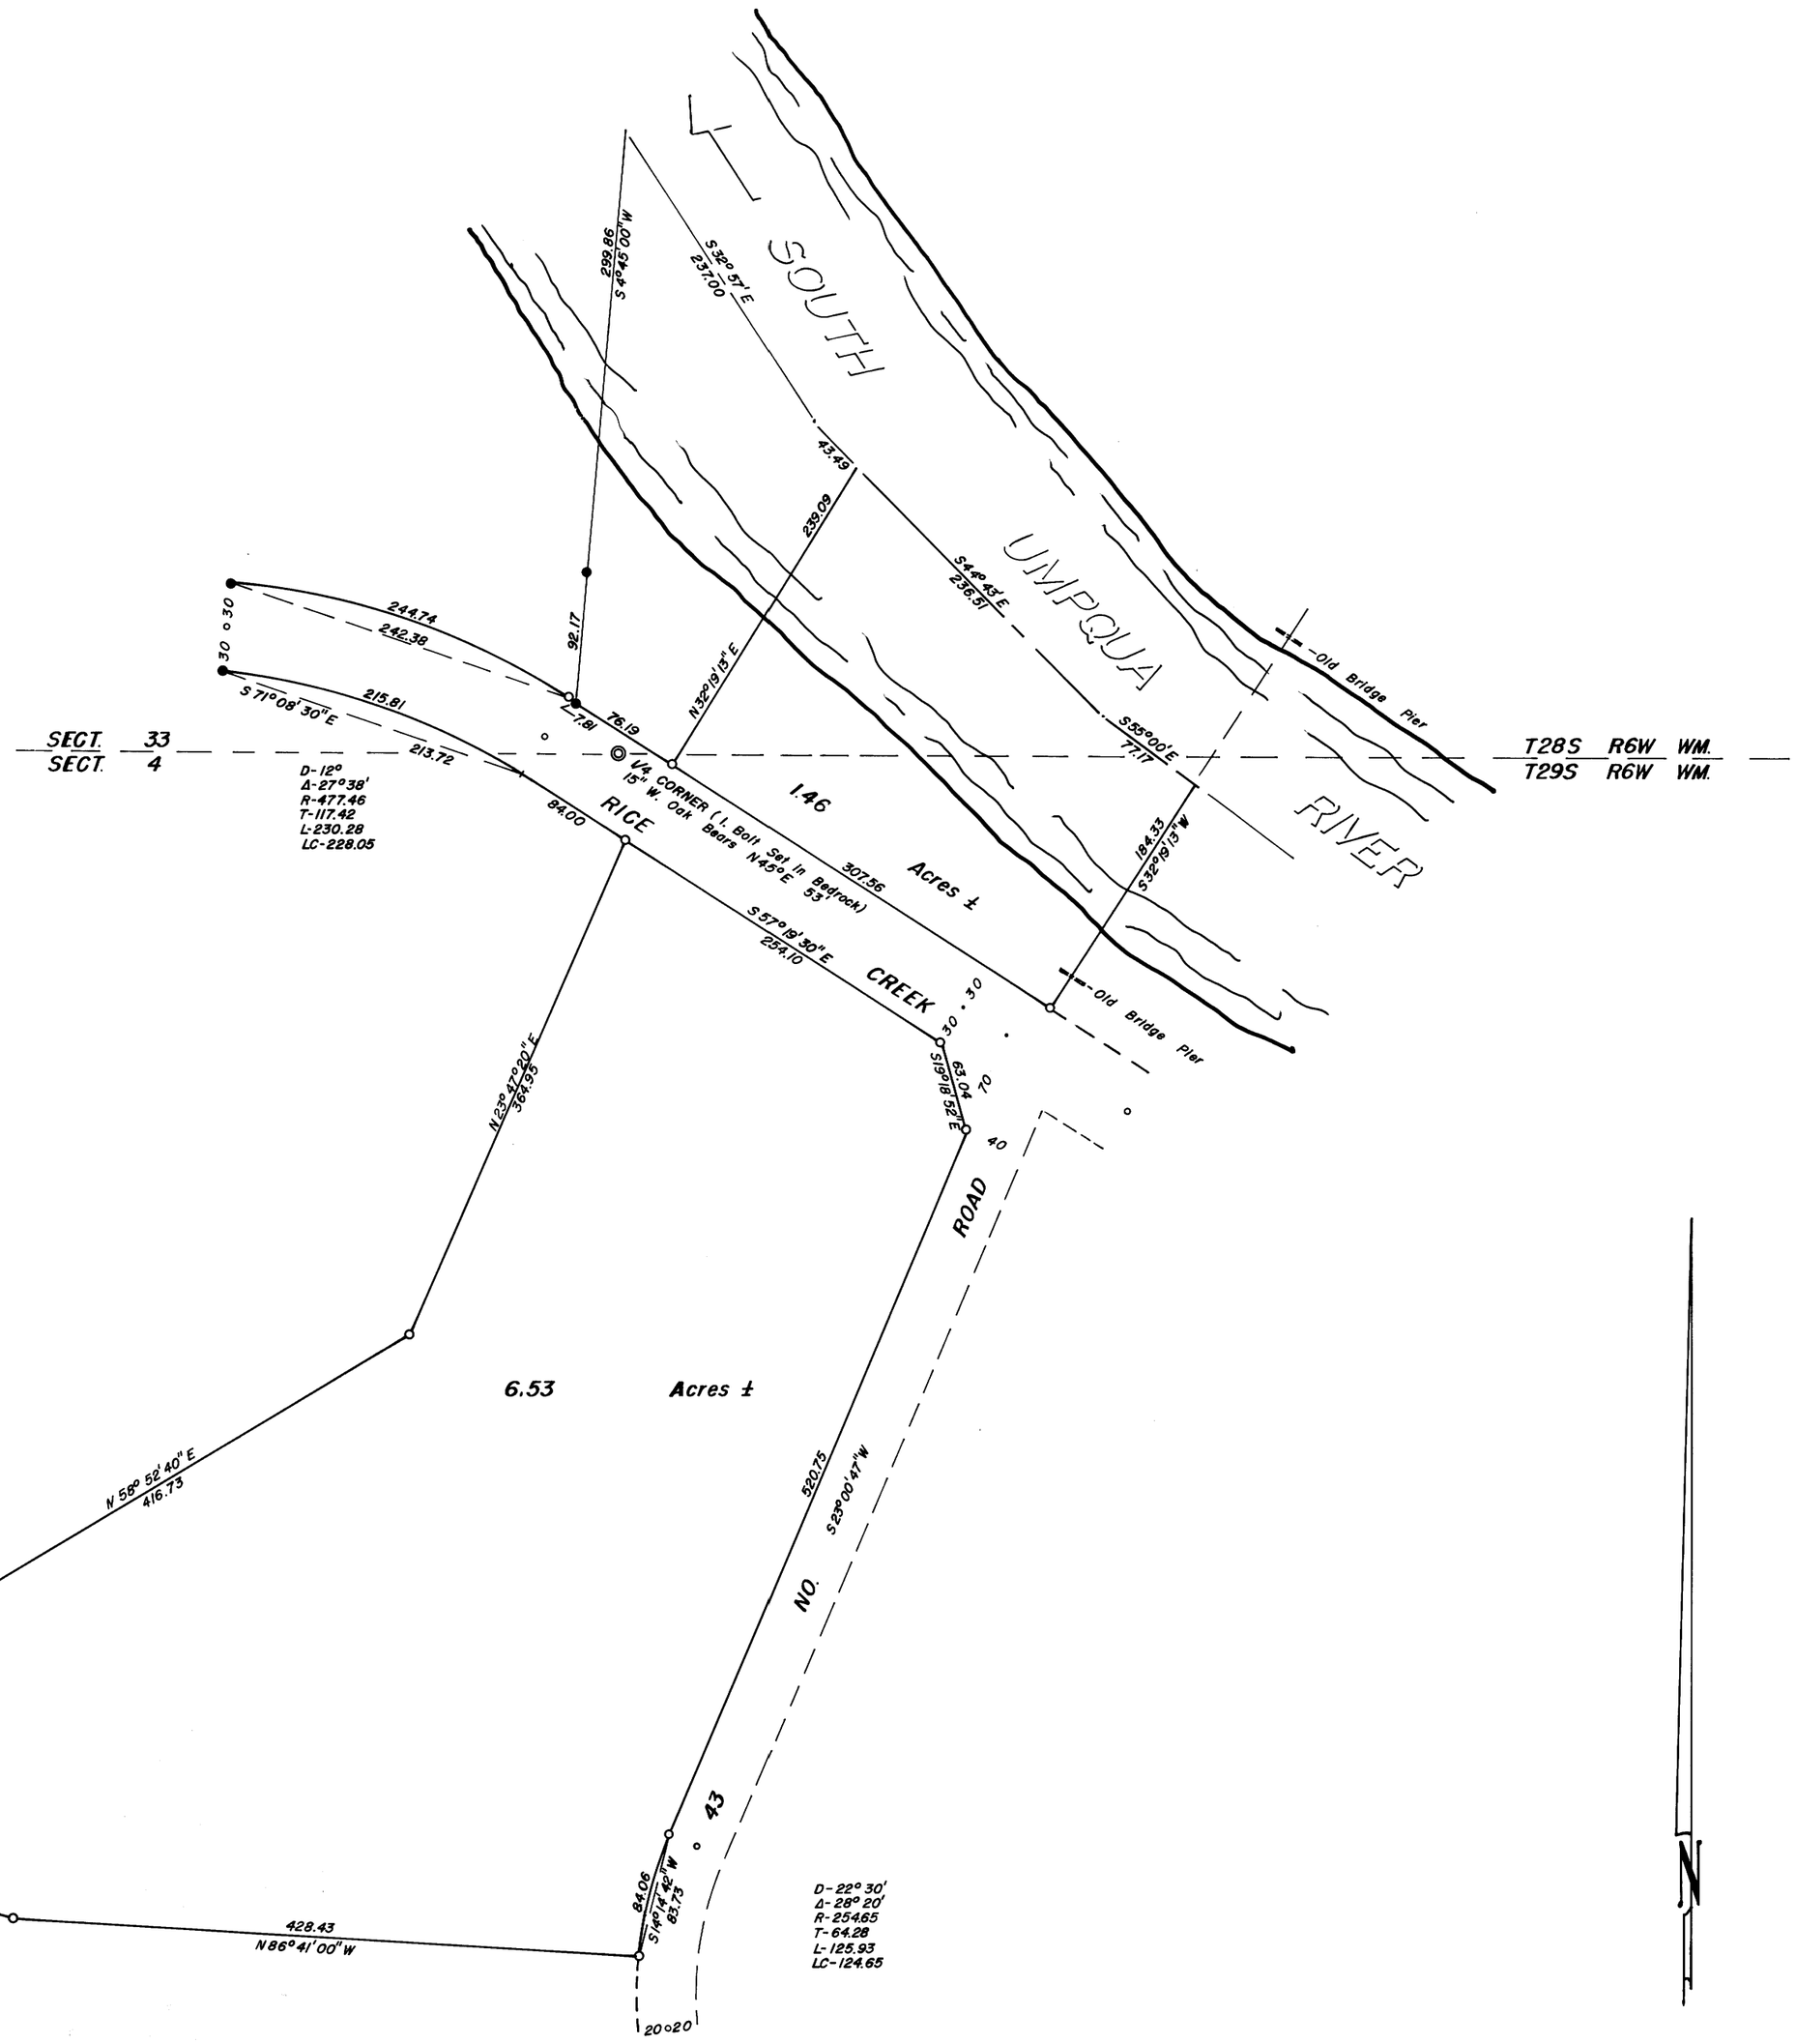
REGISTERED
OREGON
LAND SURVEYOR
Don E. Garrett
JULY 14, 1961
DON E. GARRETT
544