FILED
RECEIVED
AUG 17 1970
COUNTY SURVEYOR
DOUGLAS COUNTY, ORE.

COUNTY SURVEYORS FILE DATA
DO NOT REMOVE FROM OFFICE

SURVEY IN BLOCK 3, PLAT D
SUTHERLIN LAND & WATER CO.
Surveyed for Donald Beck & Denny Wells
Surveyed by Victor M. McLind
August 1970 Scale 1"=200'

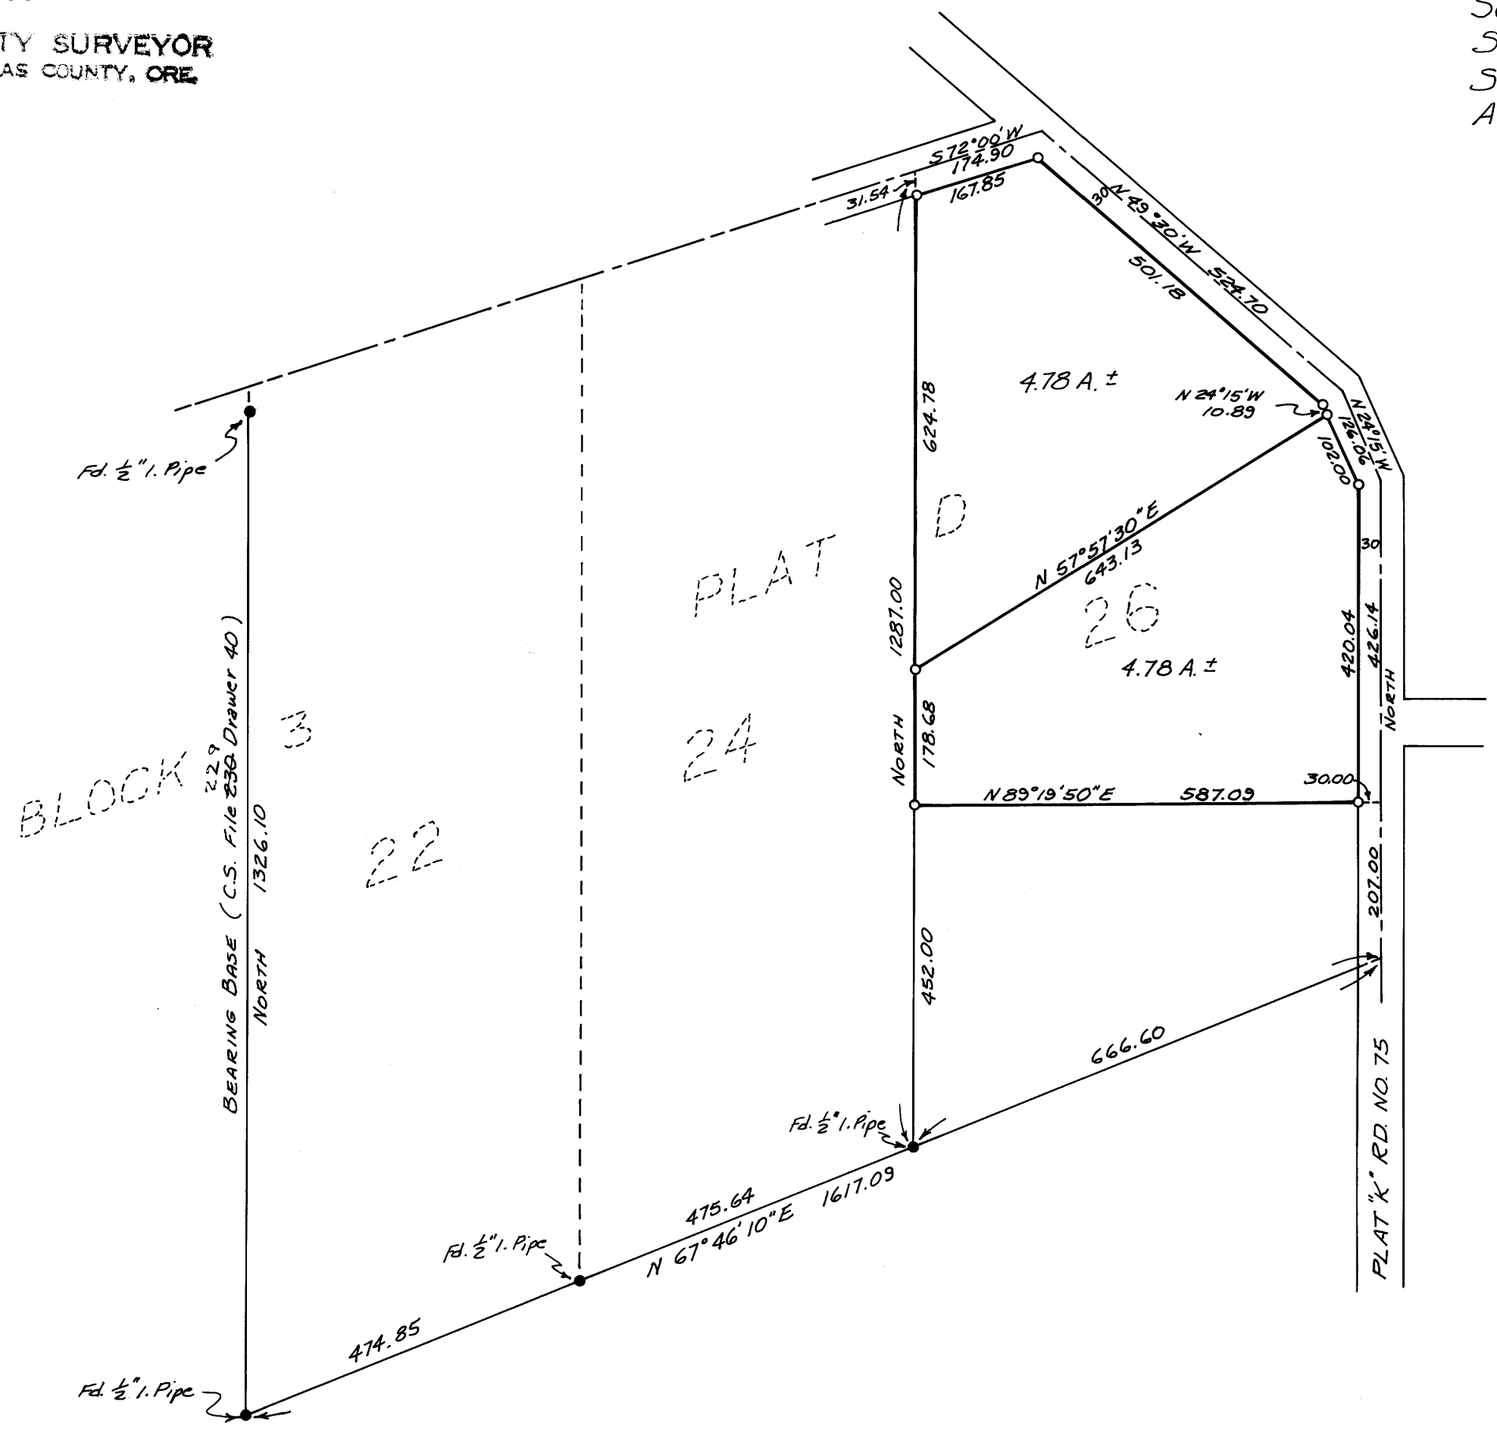

○ Set ⅝" Iron rod
● Found monument

REGISTERED
OREGON
LAND SURVEYOR
Victor M. McLind
JULY 17, 1970
VICTOR M. McLIND
934

M40 - 14