COUNTY SURVEYORS FILE DATA
DO NOT REMOVE FROM OFFICE

PROPETY SURVEY

Portions of Sections 31 & 32, T. 24 S., R. 7 W., W. M.

Surveyed for B. N. GLANVILLE

November 1970 Scale 1" = 400'

FILED
RECEIVED
NOV 17 1970
COUNTY SURVEYOR
DOUGLAS COUNTY, ORE.

M 40-58

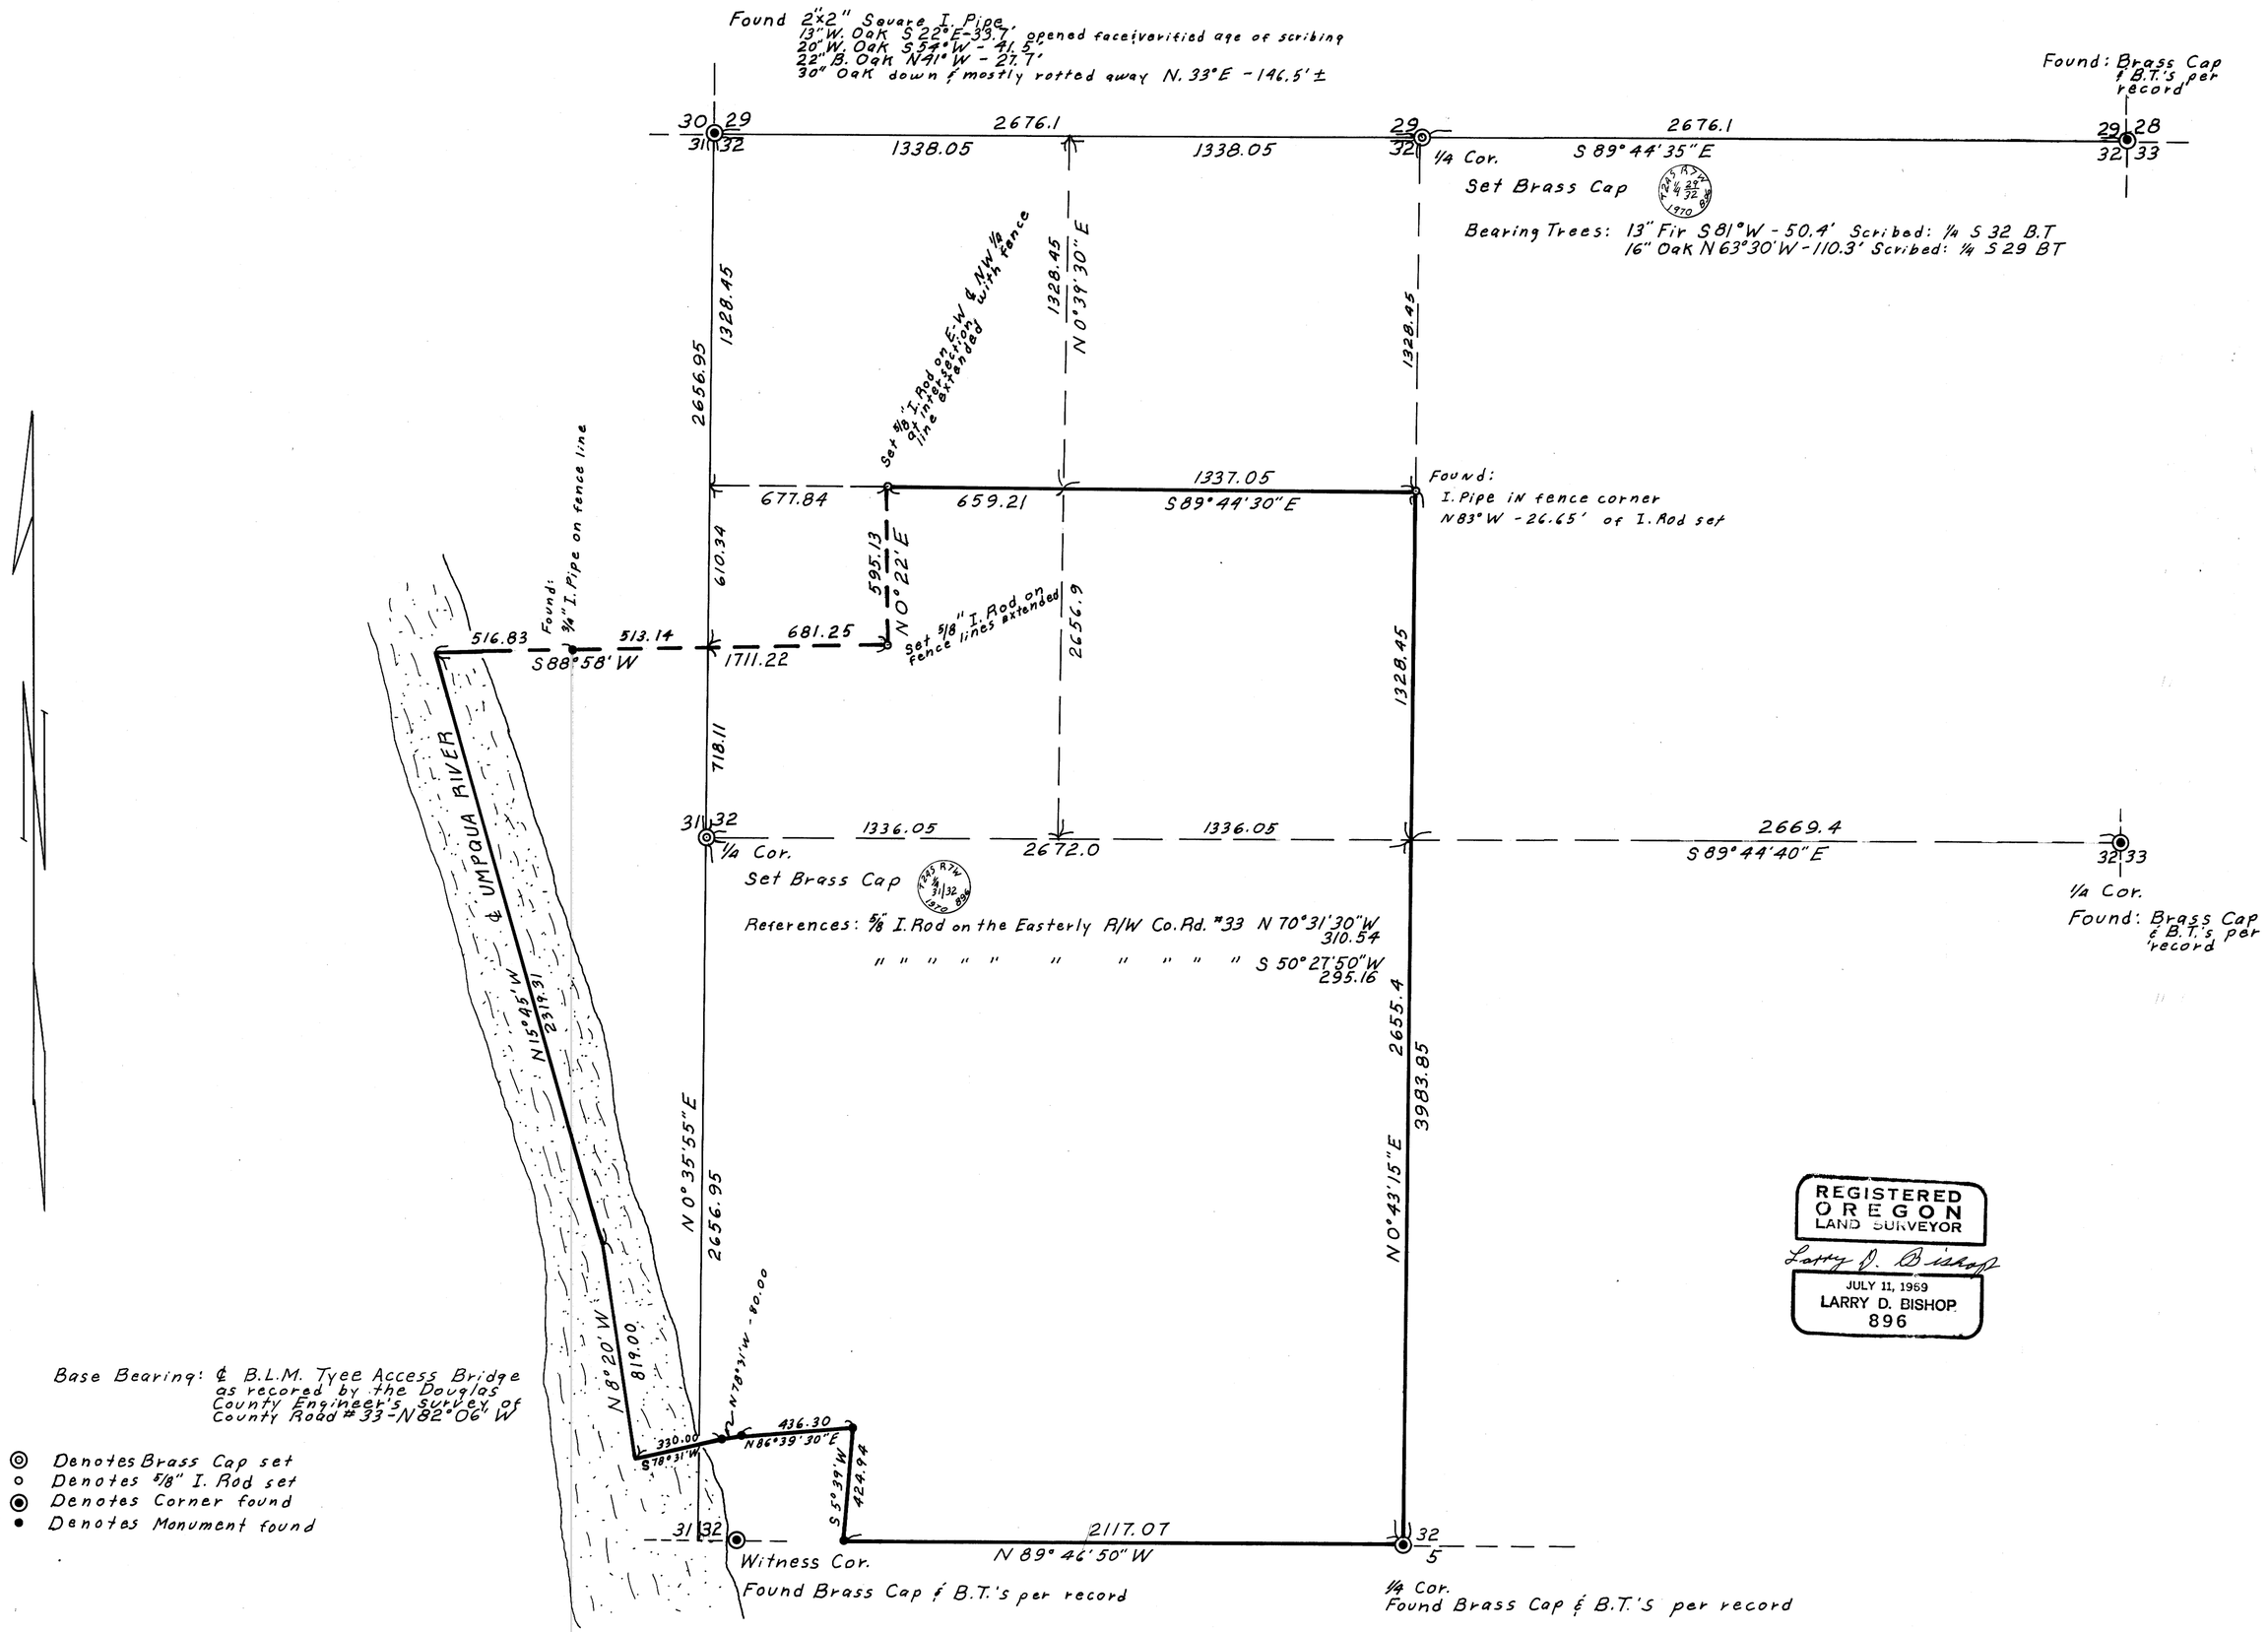

M 40-58