COUNTY SURVEYORS FILE DATA
DO NOT REMOVE FROM OFFICE

FILED
RECEIVED
JUL 29 1970
COUNTY SURVEYOR
DOUGLAS COUNTY, OREGON

M 40 - 7

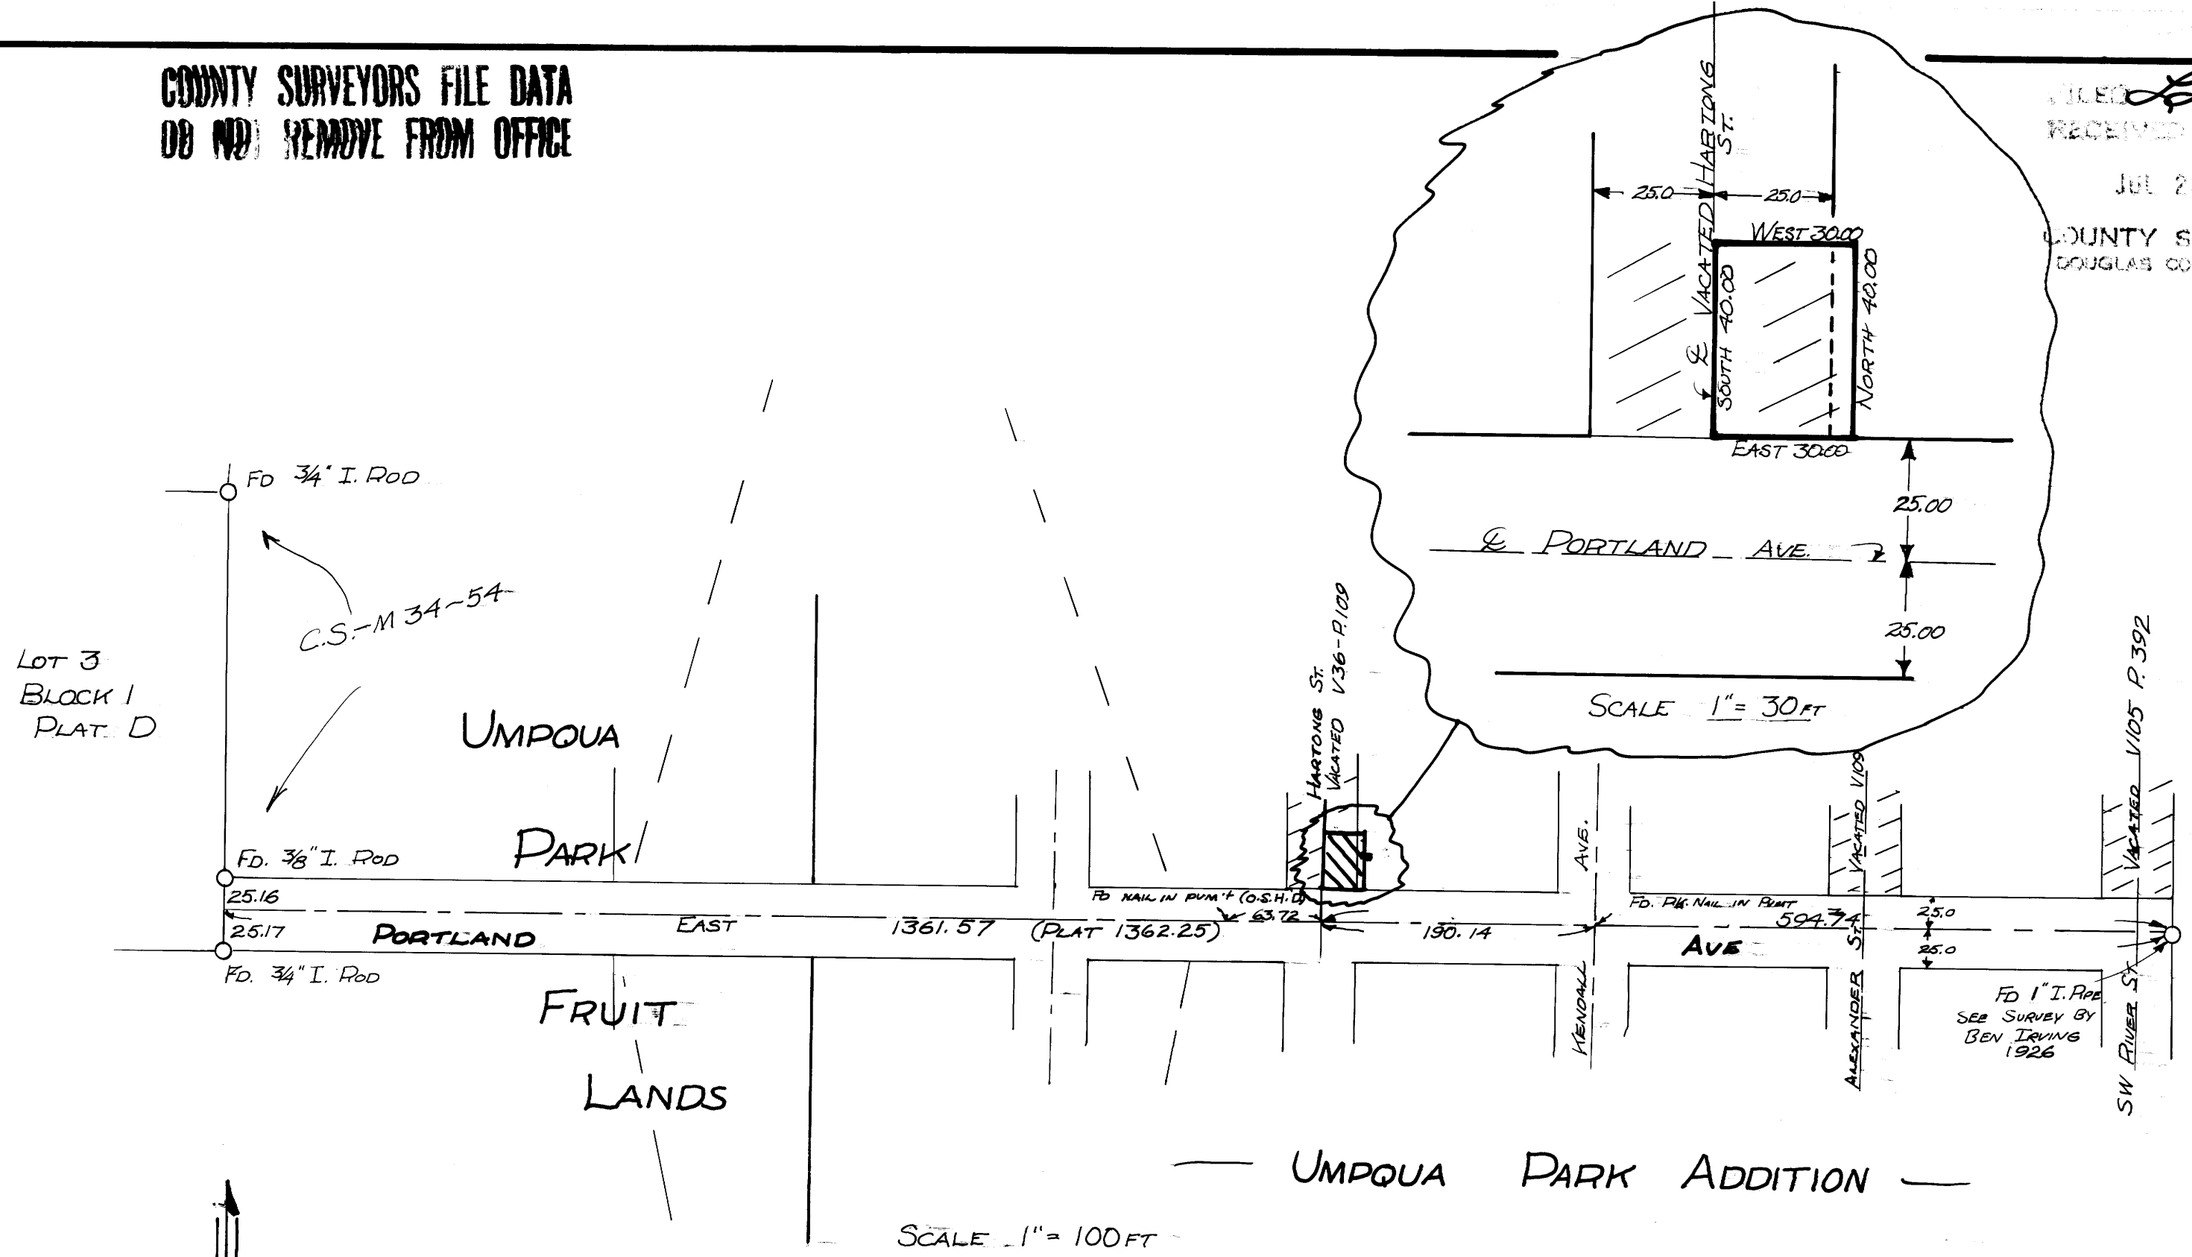

FIELD SURVEY & PLAT FOR

OREGON WATER CORP.

REGISTERED
OREGON
LAND SURVEYOR
JULY 12, 1968
DONALD A. BENTZ
839

PORTION OF VACATED HARTONG STREET AND LOT 8 BLOCK 3 UMPQUA PARK ADDITION IN SEC 25 T27S R6W W.M. DOUGLAS COUNTY, OREGON

SCALE : AS SHOWN

BASE BEARING ~ PORTLAND AVENUE DUE EAST

DONALD A. BENTZ L.S. JULY 1970

M 40 - 7