COUNTY SURVEYORS FILE DATA
DO NOT REMOVE FROM OFFICE

FILED
RECEIVED
DEC 9
COUNTY SURVEYOR
DOUGLAS COUNTY, OREGON

M 40-71

SURVEY IN SECTION 23, TOWNSHIP 26 SOUTH, RANGE 4 WEST, WILLAMETTE MERIDIAN

Surveyed for Fritz Sterchi & John Connine by Don E. Garrett

December 1970

Scale 1" = 200'

○ - Set 5/8" I. Rod
● - Found 3/4" I. Rod
Bearings are based on a solar observation taken November 24, 1970.

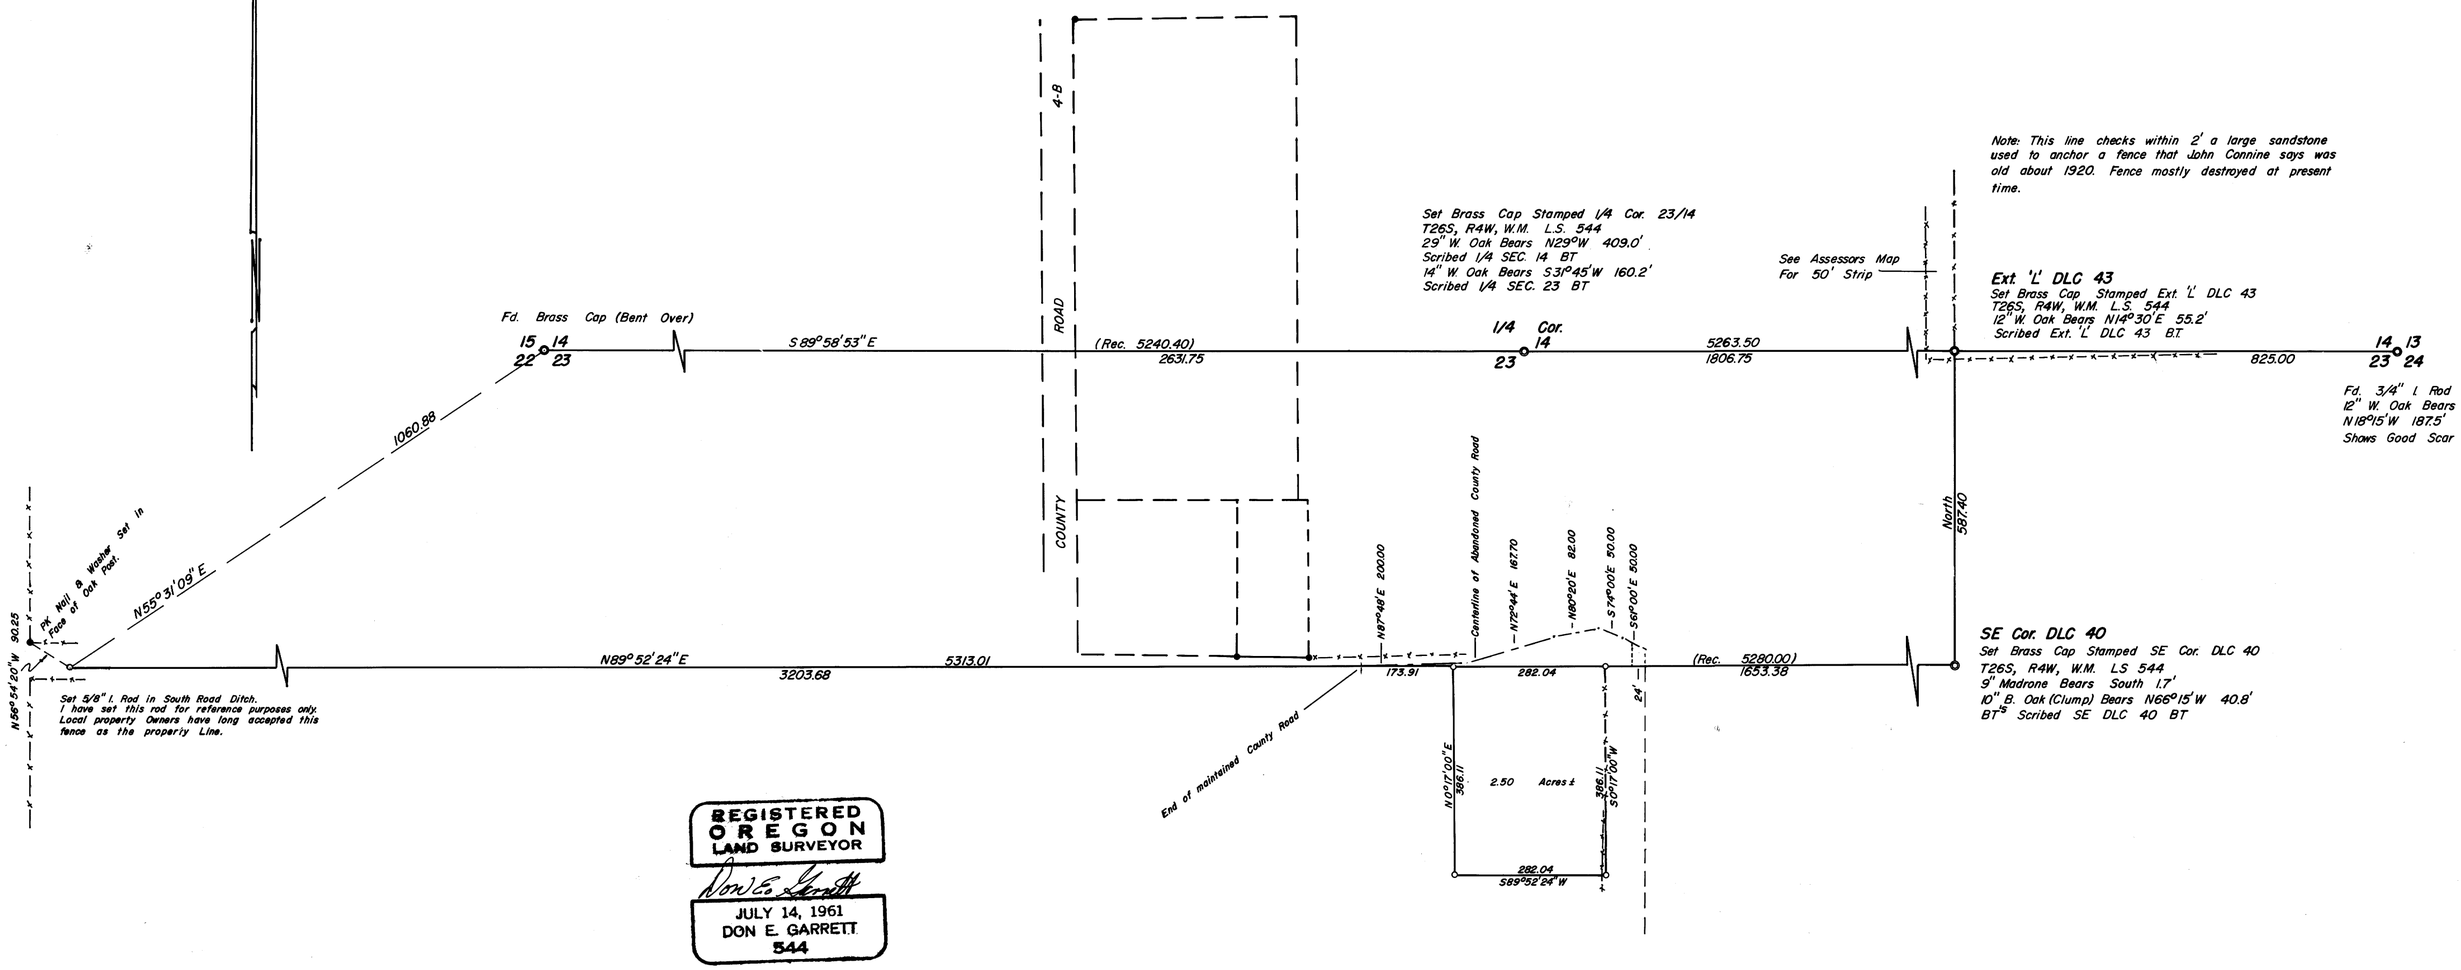

REGISTERED
OREGON
LAND SURVEYOR
Don E. Garrett
JULY 14, 1961
DON E. GARRETT
544

MAP FILE M 40-71