COUNTY SURVEYORS FILE DATA
DO NOT REMOVE FROM OFFICE

FILED
RECEIVED
DEC 16 1970
COUNTY SURVEYOR
DOUGLAS COUNTY, ORE.

M 40 - 75




● - Found 3/4" I. Rod
○ - Set 5/8" I. Rod

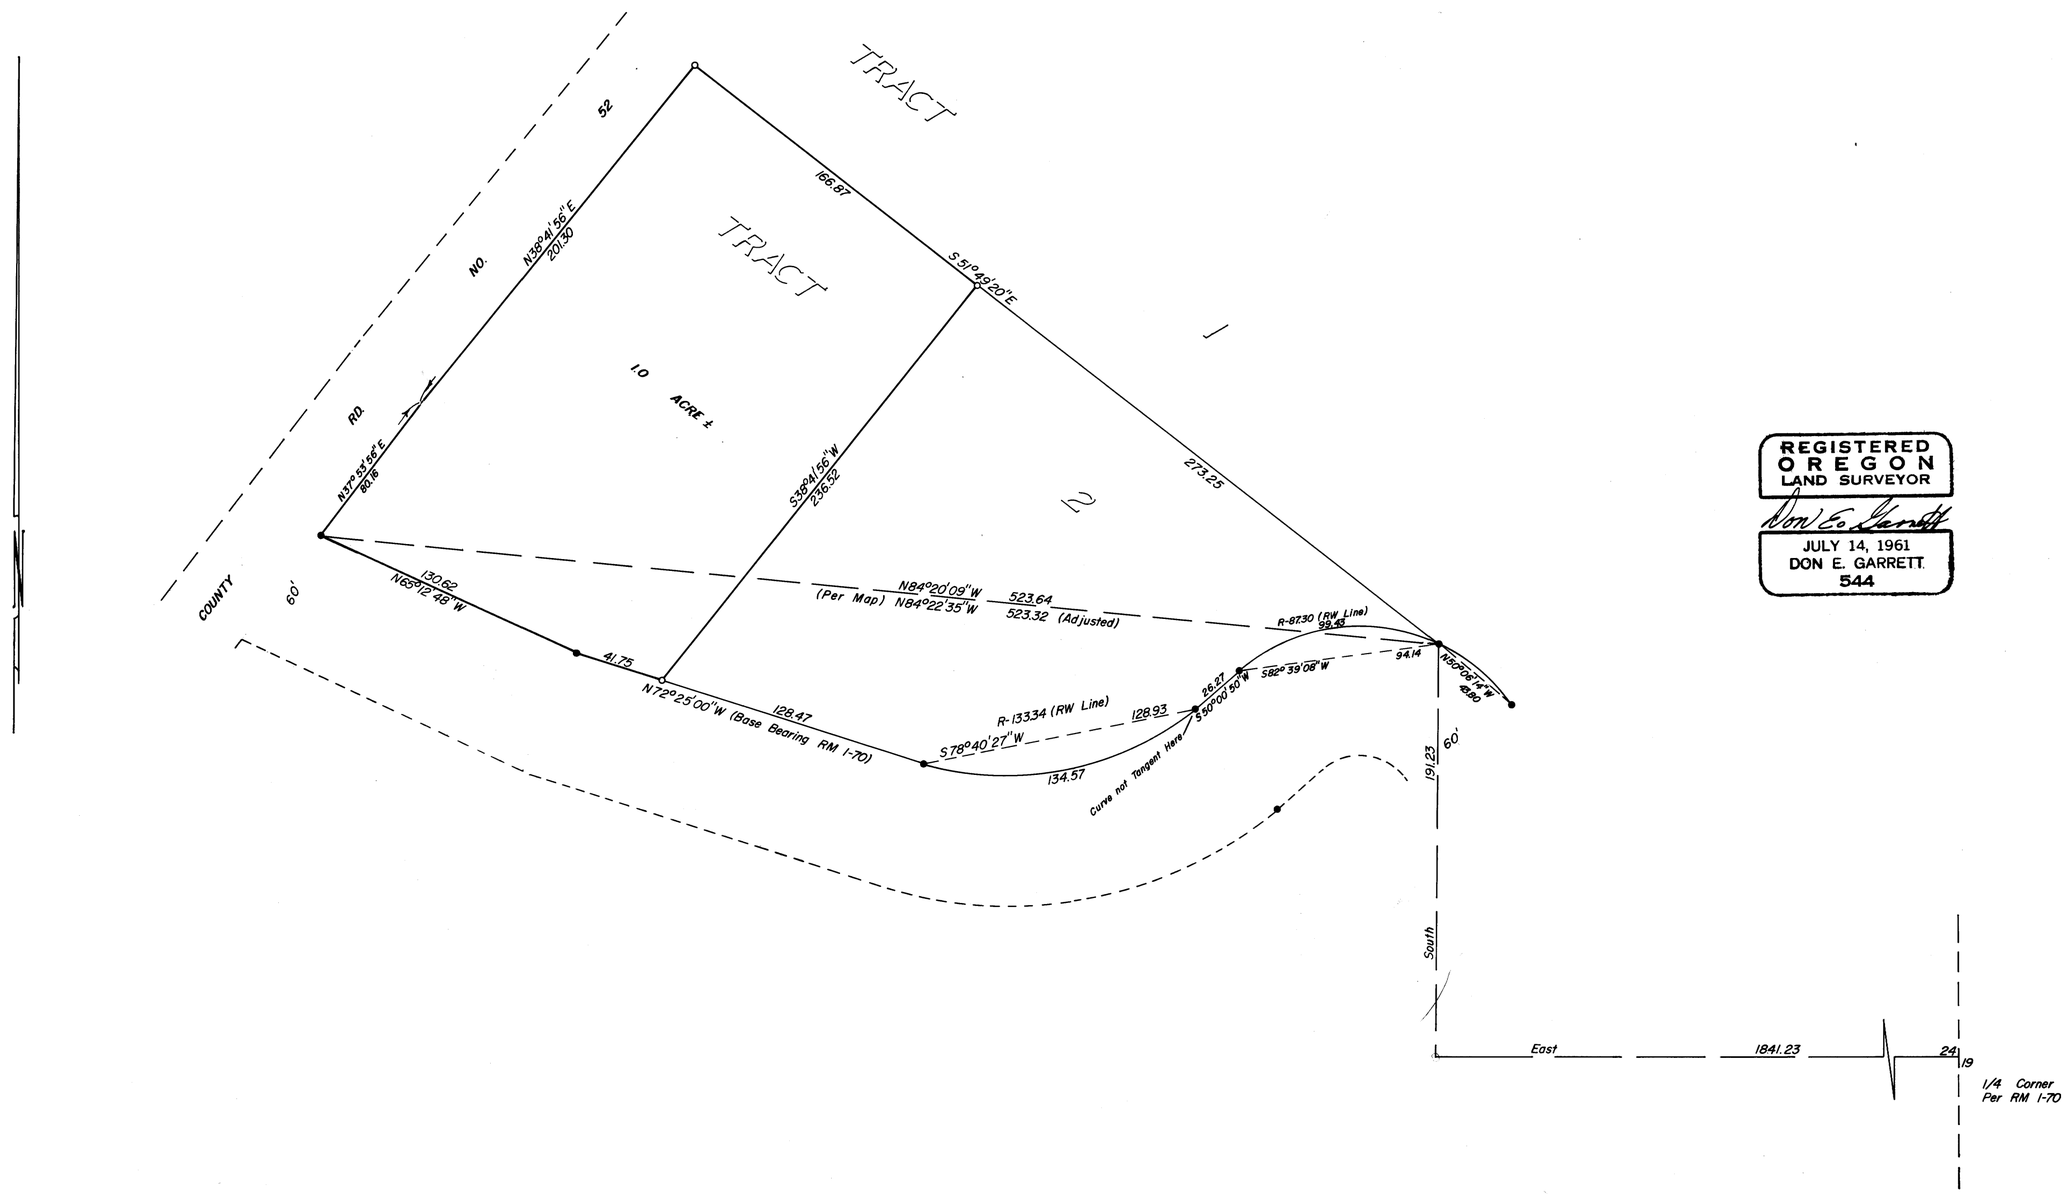

REGISTERED
OREGON
LAND SURVEYOR
Don E. Garrett
JULY 14, 1961
DON E. GARRETT
544

M 40 - 75