COUNTY SURVEYORS FILE DATA
DO NOT REMOVE FROM OFFICE

M 40 - 78

SURVEY IN SECTION 19, T25S, R5W, W.M.

Surveyed for Sam and Neta Robinson by Victor M. McLind

DECEMBER 1970 SCALE: 1" = 50'

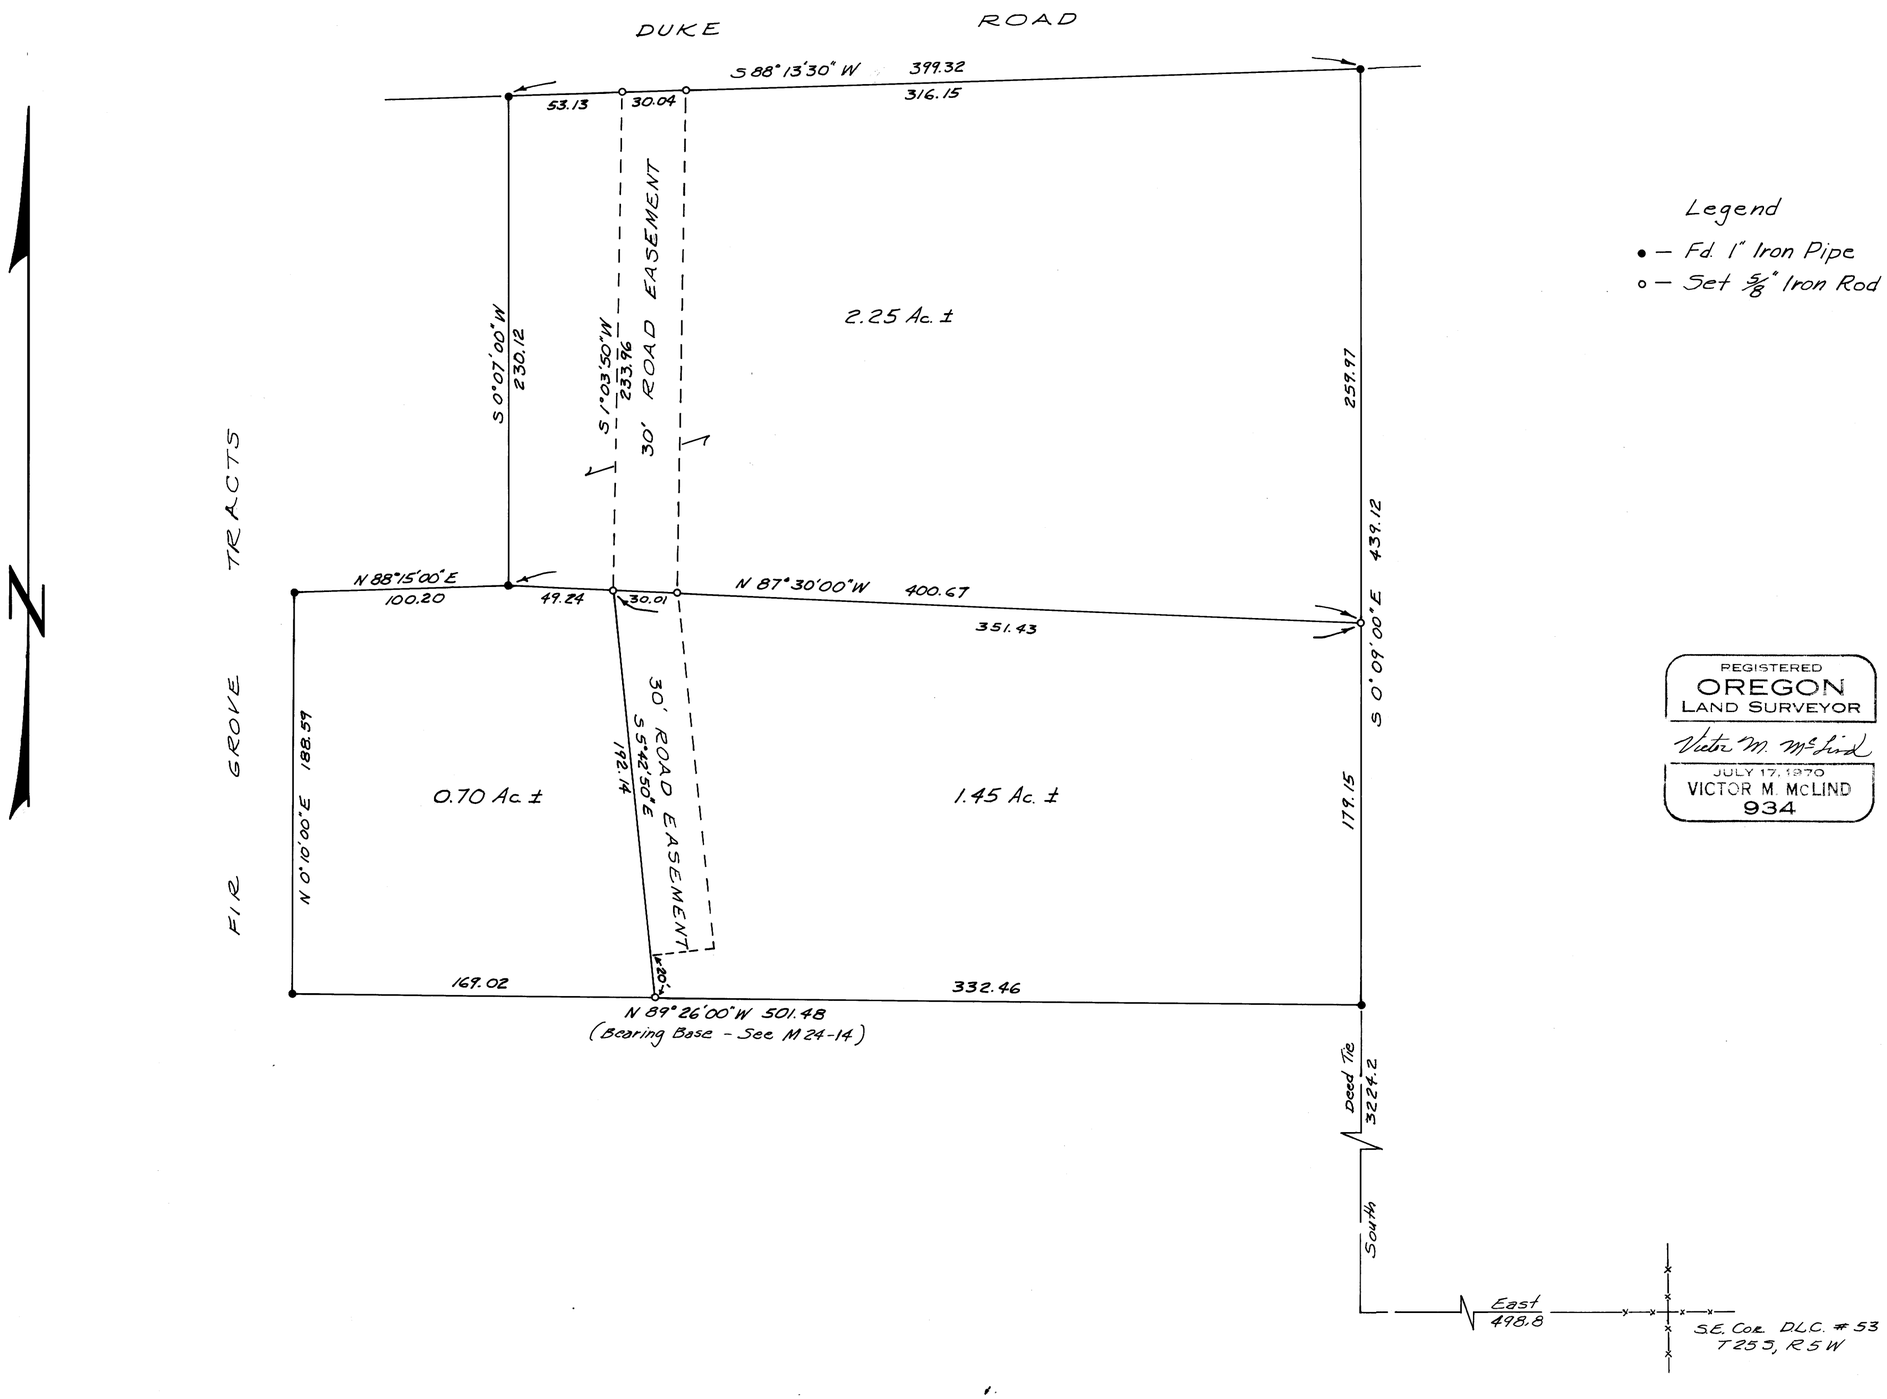

M 40 - 78