M 41 - 13

COUNTY SURVEYORS FILE DATA
DO NOT REMOVE FROM OFFICE

SURVEY IN SECTION 4, T25S, R5W, W.M.

Surveyed for Arthur & Laura Copeland by Victor M. McLind

Feb. 1971 Scale: 1" = 100'

FILED
RECEIVED
FEB 16 1971
COUNTY SURVEYOR
DOUGLAS COUNTY, ORE.

o – Set ½" Iron Rod, Unless otherwise noted

• – Monument found as indicated

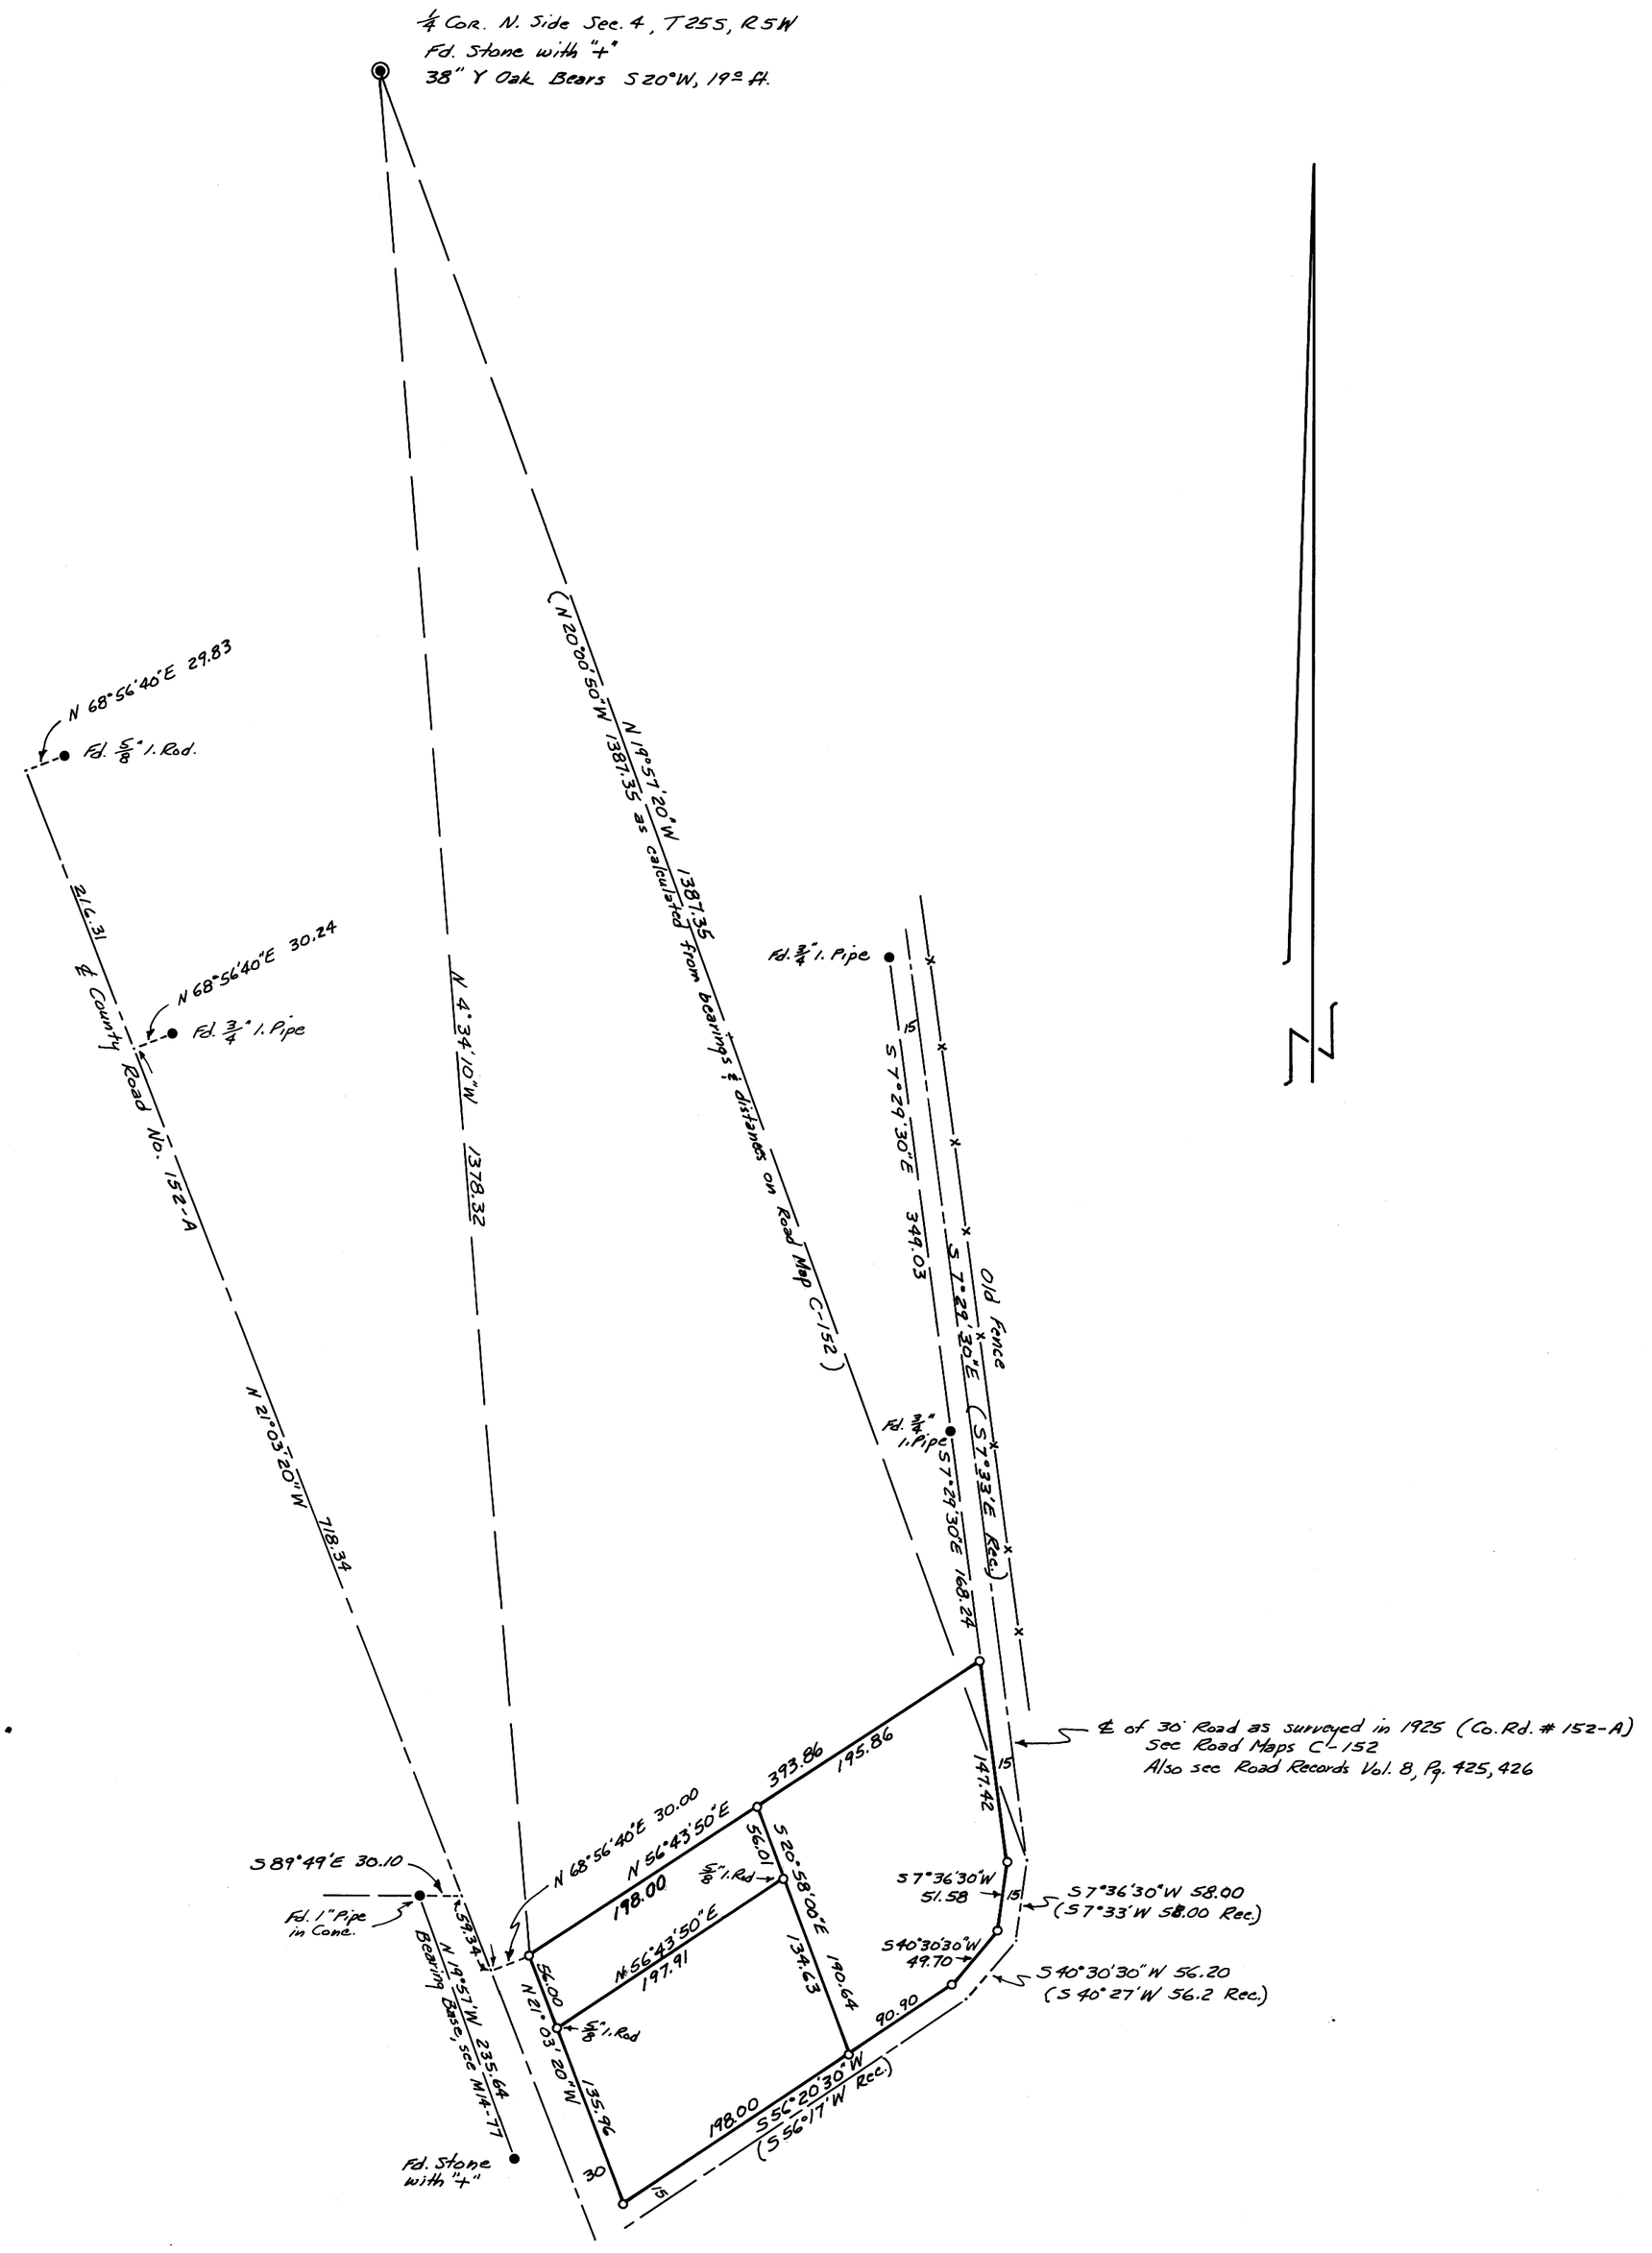

Victor M. McLind

MAP FILE M 41 - 13