M41-15

COUNTY SURVEYORS FILE DA
DO NOT REMOVE FROM OFFIC

FILED
RECEIVED
FEB 17 1971
COUNTY SURVEYOR
DOUGLAS COUNTY, ORE.

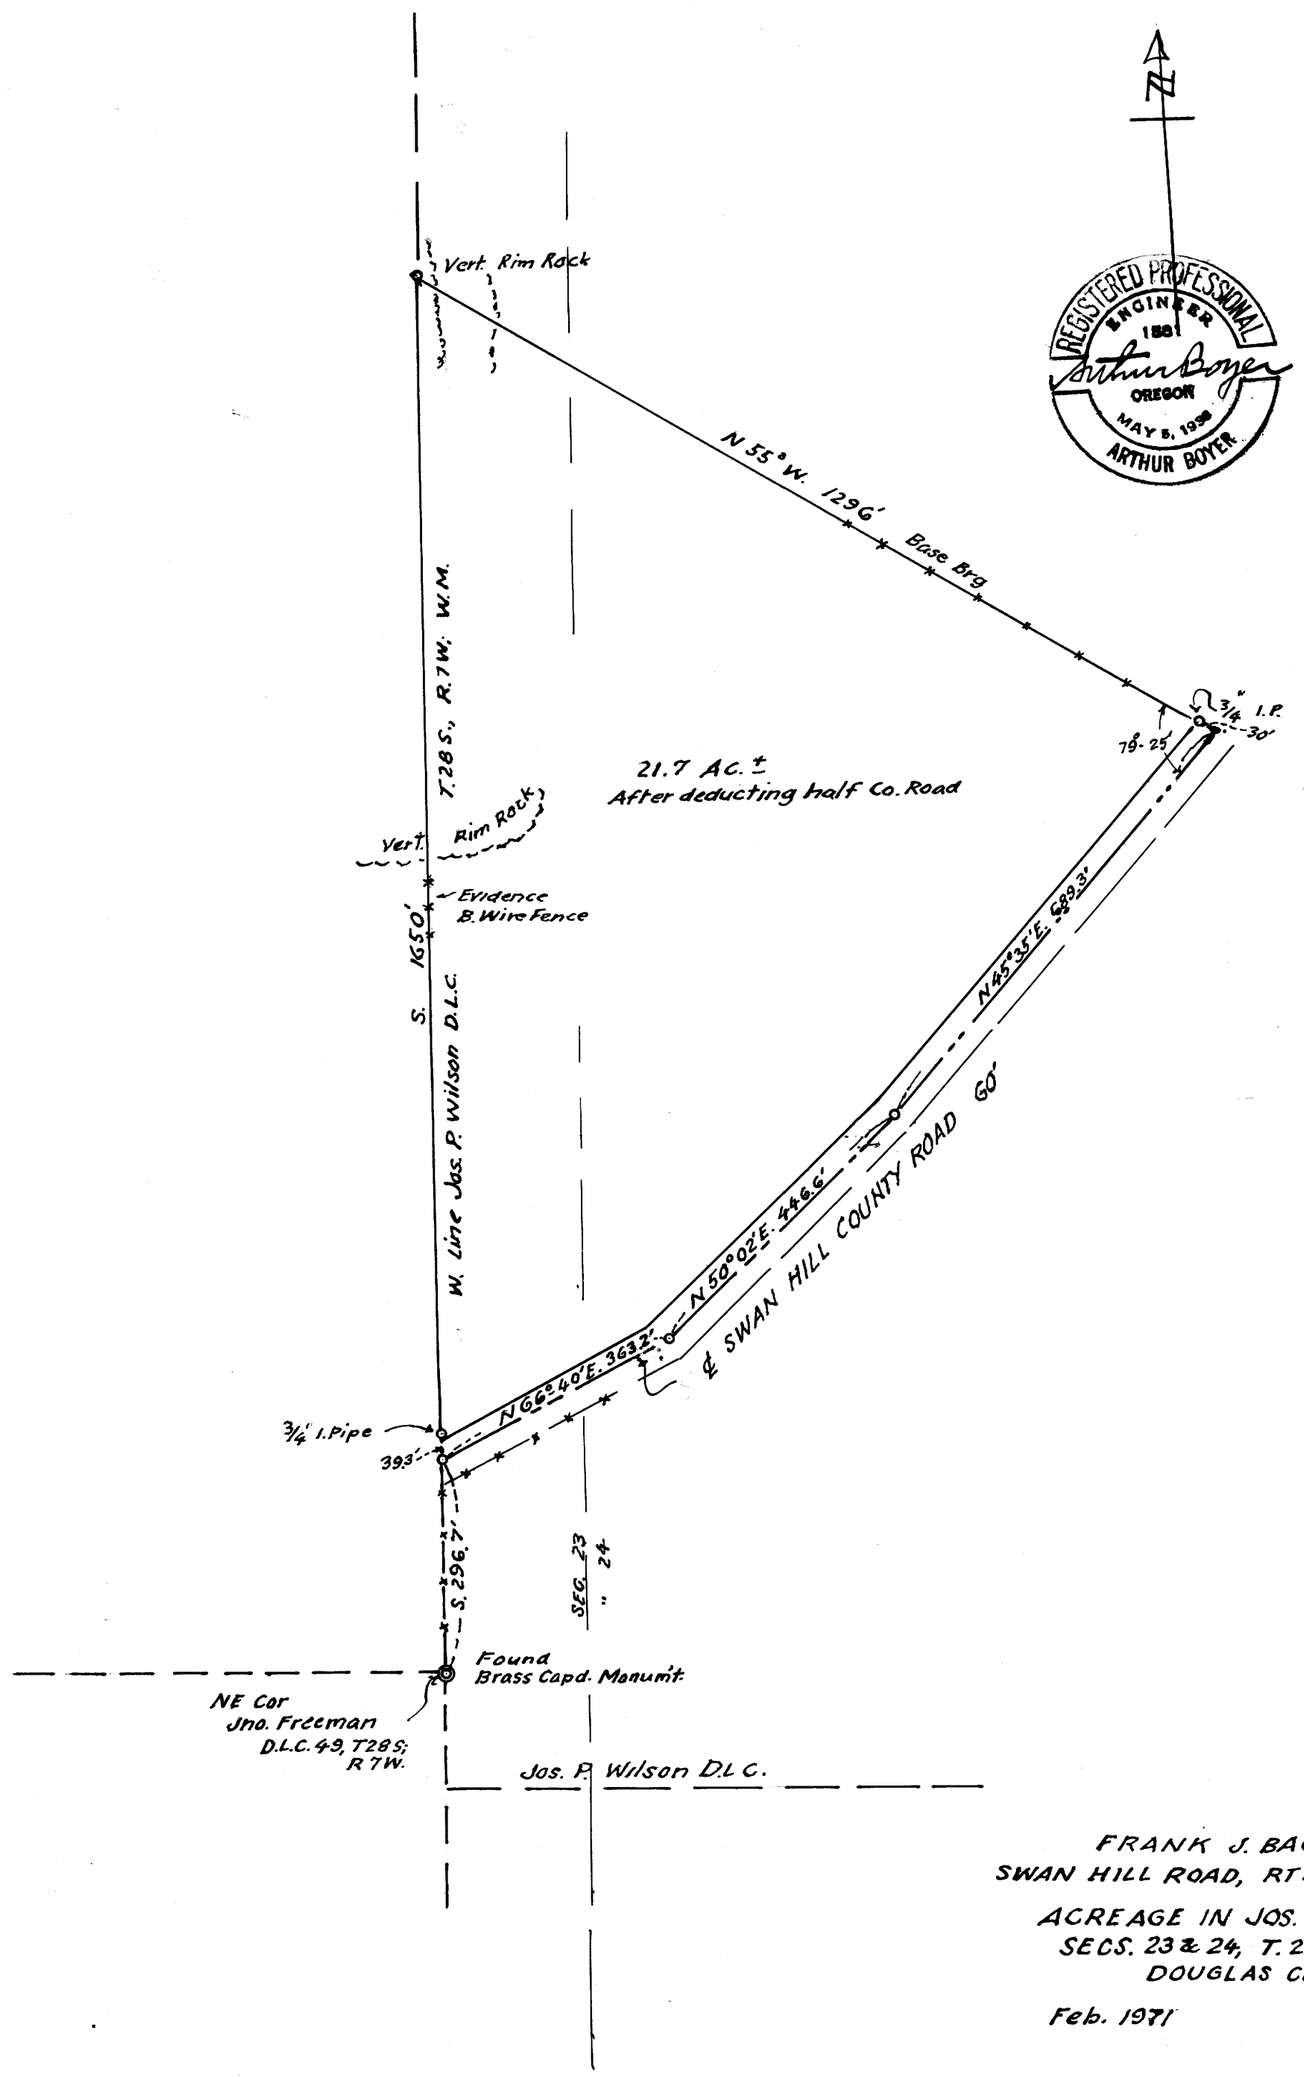

REGISTERED PROFESSIONAL ENGINEER 1581 Arthur Boyer OREGON MAY 5, 1958 ARTHUR BOYER

FRANK J. BAUER
SWAN HILL ROAD, RT 4, BOX 567, ROSEBURG, ORE.

ACREAGE IN JOS. P. WILSON D.L.C. IN
SECS. 23 & 24, T. 28S; R.7W; WIL.MER.
DOUGLAS COUNTY, ORE.

Feb. 1971 1" = 200'

MAP FILE M41-15