M 41-22

COUNTY SURVEYOR'S FILE COPY
DO NOT REMOVE FROM OFFICE

SURVEY IN SEC. 16, T 24 S, R 7 W, W.M.
DOUGLAS COUNTY, ORE.

SURVEYED FOR - DOUG. BROWNSON MAR. 1971
SURVEYED BY - W. S. BARNES SCALE 1"=400'

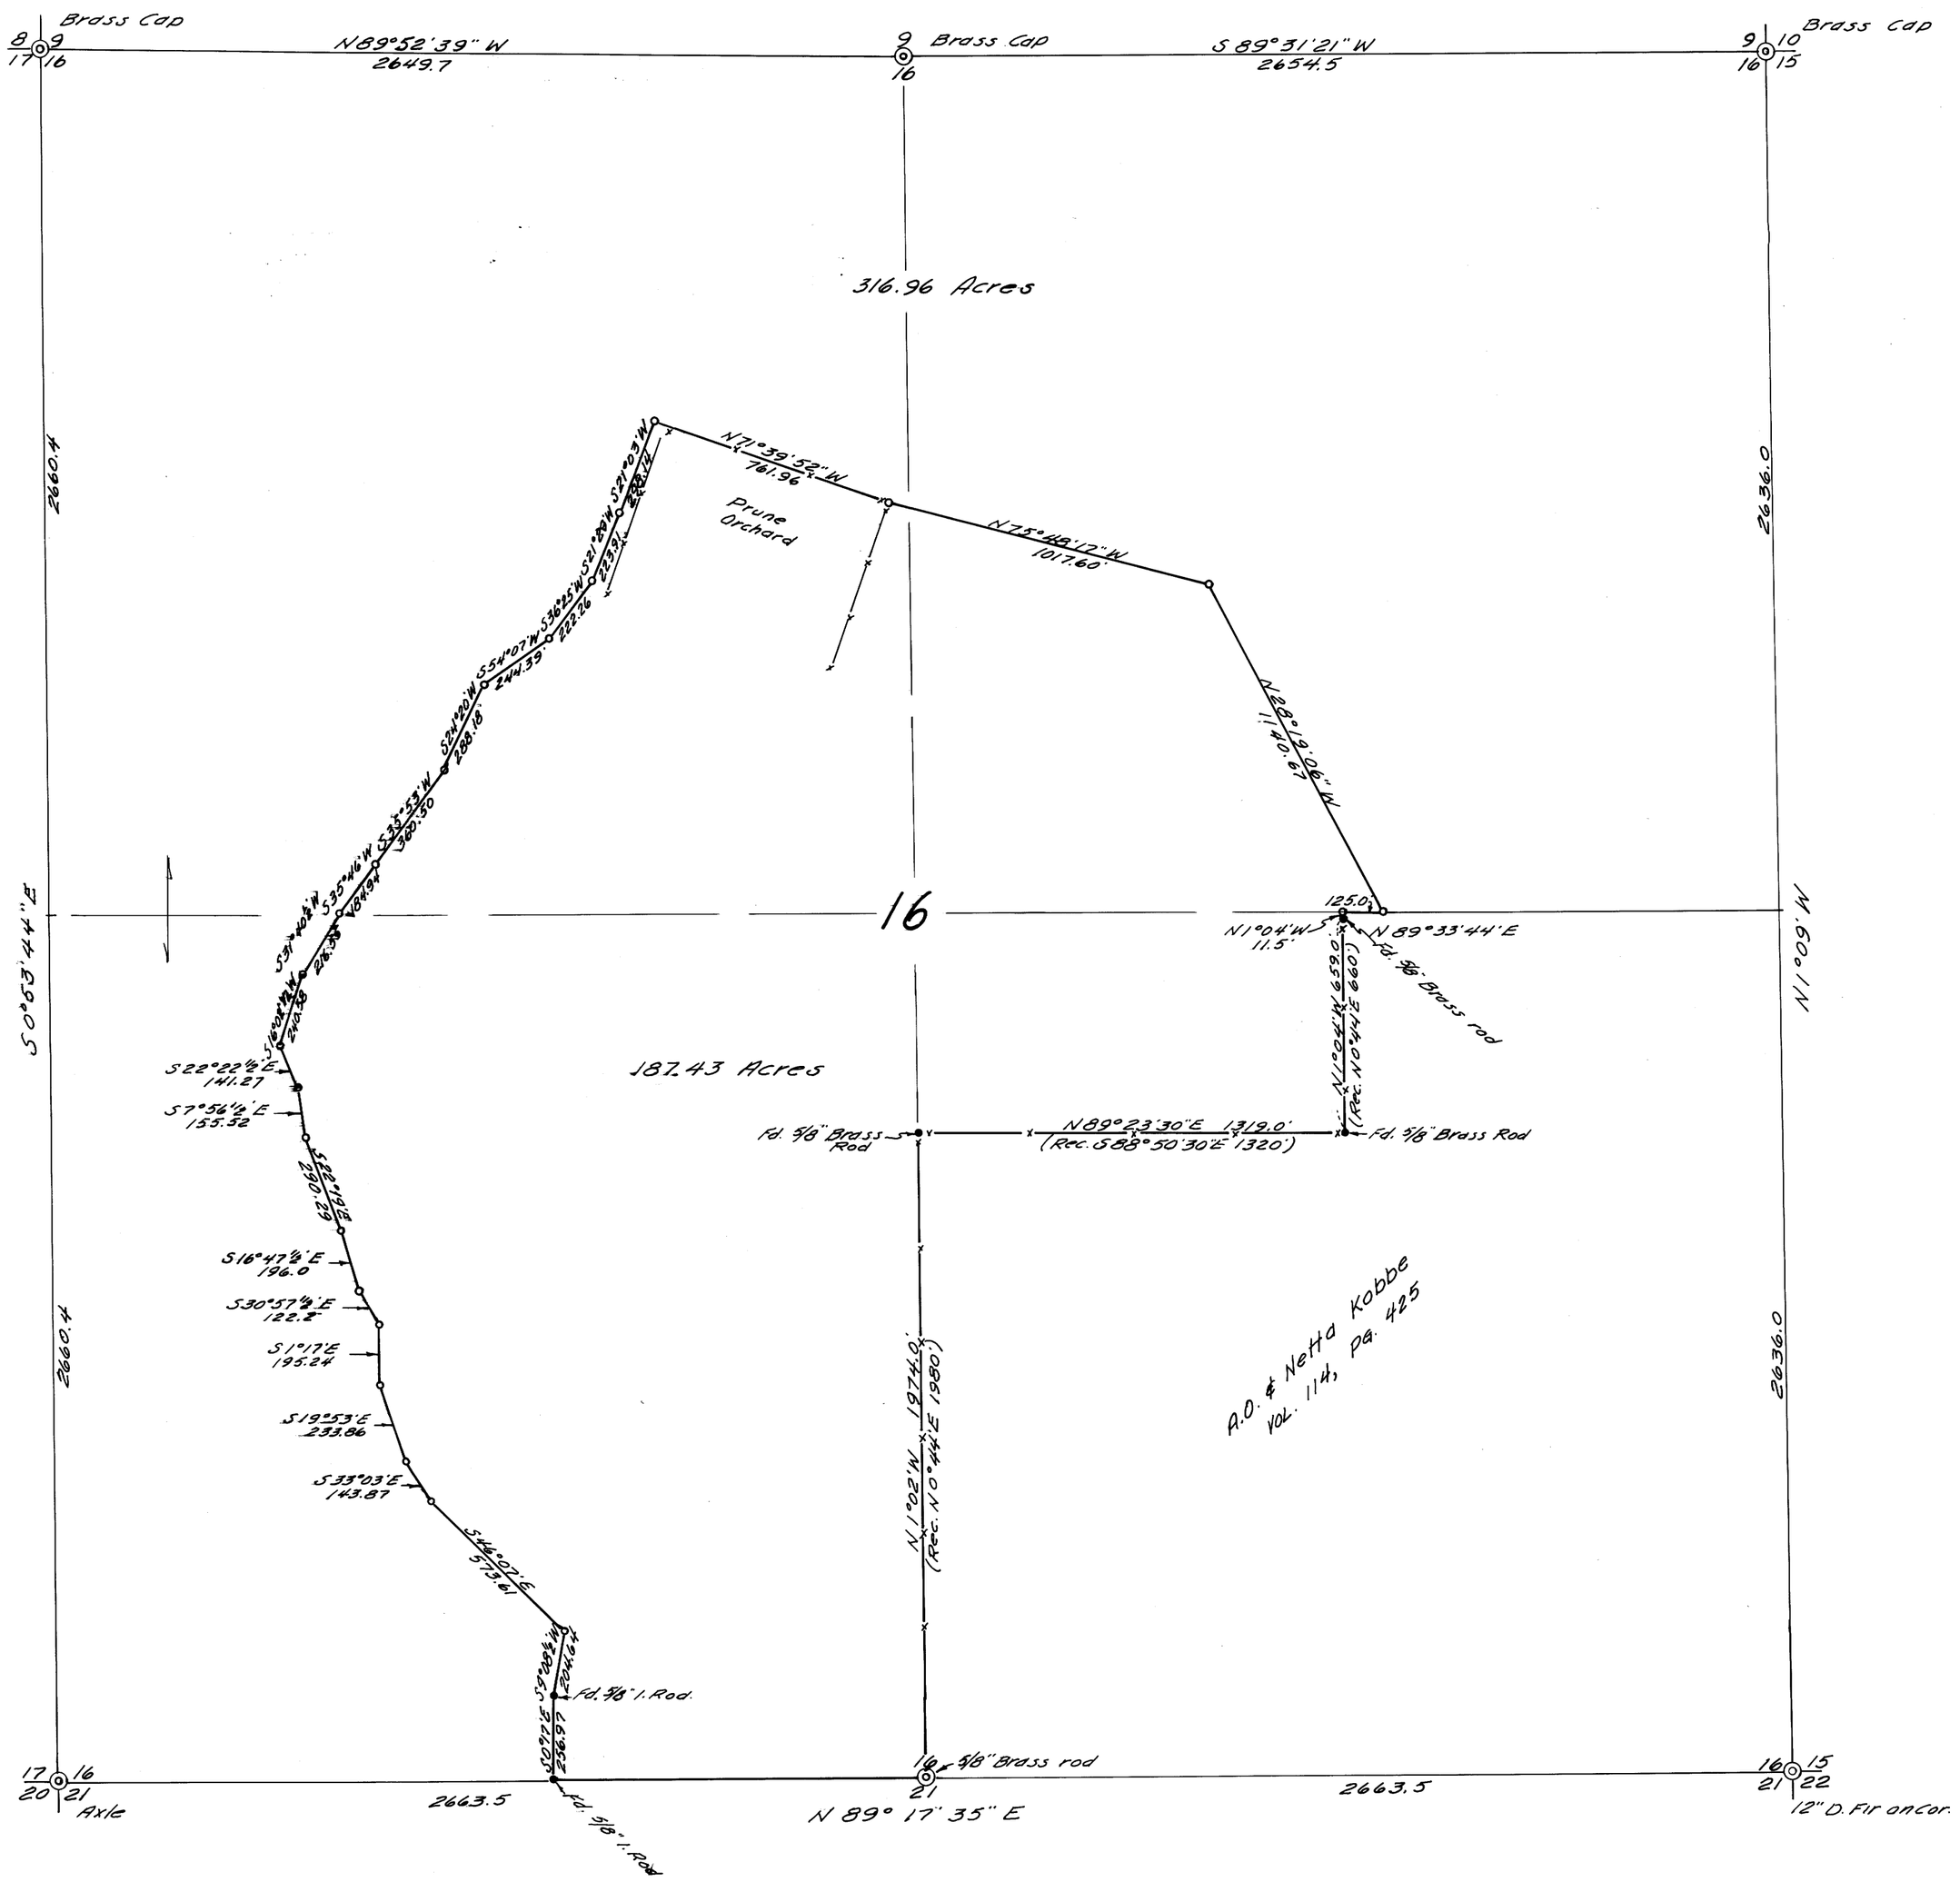

o 3/4" Iron rods set.

• Monuments found

Base bearing taken from South line of Sec. 16.

REGISTERED PROFESSIONAL ENGINEER 2128 W. S. Barnes OREGON SEPT. 5, 1941 William S. Barnes

M 41-22