SURVEY TO LOCATE & SET PROPERTY CORNERS FOR DESCRIPTIONS FOR ARGOS & NELLIE FISHER IN HENRY EVANS D.L.C. #43, SEC. 27, T. 26 S., R. 6 W., W.M., DOUGLAS COUNTY, ORE.

SURVEY BY HERBERT L. NORTHCRAFT L.S.

SCALE 1" = 100'

MAR. '71

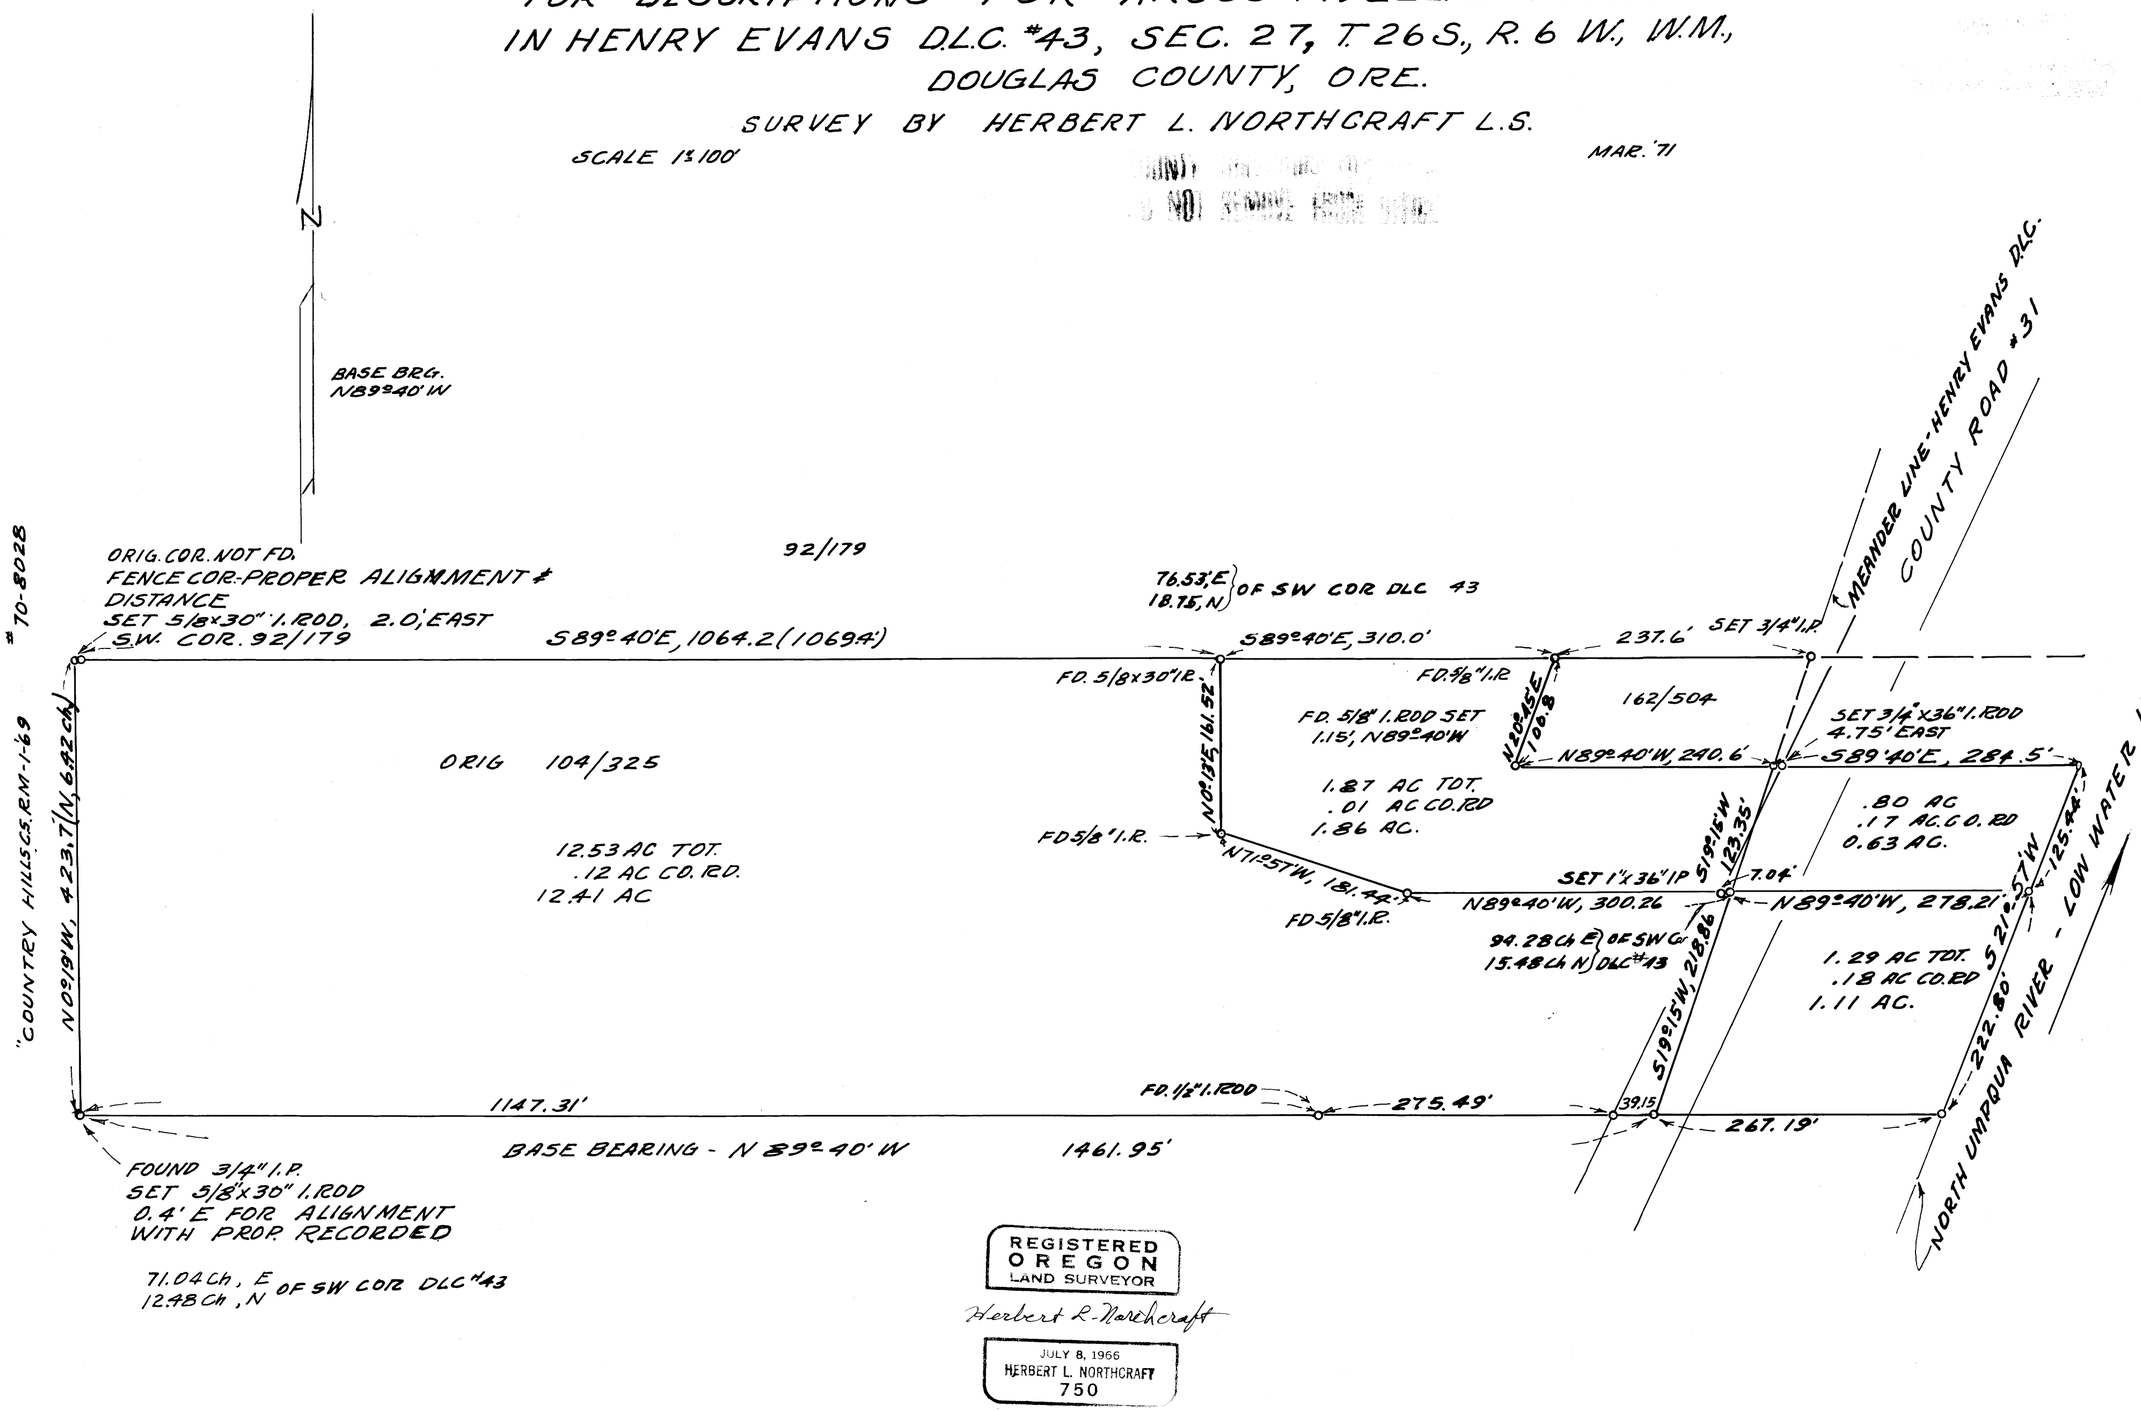

REGISTERED
OREGON
LAND SURVEYOR

Herbert L. Northcraft

JULY 8, 1966
HERBERT L. NORTHCRAFT
750

M 41 - 25