M #1-26

COUNTY SURVEYORS FILE DATA
DO NOT REMOVE FROM OFFICE

SURVEY IN SECTION 3, TOWNSHIP 27 SOUTH, RANGE 5 WEST, WILLAMETTE MERIDIAN

Surveyed for Earl Johnston by Don E. Garrett

March 1971

Scale 1" = 100'

FILED
RECEIVED
MAR 22 1971
COUNTY SURVEYOR
DOUGLAS COUNTY, ORE.

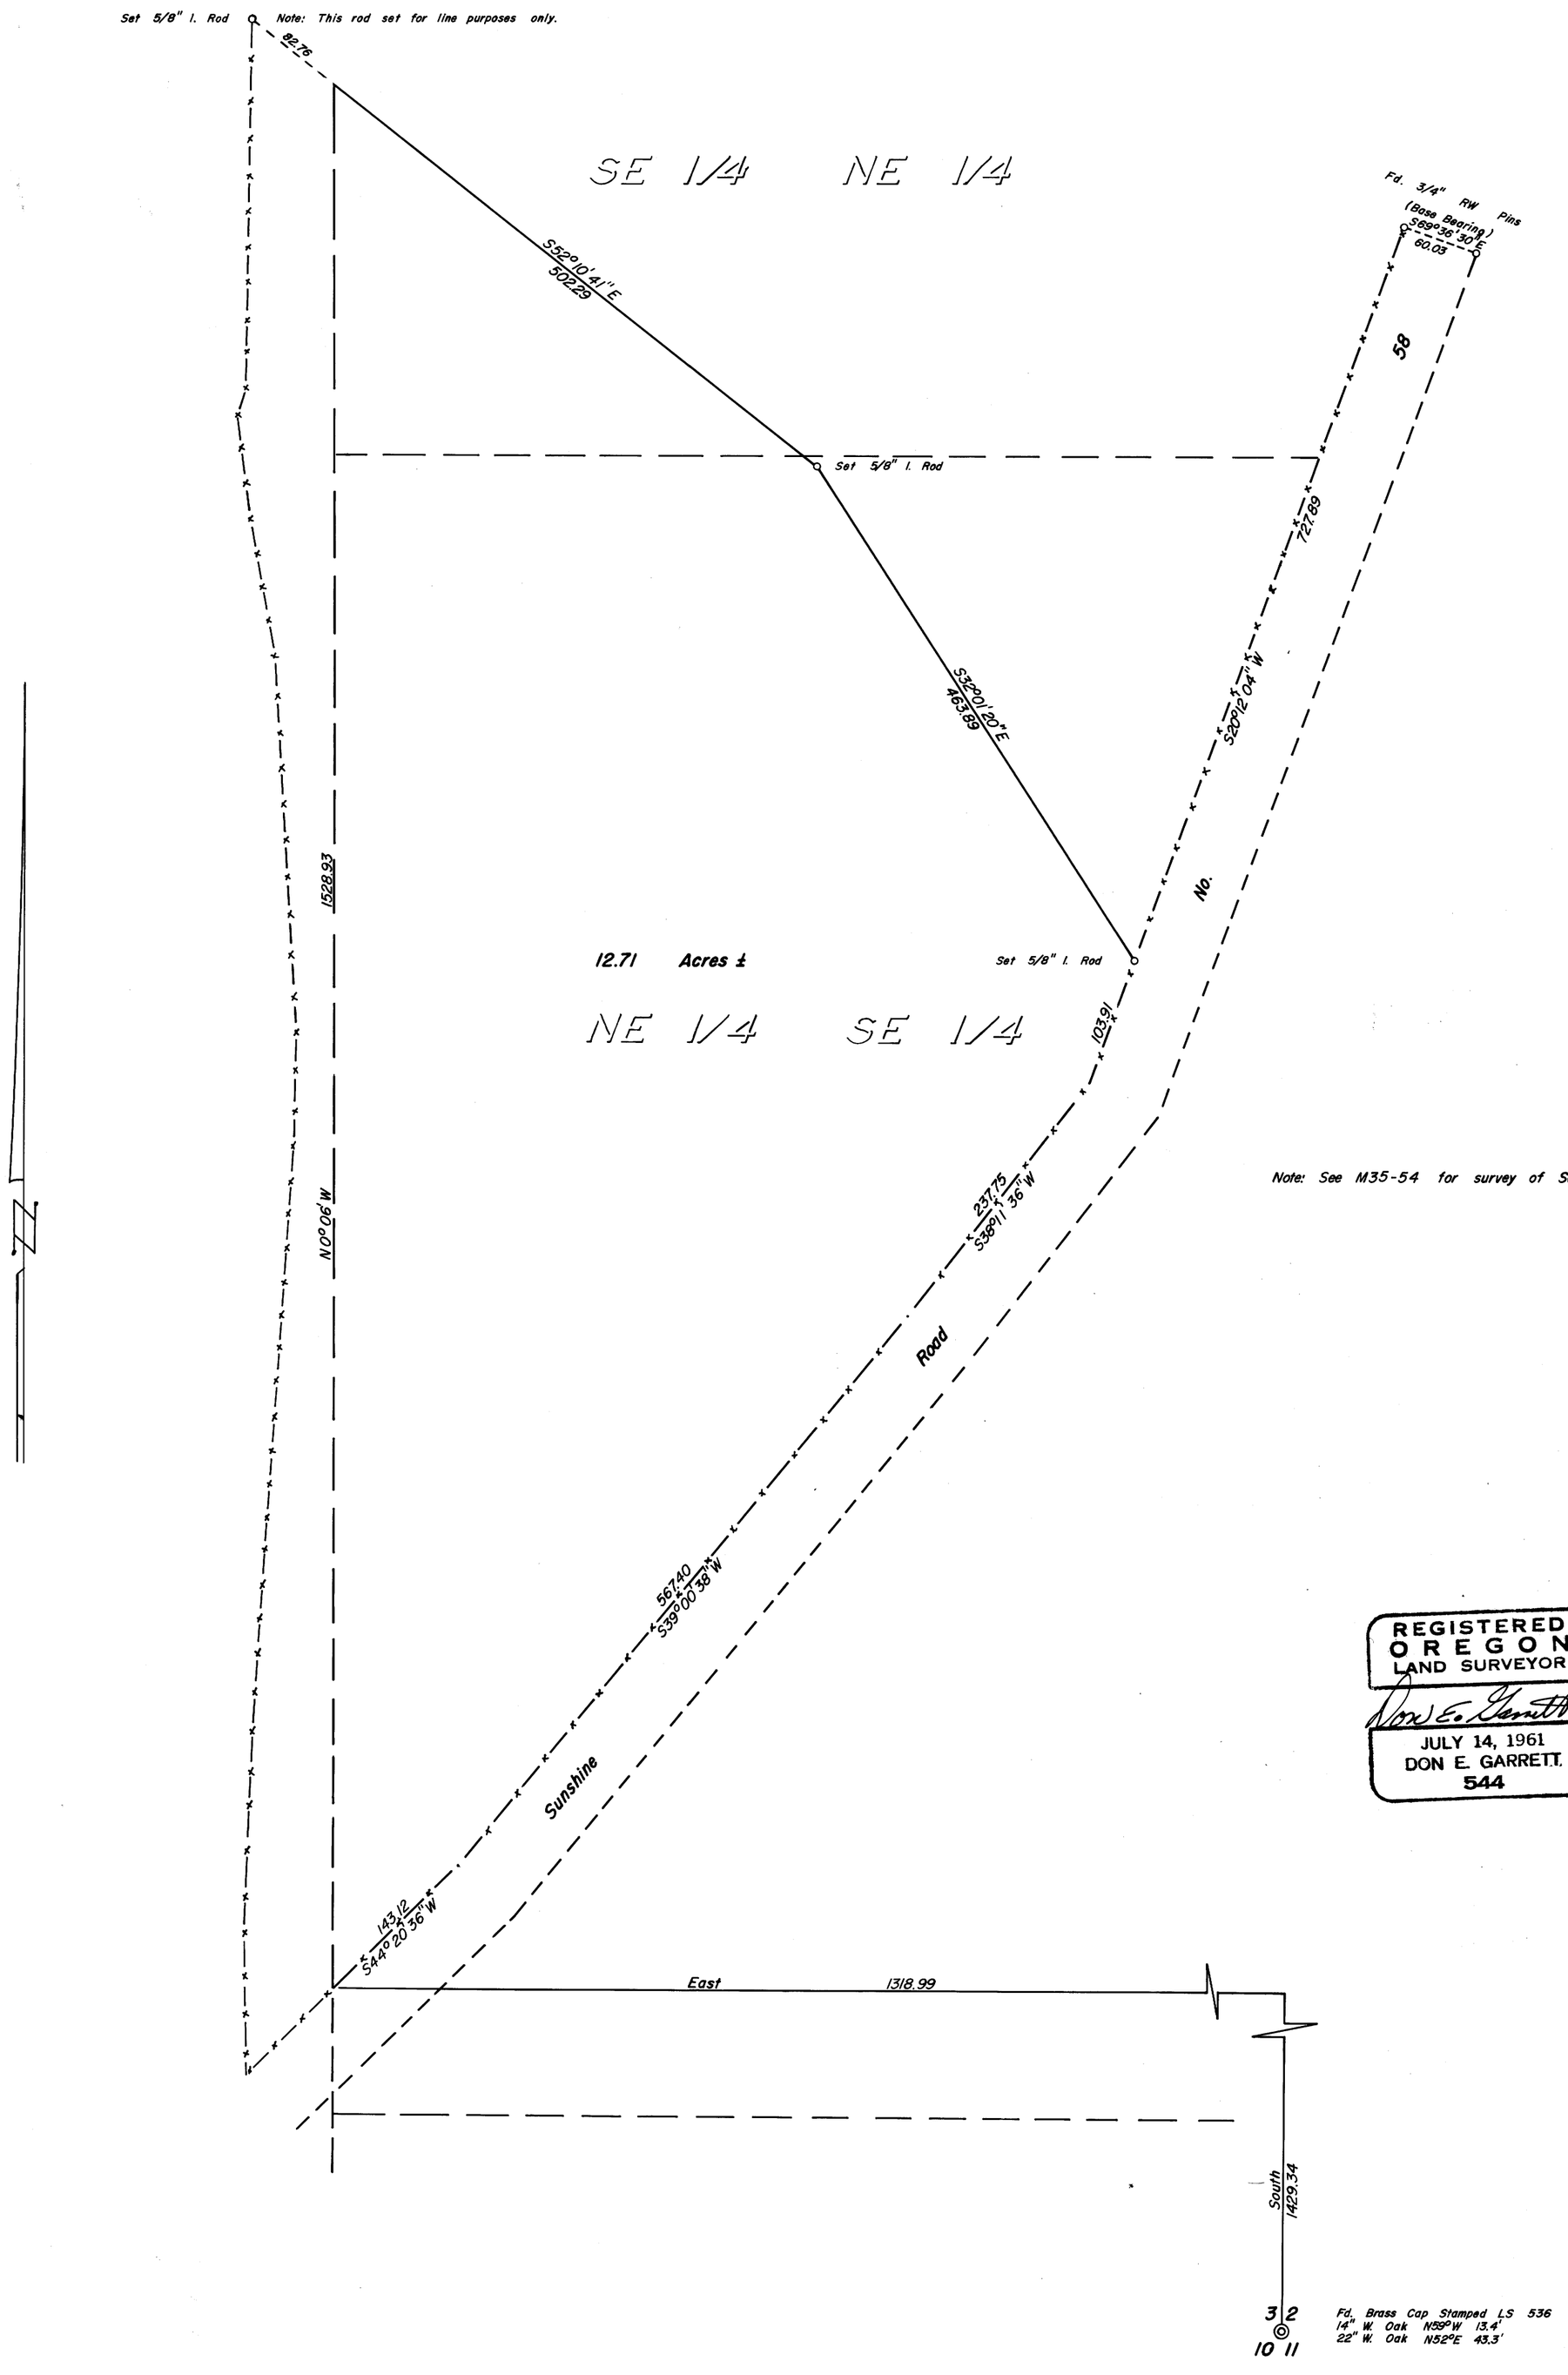

Note: See M35-54 for survey of Sect. 3.

REGISTERED
OREGON
LAND SURVEYOR
Don E. Garrett
JULY 14, 1961
DON E. GARRETT
544

M 41-26