M 41 - 28

COUNTY SURVEYORS FILE DATA
DO NOT REMOVE FROM OFFICE

SURVEY IN SECTION 13, TOWNSHIP 27 SOUTH, RANGE 7 WEST, WILLAMETTE MERIDIAN
Surveyed for Charles Church by Don E. Garrett
March 1971

Scale 1" = 100'

FILED
RECEIVED
MAR 22 1971
COUNTY SURVEYOR
DOUGLAS COUNTY, OREG.

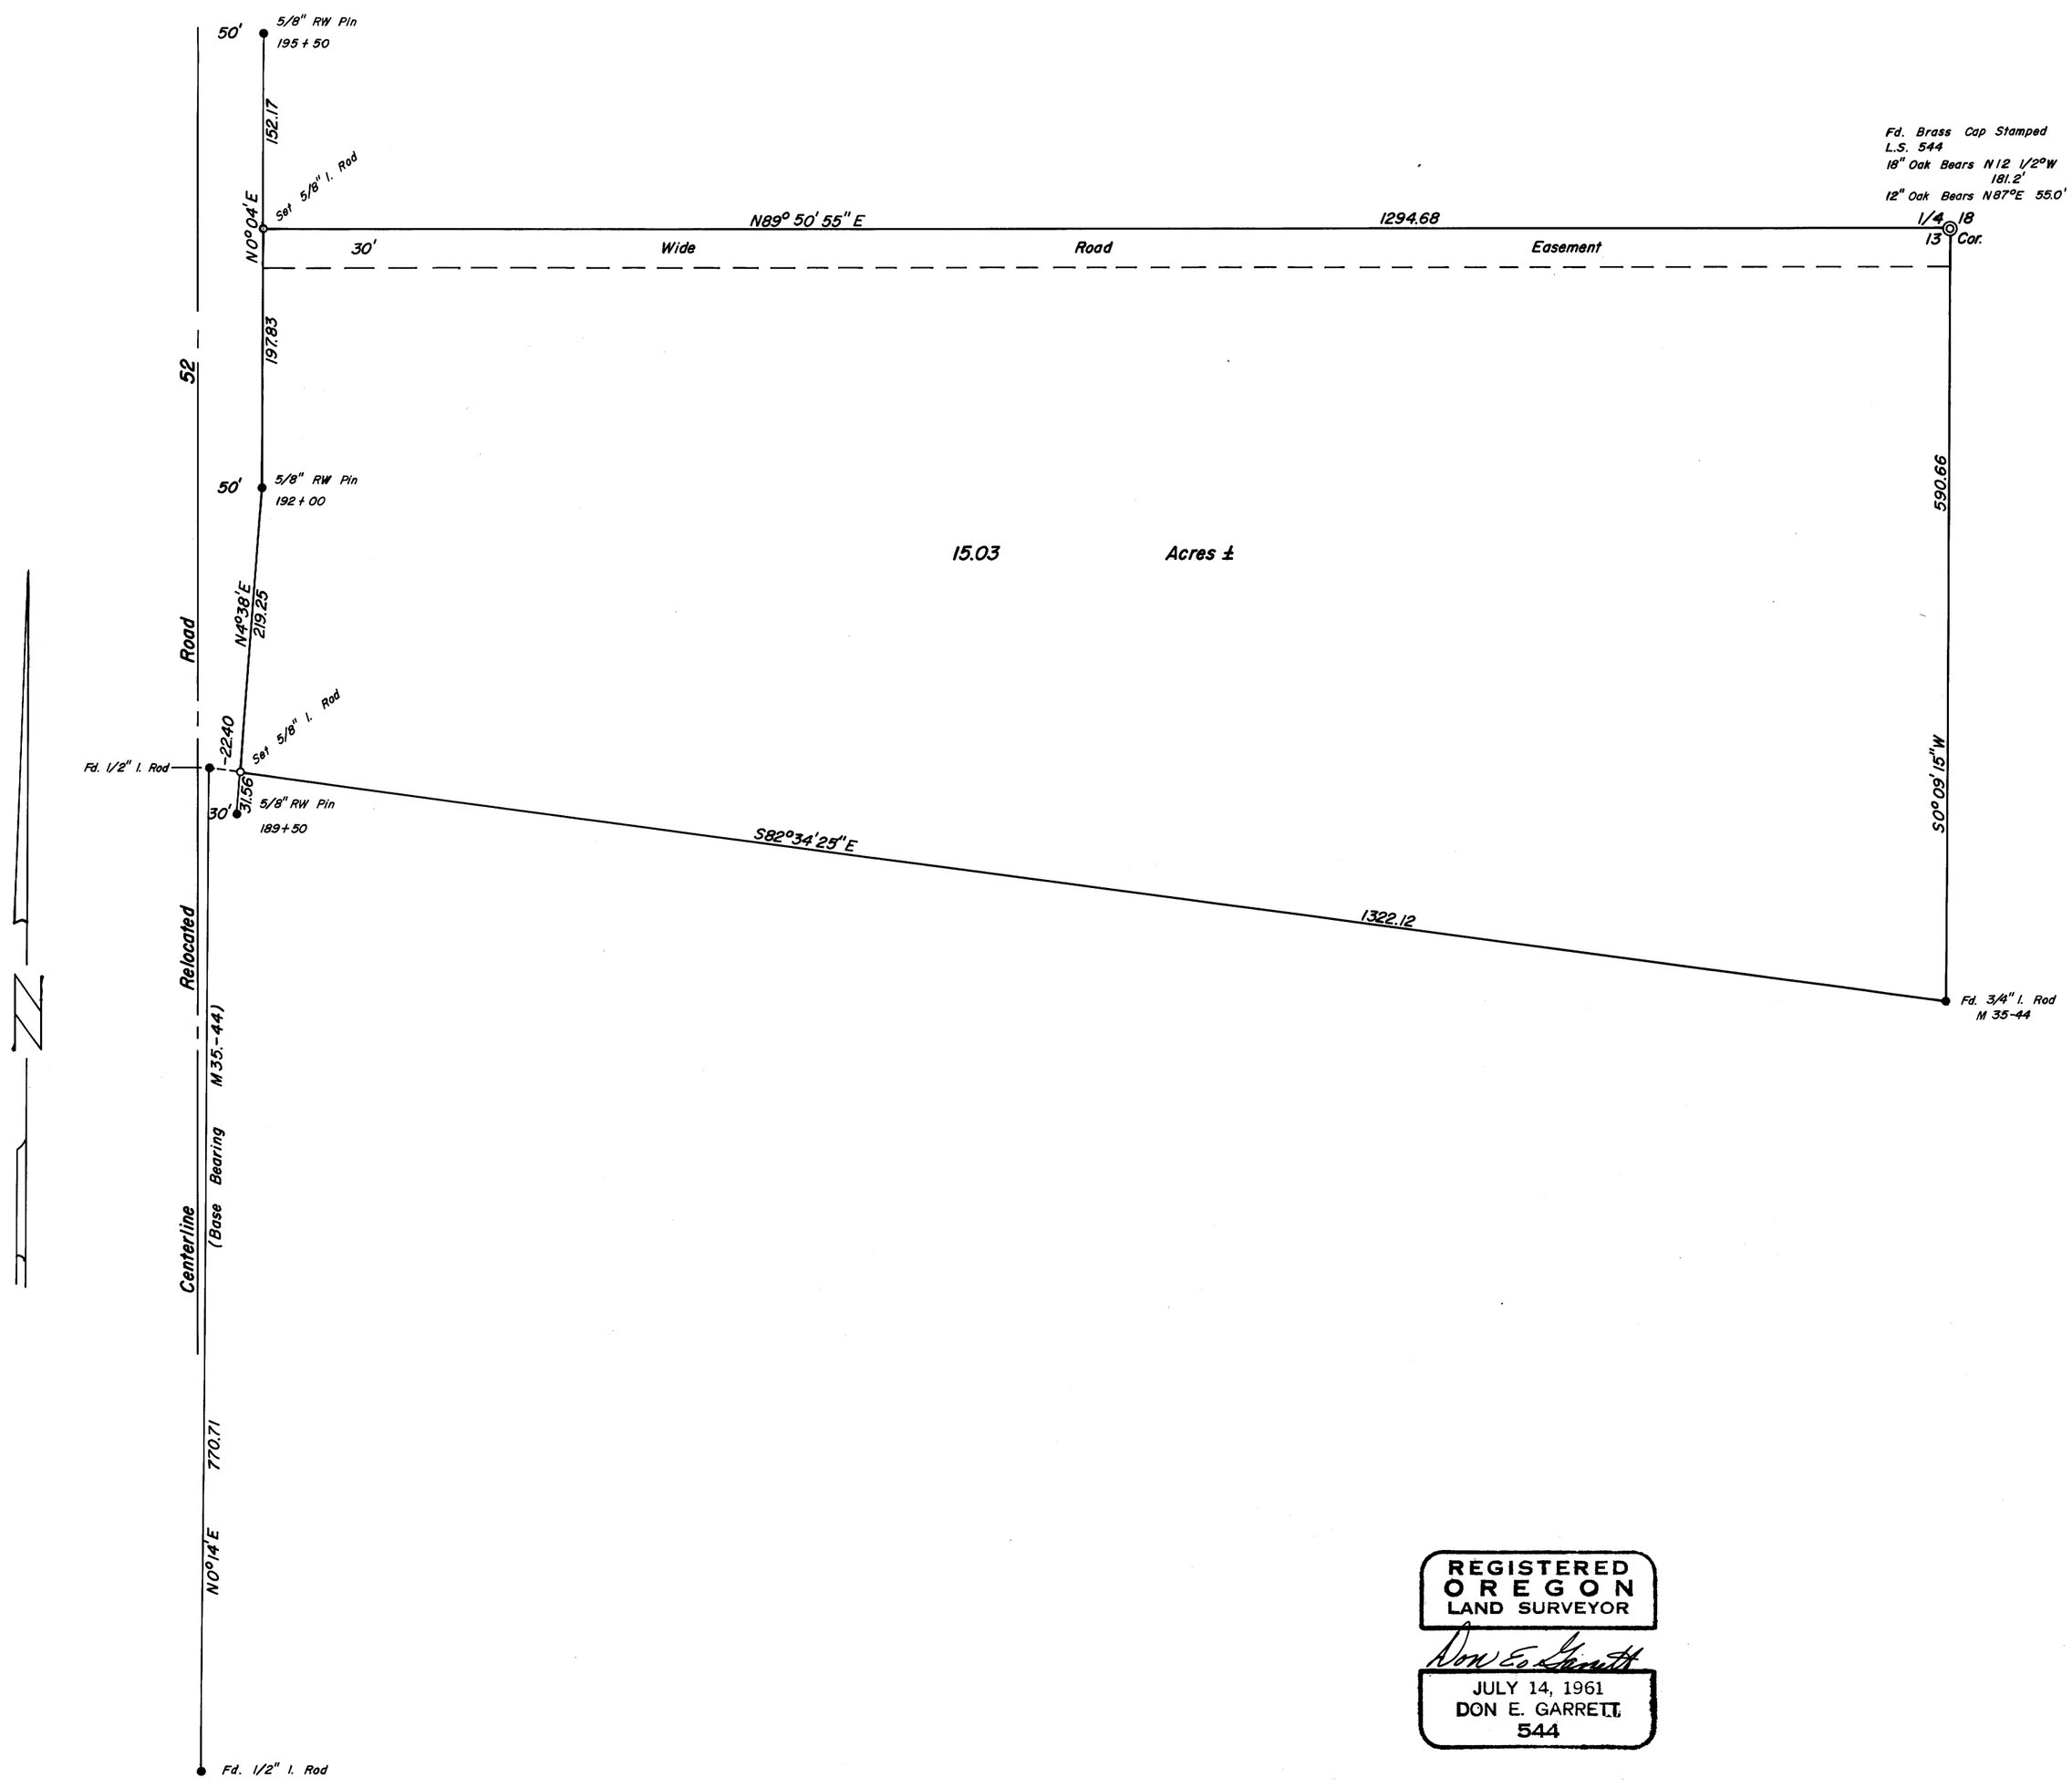

REGISTERED
OREGON
LAND SURVEYOR
Don E. Garrett
JULY 14, 1961
DON E. GARRETT
544

M 41 - 28