M #1 - 33

COUNTY SURVEYORS FILE DATA
DO NOT REMOVE FROM OFFICE

FILED
RECEIVED
MAR 26 197
COUNTY SURVEYOR
DOUGLAS COUNTY, ORE.

SURVEYED FOR PROPERTY DESCRIPTIONS

SITUATED IN SEC. 18, TWP. 22 S., RG. 9 W.W.M.

FOR ARNOLD WESSELA DEC. 1970

BY BAUGHMAN & ACKARET INC.

SCALE 1" = 100'
• SET 5/8" IRON ROD
∘ AS SHOWN

REGISTERED
OREGON
LAND SURVEYOR
JULY 14, 1961
GLENN S. BAUGHMAN
536

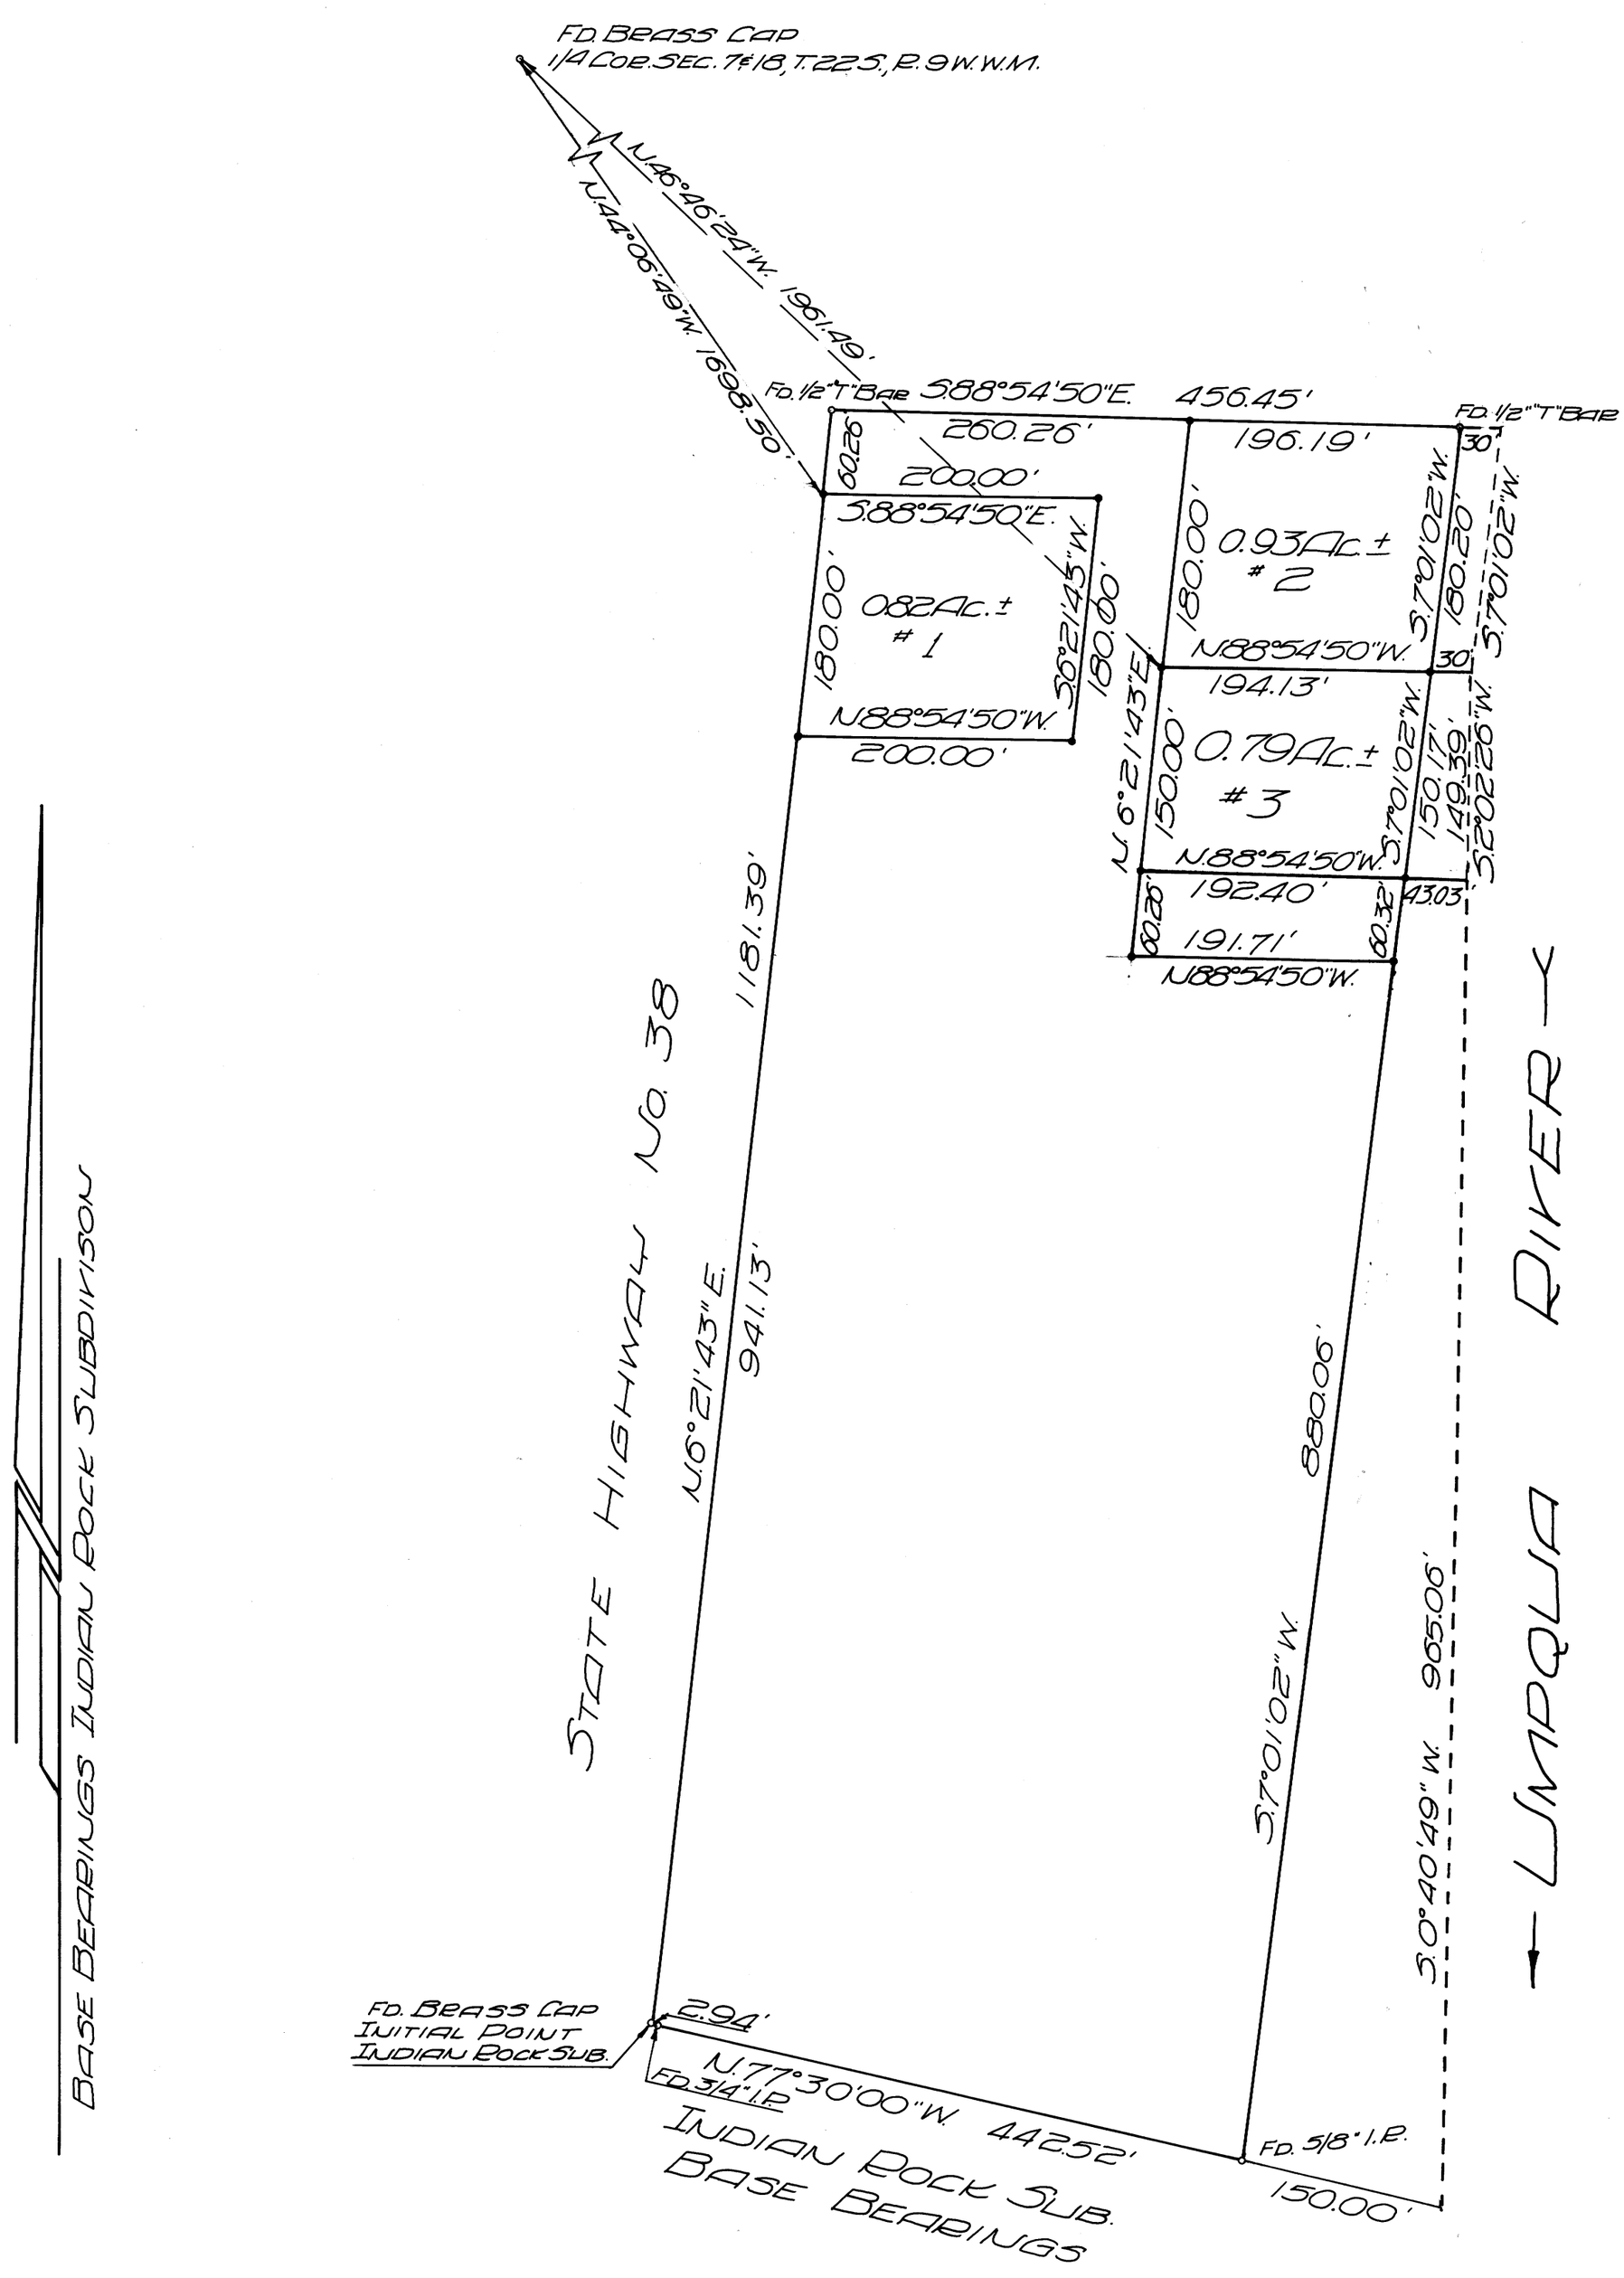

M 41 - 33