COUNTY SURVEYORS FILE DATA
DO NOT REMOVE FROM OFFICE

FILED
RECEIVED
MAR 30 1971
COUNTY SURVEYOR
DOUGLAS COUNTY, ORE.

M 41 - 35

SURVEY IN SEC. 29, T26S, R6W, W.M., DOUGLAS CO., ORE.

Surveyed for Thomas D. Piercey by Victor M. McLind

March, 1971

Scale : 1" = 200'

o — Indicates Set 5/8" I. Rod

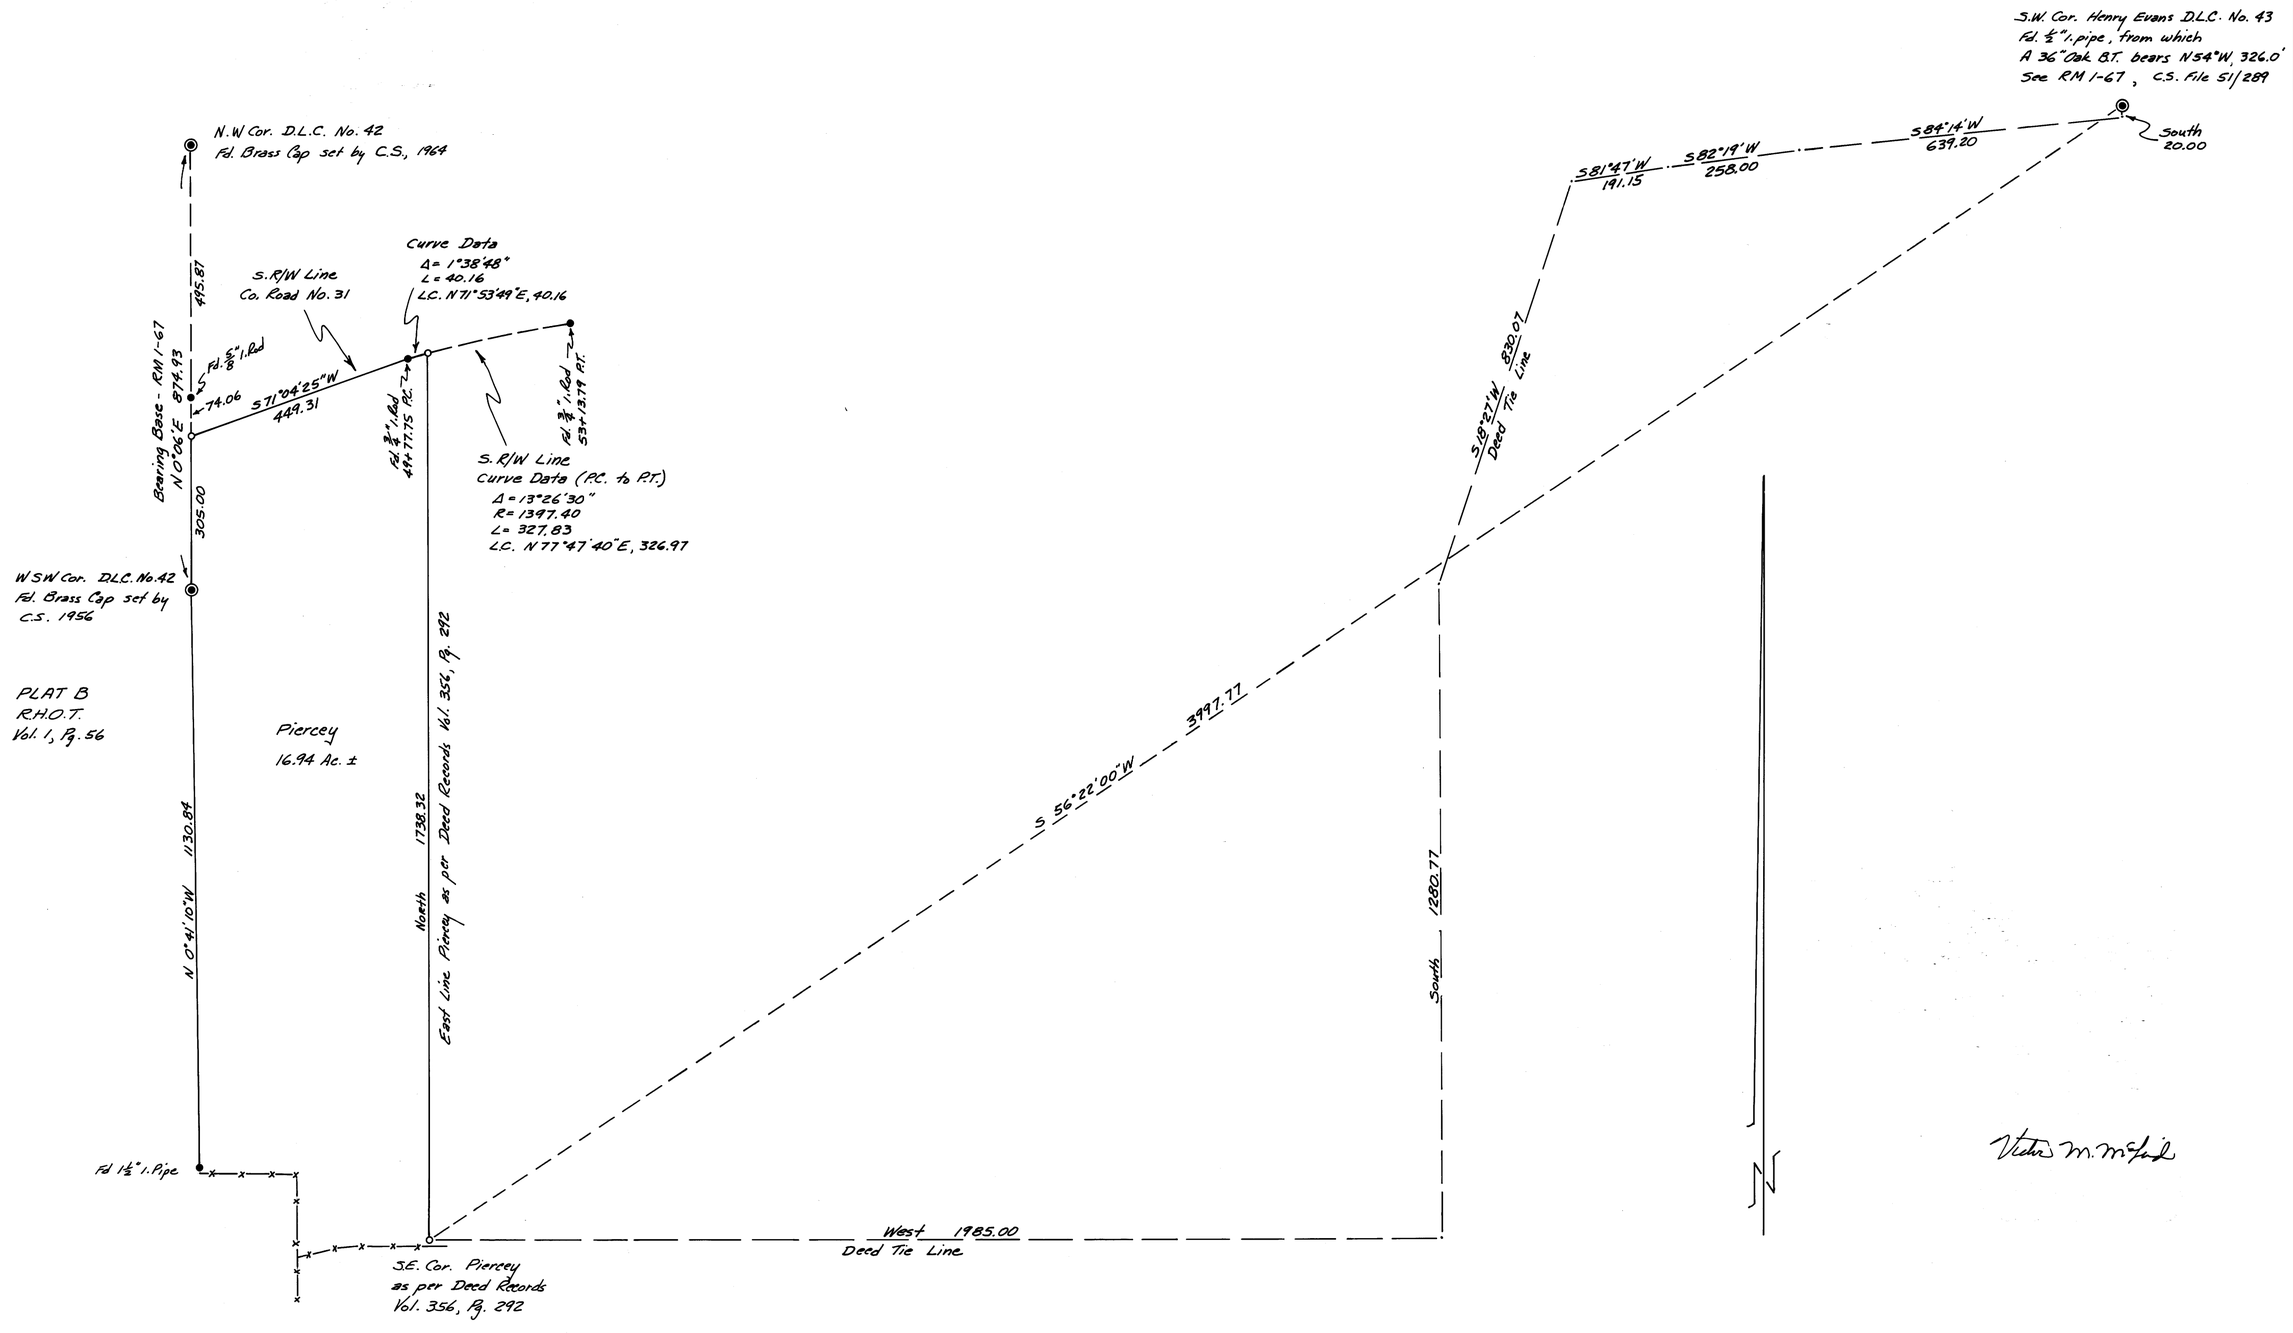

Victor M. McLind

SEE M 44-35 FOR DIV. INTO 3 TRACTS

M 41 - 35